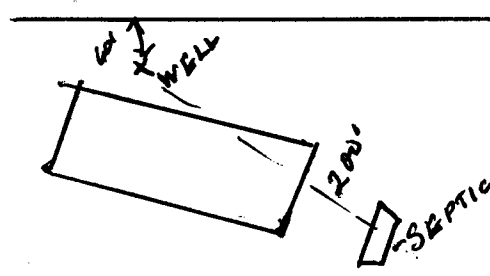


USE TYPEWRITER OR BALL POINT PEN-PRESS FIRMLY, PRINT CLEARLY.

WATER WELL RECORD
KSA 82a-1201-1215

Kansas Department of Health and Environment-Division of Environment
(Water well Contractors)
Topeka, Kansas 66620

1. Location of well:	County Dickinson	Fraction NE 1/4 NE 1/4 NE 1/4	Section number 11	Township number T 13 S	Range number R 1 E/W
2. Distance and direction from nearest town or city: Street address of well location if in city:		5 miles northwest of Abilene		3. Owner of well: R.R. or street: City, state, zip code:	
4. Locate with "X" in section below: N 1 Mile W E S 1 Mile		Sketch map: 		6. Bore hole dia. <u>8</u> in. Completion date <u>11/6/78</u> Well depth <u>60</u> ft.	
5. Type and color of material		From	To	7. <input checked="" type="checkbox"/> Cable tool <input checked="" type="checkbox"/> Rotary <input type="checkbox"/> Driven <input type="checkbox"/> Dug <input type="checkbox"/> Hollow rod <input type="checkbox"/> Jetted <input type="checkbox"/> Bored <input type="checkbox"/> Reverse rotary	
				8. Use: <input checked="" type="checkbox"/> Domestic <input type="checkbox"/> Public supply <input type="checkbox"/> Industry <input type="checkbox"/> Irrigation <input type="checkbox"/> Air conditioning <input type="checkbox"/> Stock <input type="checkbox"/> Lawn <input type="checkbox"/> Oil field water <input type="checkbox"/> Other	
				9. Casing: Material <u>plst</u> Height: Above or below surface Threaded <input type="checkbox"/> Welded <input checked="" type="checkbox"/> Surface <u>18</u> in. RMP <input checked="" type="checkbox"/> PVC <input type="checkbox"/> Weight _____ lbs./ft. Dia. <u>5</u> in. to <u>60</u> ft. depth Wall Thickness: _____ inches or Dia. _____ in. to _____ ft. depth gage No. <u>0.258</u>	
				10. Screen: Manufacturer's name <u>Western Plastics</u> Type <u>RMP</u> Dio. <u>5"</u> Slot/gauze <u>3/32</u> Length <u>24'</u> Set between <u>36</u> ft. and <u>60</u> ft. _____ ft. and _____ ft. Gravel pack? <u>Yes</u> Size range of material <u>1/16 to 3/8</u>	
				11. Static water level: <u>32</u> ft. below land surface Date <u>11/6/78</u> mo./day/yr.	
		12. Pumping level below land surfaces: _____ ft. after _____ hrs. pumping _____ g.p.m. _____ ft. after _____ hrs. pumping _____ g.p.m. Estimated maximum yield <u>25</u> g.p.m.			
		13. Water sample submitted: _____ mo./day/yr. Yes <input checked="" type="checkbox"/> No <input type="checkbox"/> Date _____			
		14. Well head completion: <input checked="" type="checkbox"/> Pitless adapter <u>18</u> inches above grade			
		15. Well grouted? <u>Yes</u> With: <input checked="" type="checkbox"/> Neat cement <input type="checkbox"/> Bentonite <input type="checkbox"/> Concrete Depth: From <u>0</u> ft. to <u>10</u> ft.			
		16. Nearest source of possible contamination: ft. <u>200'</u> Direction <u>SE</u> Type <u>septic tank</u> Well disinfected upon completion? <input checked="" type="checkbox"/> Yes <input type="checkbox"/> No			
		17. Pump: <input checked="" type="checkbox"/> Not installed Manufacturer's name _____ Model number _____ HP _____ Volts _____ Length of drop pipe _____ ft. capacity _____ g.p.m. Type: <input type="checkbox"/> Submersible <input type="checkbox"/> Turbine <input type="checkbox"/> Jet <input type="checkbox"/> Reciprocating <input type="checkbox"/> Centrifugal <input type="checkbox"/> Other			
(Use a second sheet if needed)					
18. Elevation: Topography: <input type="checkbox"/> Hill <input type="checkbox"/> Slope <input type="checkbox"/> Upland <input type="checkbox"/> Valley	19. Remarks:		20. Water well contractor's certification: This well was drilled under my jurisdiction and this report is true to the best of my knowledge and belief. <u>Rader Drilling Co.</u> <u>194</u> Business name License No. Address <u>Carlton, Kansas</u> <u>67429</u> Signed <u>Brent E Rader</u> Date <u>4-18-79</u> Authorized representative		

T 13 S R 1 E/W Sec 11 NE 1/4 NE 1/4

Forward the white, blue and pink copies to the Department of Health and Environment

Form WWC-5