


1 LOCATION OF WATER WELL: Fraction NW 1/4 NW 1/4 NE 1/4 Section Number 12 Township Number T 13 S Range Number R 1 E

Distance and direction from nearest town or city street address of well if located within city?
 6 miles South of Talmage, Kansas & 1/2 mile West

2 WATER WELL OWNER: Clarence Garten
 RR#, St. Address, Box # : Rt 4
 City, State, ZIP Code : Abilene, Kansas 67410
 Board of Agriculture, Division of Water Resources
 Application Number:

3 LOCATE WELL'S LOCATION WITH AN "X" IN SECTION BOX:

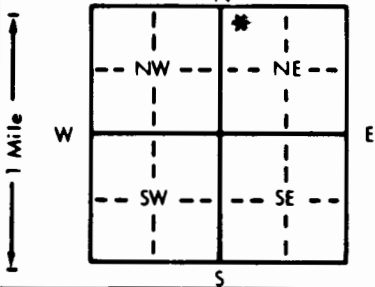

4 DEPTH OF COMPLETED WELL: 97 ft. ELEVATION:
 Depth(s) Groundwater Encountered 1. 73 ft. 2. ft. 3. ft.
 WELL'S STATIC WATER LEVEL 49 ft. below land surface measured on mo/day/yr 1/4/89
 Pump test data: Well water was ft. after hours pumping gpm
 Est. Yield 9 gpm: Well water was ft. after hours pumping gpm
 Bore Hole Diameter 9 in. to 97 ft., and in. to ft.
 WELL WATER TO BE USED AS:
 5 Public water supply 8 Air conditioning 11 Injection well
 1 Domestic 3 Feedlot 6 Oil field water supply 9 Dewatering 12 Other (Specify below)
 2 Irrigation 4 Industrial 7 Lawn and garden only 10 Monitoring well
 Was a chemical/bacteriological sample submitted to Department? Yes No *; If yes, mo/day/yr sample was submitted
 Water Well Disinfected? Yes * No

5 TYPE OF BLANK CASING USED:
 1 Steel 3 RMP (SR) 5 Wrought iron 8 Concrete tile CASING JOINTS: Glued * Clamped
 2 PVC 4 ABS 6 Asbestos-Cement 9 Other (specify below) Welded
 7 Fiberglass Threaded
 Blank casing diameter 5 in. to 97 ft., Dia in. to ft., Dia in. to ft.
 Casing height above land surface 13 in., weight 160 lbs./ft. Wall thickness or gauge No. 214

TYPE OF SCREEN OR PERFORATION MATERIAL:
 1 Steel 3 Stainless steel 5 Fiberglass 8 RMP (SR) 10 Asbestos-cement
 2 Brass 4 Galvanized steel 6 Concrete tile 9 ABS 11 Other (specify)
 12 None used (open hole)

SCREEN OR PERFORATION OPENINGS ARE:
 1 Continuous slot 3 Mill slot 5 Gauzed wrapped 8 Saw cut 11 None (open hole)
 2 Louvered shutter 4 Key punched 6 Wire wrapped 9 Drilled holes
 7 Torch cut 10 Other (specify)

SCREEN-PERFORATED INTERVALS: From 49 ft. to 97 ft. From ft. to ft.
 GRAVEL PACK INTERVALS: From 25 ft. to 97 ft. From ft. to ft.

6 GROUT MATERIAL: 1 Neat cement 2 Cement grout 3 Bentonite 4 Other
 Grout Intervals: From 3 ft. to 25 ft. From ft. to ft. From ft. to ft.

What is the nearest source of possible contamination:
 1 Septic tank 4 Lateral lines 7 Pit privy 10 Livestock pens 14 Abandoned water well
 2 Sewer lines 5 Cess pool 8 Sewage lagoon 11 Fuel storage 15 Oil well/Gas well
 3 Watertight sewer lines 6 Seepage pit 9 Feedyard 12 Fertilizer storage 16 Other (specify below)
 13 Insecticide storage
 Direction from well? NORTHEAST How many feet? APPROX 90

FROM	TO	LITHOLOGIC LOG	FROM	TO	PLUGGING INTERVALS
0	11	BROWN SANDY CLAY			
11	25	LITE COLOR CLAY & SHALE			
25	26	SOFT LIMESTONE			
26	31	RED CLAY & SHALE			
31	50	LITE COLOR CLAY & SHALE			
50	51	SOFT LIMESTONE			
51	56	LITE COLOR SHALE			
56	62	LITE GRAY CLAY & SHALE			
62	73	RED SHALE			
73	83	LITE COLOR SHALE			
83	91	GRAY CLAY SHALE			
91	94	DARK LIMESTONE			
94	97	BLUE CLAY			

7 CONTRACTOR'S OR LANDOWNER'S CERTIFICATION: This water well was (1) constructed, (2) reconstructed, or (3) plugged under my jurisdiction and was completed on (mo/day/year) 1/4/89 and this record is true to the best of my knowledge and belief. Kansas Water Well Contractor's License No. 397 This Water Well Record was completed on (mo/day/yr) 2/23/89 under the business name of CENTRAL KANSAS DRILLING by (signature) Harold D. Martin

INSTRUCTIONS: Use typewriter or ball point pen. PLEASE PRESS FIRMLY and PRINT clearly. Please fill in blanks, underline or circle the correct answers. Send top three copies to Kansas Department of Health and Environment, Bureau of Water Protection, Topeka, Kansas 66620-7320. Telephone: 913-296-5514. Send one to WATER WELL OWNER and retain one for your records.

28-880000015