


1 LOCATION OF WATER WELL: Fraction SW 1/4 SE 1/4 NW 1/4 Section Number 12 Township Number T 13 S Range Number R 1 E

Distance and direction from nearest town or city street address of well if located within city?
5 miles East of Solomon, Ks & 1 1/2 miles North & 1/4 mile East

2 WATER WELL OWNER: John Seastrom
 RR#, St. Address, Box #: Rt 4 Board of Agriculture, Division of Water Resources
 City, State, ZIP Code: Abilene, Kansas 67410 Application Number:

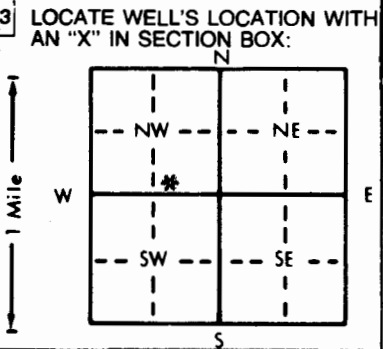

4 DEPTH OF COMPLETED WELL: 72 ft. ELEVATION:
 Depth(s) Groundwater Encountered 1. 55 ft. 2. ft. 3. ft.
 WELL'S STATIC WATER LEVEL 47 ft. below land surface measured on mo/day/yr 8 / 2 / 90
 Pump test data: Well water was ft. after hours pumping gpm
 Est. Yield 20+ gpm: Well water was ft. after hours pumping gpm
 Bore Hole Diameter 9 in. to 72 ft., and in. to ft.
 WELL WATER TO BE USED AS:
 5 Public water supply 8 Air conditioning 11 Injection well
 1 Domestic 3 Feedlot 6 Oil field water supply 9 Dewatering 12 Other (Specify below)
 2 Irrigation 4 Industrial 7 Lawn and garden only 10 Monitoring well
 Was a chemical/bacteriological sample submitted to Department? Yes.....No *.....; If yes, mo/day/yr sample was submitted
 Water Well Disinfected? Yes * No

5 TYPE OF BLANK CASING USED:
 1 Steel 3 RMP (SR) 5 Wrought iron 8 Concrete tile CASING JOINTS: Glued * Clamped
 2 PVC 4 ABS 6 Asbestos-Cement 9 Other (specify below) Welded
 7 Fiberglass Threaded.....
 Blank casing diameter 5 in. to 72 ft., Dia in. to ft., Dia in. to ft.
 Casing height above land surface 16 in., weight 160 lbs./ft. Wall thickness or gauge No. 214
 TYPE OF SCREEN OR PERFORATION MATERIAL:
 1 Steel 3 Stainless steel 5 Fiberglass 7 PVC 10 Asbestos-cement
 2 Brass 4 Galvanized steel 6 Concrete tile 8 RMP (SR) 11 Other (specify)
 9 ABS 12 None used (open hole)
 SCREEN OR PERFORATION OPENINGS ARE:
 1 Continuous slot 3 Mill slot 5 Gauzed wrapped 8 Saw cut 11 None (open hole)
 2 Louvered shutter 4 Key punched 6 Wire wrapped 9 Drilled holes
 7 Torch cut 10 Other (specify)
 SCREEN-PERFORATED INTERVALS: From 50 ft. to 72 ft., From ft. to ft.
 From ft. to ft., From ft. to ft.
 GRAVEL PACK INTERVALS: From 25 ft. to 72 ft., From ft. to ft.
 From ft. to ft., From ft. to ft.

6 GROUT MATERIAL: 1 Neat cement 2 Cement grout 3 Bentonite 4 Other
 Grout Intervals: From 5 ft. to 25 ft., From ft. to ft., From ft. to ft.
 What is the nearest source of possible contamination:
 1 Septic tank 4 Lateral lines 7 Pit privy 10 Livestock pens 14 Abandoned water well
 2 Sewer lines 5 Cess pool 8 Sewage lagoon 11 Fuel storage 15 Oil well/Gas well
 3 Watertight sewer lines 6 Seepage pit 9 Feedyard 12 Fertilizer storage 16 Other (specify below)
 13 Insecticide storage
 Direction from well? SOUTHWEST How many feet? 140

FROM	TO	LITHOLOGIC LOG	FROM	TO	PLUGGING INTERVALS
0	11	BROWN SANDY CLAY			
11	32	LITE COLOR CLAY & SHALE			
32	55	LITE COLOR SHALE			
55	58	SOFT LITE COLOR SHALEY CLAY			
58	61	LIMESTONE			
61	67	LITE COLOR SHALE			
67	72	GRAY CLAY & SHALE			

7 CONTRACTOR'S OR LANDOWNER'S CERTIFICATION: This water well was (1) constructed, (2) reconstructed, or (3) plugged under my jurisdiction and was completed on (mo/day/year) 8 / 2 / 90 and this record is true to the best of my knowledge and belief. Kansas Water Well Contractor's License No. 397 This Water Well Record was completed on (mo/day/yr) 9 / 18 / 90 under the business name of CENTRAL KANSAS DRILLING by (signature) Harold D. Masten

800921008-22