


1 LOCATION OF WATER WELL: County: Dickinson Fraction: SW 1/4 NW 1/4 SW 1/4 Section Number: 12 Township Number: T 13 S Range Number: R 1 E

Distance and direction from nearest town or city street address of well if located within city?  
3 miles west and 1 1/2 north of Abilene

2 WATER WELL OWNER: Trent Taylor  
 RR#, St. Address, Box #: 501 North Brady Lot 16 Board of Agriculture, Division of Water Resources  
 City, State, ZIP Code: Abilene, Ks. 67410 Application Number:

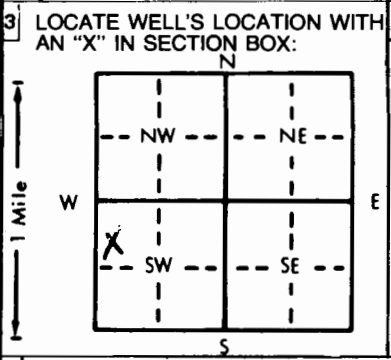

4 DEPTH OF COMPLETED WELL: 46 ft. ELEVATION:  
 Depth(s) Groundwater Encountered 1. 38 ft. 2. ft. 3. ft.  
 WELL'S STATIC WATER LEVEL 19 ft. below land surface measured on mo/day/yr 6/1/82  
 Pump test data: Well water was ft. after hours pumping gpm  
 Est. Yield 24 gpm: Well water was ft. after hours pumping gpm  
 Bore Hole Diameter: 9 in. to 46 ft., and in. to ft.  
 WELL WATER TO BE USED AS:  
 5 Public water supply 8 Air conditioning 11 Injection well  
 1 Domestic 3 Feedlot 6 Oil field water supply 9 Dewatering 12 Other (Specify below)  
 2 Irrigation 4 Industrial 7 Lawn and garden only 10 Observation well  
 Was a chemical/bacteriological sample submitted to Department? Yes No ; If yes, mo/day/yr sample was submitted  
 Water Well Disinfected? Yes  No

5 TYPE OF BLANK CASING USED:  
 1 Steel 3 RMP (SR) 5 Wrought iron 8 Concrete tile CASING JOINTS: Glued Clamped  
 2 PVC 4 ABS 6 Asbestos-Cement 9 Other (specify below) Welded  
 7 Fiberglass Threaded  
 Blank casing diameter 5 in. to 4 1/2 ft., Dia. in. to ft., Dia. in. to ft.  
 Casing height above land surface 16 ft. weight 160 lbs./ft. Wall thickness or gauge No. 0.258  
 TYPE OF SCREEN OR PERFORATION MATERIAL:  
 1 Steel 3 Stainless steel 5 Fiberglass 7 PVC 10 Asbestos-cement  
 2 Brass 4 Galvanized steel 6 Concrete tile 8 RMP (SR) 11 Other (specify)  
 9 ABS 12 None used (open hole)  
 SCREEN OR PERFORATION OPENINGS ARE:  
 5 Gauzed wrapped 8 Saw cut 11 None (open hole)  
 1 Continuous slot 3 Mill slot 6 Wire wrapped 9 Drilled holes  
 2 Louvered shutter 4 Key punched 7 Torch cut 10 Other (specify)  
 SCREEN-PERFORATED INTERVALS: From 20 ft. to 46 ft., From ft. to ft.  
 From ft. to ft., From ft. to ft.  
 GRAVEL PACK INTERVALS: From 14 ft. to 46 ft., From ft. to ft.  
 From ft. to ft., From ft. to ft.

6 GROUT MATERIAL: 1 Neat cement 2 Cement grout 3 Bentonite 4 Other  
 Grout Intervals: From 4 ft. to 14 ft., From ft. to ft., From ft. to ft.  
 What is the nearest source of possible contamination:  
 1 Septic tank 4 Lateral lines 7 Pit privy 10 Livestock pens 14 Abandoned water well  
 2 Sewer lines 5 Cess pool 8 Sewage lagoon 11 Fuel storage 15 Oil well/Gas well  
 3 Watertight sewer lines 6 Seepage pit 9 Feedyard 12 Fertilizer storage 16 Other (specify below)  
 13 Insecticide storage  
 Direction from well? North east How many feet? 1,200

FROM	TO	LITHOLOGIC LOG	FROM	TO	LITHOLOGIC LOG
0	1	Clay			
1	6	Clay and shale mixed			
6	9	Limestone			
9	17	Shale			
17	25	Limestone			
25	36	Yellow clay			
36	38	Limestone			
38	39	Hollow cavity			
39	46	Gray clay and shale			

7 CONTRACTOR'S OR LANDOWNER'S CERTIFICATION: This water well was (1) constructed (2) reconstructed, or (3) plugged under my jurisdiction and was completed on (mo/day/year) 6/1/82 and this record is true to the best of my knowledge and belief. Kansas Water Well Contractor's License No. 397 This Water Well Record was completed on (mo/day/yr) 6/1/82 under the business name of CENTRAL KANSAS DRILLING by (signature) Charles D. Martin

INSTRUCTIONS: Use typewriter or ball point pen, PLEASE PRESS FIRMLY and PRINT clearly. Please fill in blanks, underline or circle the correct answers. Send top three copies to Kansas Department of Health and Environment, Division of Environment, Environmental Geology Section, Topeka, KS 66620. Send one to WATER WELL OWNER and retain one for your records.

OFFICE USE ONLY  
T  
R  
SEC.  
SW 1/4 NW 1/4 SW 1/4