USE TYPEWRITER OR BALL POINT PEN-PRESS FIRMLY, PRINT CLEARLY.

WATER WELL RECORD
KSA 82a-1201-1215

Kansas Department of Health and Environment-Division of Environment
(Water well Contractors)
Topeko, Kansas 66620

1. Location of well:	County	Fraction	Section number	Township number	Range number
	Dickinson	NW 1/4 SE 1/4 SW 1/4	17	T 13 S	R 1 E/W

2. Distance and direction from nearest town or city: 1 mile east of Solomon
Street address of well location if in city:

3. Owner of well: Charles Clemence
R.R. or street: R.R. # 1
City, state, zip code: Solomon, Kansas

4. Locate with "X" in section below:

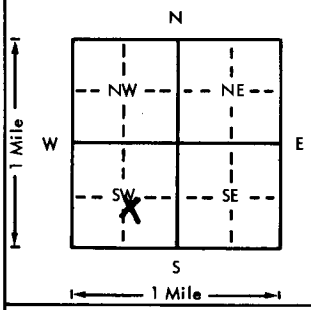

Sketch map:

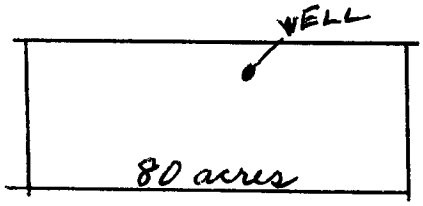

6. Bore hole dia. 8 in. Completion date
Well depth 46 ft. 9/15/77

7. __ Cable tool X Rotory __ Driven __ Dug
__ Hollow rod __ Jetted __ Bored __ Reverse rotary

8. Use: __ Domestic __ Public supply __ Industry
__ Irrigation __ Air conditioning X Stock
__ Lawn __ Oil field water __ Other

9. Casing: Material plst Height: Above ~~open~~
Threaded __ Welded gl Surface 18 in.
RMP X PVC __ Weight __ lbs./ft.
Dia. 5 in. to 46 ft. depth Wall Thickness: inches or
Dia. __ in. to __ ft. depth gage No. 0.258

5. Type and color of material	From	To
Hard clay	0	28
Hollow rock	28	35
Blue	35	46
(Use a second sheet if needed)		

10. Screen: Manufacturer's name Western Plastics
Type RMP Dia. 5"
Slot/gouze 3/32 Length 20'
Set between 26 ft. and 46 ft.
ft. and ft.
Gravel pack? yes Size range of material: 1/16 to 3/8

11. Static water level: mo./day/yr.
27 ft. below land surface Date 9/15/77

12. Pumping level below land surfaces:
ft. after hrs. pumping g.p.m.
ft. after hrs. pumping g.p.m.
Estimated maximum yield 30+ g.p.m.

13. Water sample submitted: mo./day/yr.
__ Yes X No Date

14. Well head completion:
__ Pitless adopter 18 Inches above grade

15. Well grouted? yes
With: X Neat cement __ Bentonite __ Concrete
Depth: From 0 ft. to 10 ft.

X Nearest source of possible contomination:
ft. 74 m Direction SW Type septic
Well disinfected upon completion? __ Yes __ No

17. Pump: X Nat installed
Manufacturer's name
Model number HP Volts
Length of drop pipe ft. capacity g.p.m.
Type:
__ Submersible __ Turbine
__ Jet __ Reciprocating
__ Centrifugal __ Other

18. Elevation:

Topography:
__ Hill
__ Slope
__ Upland
__ Valley

19. Remarks:

20. Water well contractor's certificotion:
This well wos drilled under my jurisdiction and this report is true to the best of my knowledge and belief.
Rader Drilling Co. 194
Business name License No.
Address Carlton, Kansas
Signed Brant E Rader Date 10-26-77
Authorized representative

T 13 R 1 E/W Sec 17 1/4 1/4 1/4 NW SE SW

Forward the white, blue and pink copies to the Department of Health and Environment

Form WWC-5

MI-1023