


1 LOCATION OF WATER WELL: Fraction SE Section Number 21 Township Number T 13 S Range Number R 1 E/W  
 County Dickinson NE 1/4 NE 1/4 NE 1/4

Distance and direction from nearest town or city street address of well if located within city?  
3 miles East of Salaman on 40 Hwy & 1/2 North

2 WATER WELL OWNER: Bob Webb  
 RR#, St. Address, Box #: Rt 1, Box 362 Board of Agriculture, Division of Water Resources  
 City, State, ZIP Code: Salaman, Kansas 67180 Application Number:

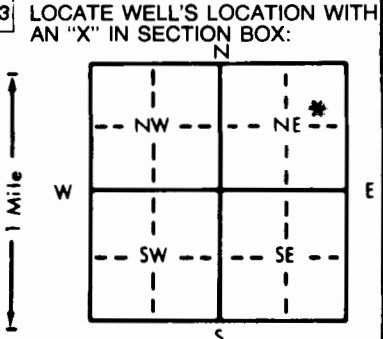

4 DEPTH OF COMPLETED WELL: 92 ft. ELEVATION:  
 Depth(s) Groundwater Encountered 1. 67 ft. 2. ft. 3. ft.  
 WELL'S STATIC WATER LEVEL 46 ft. below land surface measured on mo/day/yr 8/3/87  
 Pump test data: Well water was ft. after hours pumping gpm  
 Est. Yield 22 gpm: Well water was ft. after hours pumping gpm  
 Bore Hole Diameter: 9 in. to 92 ft., and in. to ft.  
 WELL WATER TO BE USED AS:  
 5 Public water supply 8 Air conditioning 11 Injection well  
 1 Domestic 3 Feedlot 6 Oil field water supply 9 Dewatering 12 Other (Specify below)  
 2 Irrigation 4 Industrial 7 Lawn and garden only 10 Observation well  
 Was a chemical/bacteriological sample submitted to Department? Yes.....No \*; If yes, mo/day/yr sample was submitted  
 Water Well Disinfected? Yes \* No

5 TYPE OF BLANK CASING USED:  
 1 Steel 3 RMP (SR) 5 Wrought iron 8 Concrete tile CASING JOINTS: Glued \* Clamped  
 2 PVC 4 ABS 6 Asbestos-Cement 9 Other (specify below) Welded  
 7 Fiberglass Threaded  
 Blank casing diameter 5 in. to 92 ft., Dia in. to ft., Dia in. to ft.  
 Casing height above land surface 18 in., weight 160 lbs./ft. Wall thickness or gauge No. 21 1/2  
 TYPE OF SCREEN OR PERFORATION MATERIAL:  
 1 Steel 3 Stainless steel 5 Fiberglass 7 PVC 10 Asbestos-cement  
 2 Brass 4 Galvanized steel 6 Concrete tile 8 RMP (SR) 11 Other (specify)  
 9 ABS 12 None used (open hole)  
 SCREEN OR PERFORATION OPENINGS ARE:  
 1 Continuous slot 3 Mill slot 5 Gauzed wrapped 8 Saw cut 11 None (open hole)  
 2 Louvered shutter 4 Key punched 6 Wire wrapped 9 Drilled holes  
 7 Torch cut 10 Other (specify)  
 SCREEN-PERFORATED INTERVALS: From 72 ft. to 92 ft., From ft. to ft.  
 From ft. to ft., From ft. to ft.  
 GRAVEL PACK INTERVALS: From 24 ft. to 92 ft., From ft. to ft.  
 From ft. to ft., From ft. to ft.

6 GROUT MATERIAL: 1 Neat cement 2 Cement grout 3 Bentonite 4 Other  
 Grout intervals: From 3 ft. to 24 ft., From ft. to ft., From ft. to ft.  
 What is the nearest source of possible contamination:  
 1 Septic tank 4 Lateral lines 7 Pit privy 10 Livestock pens 14 Abandoned water well  
 2 Sewer lines 5 Cess pool 8 Sewage lagoon 11 Fuel storage 15 Oil well/Gas well  
 3 Watertight sewer lines 6 Seepage pit 9 Feedyard 12 Fertilizer storage 16 Other (specify below)  
 13 Insecticide storage  
 Direction from well? SOUTH How many feet? 150

FROM	TO	LITHOLOGIC LOG	FROM	TO	LITHOLOGIC LOG
0	13	FINE SAND			
13	16	DARK CLAY			
16	18	BROWN CLAY			
18	28	FINE SAND			
28	29	BROWN CLAY			
29	33	FINE SAND			
33	38	SANDY CLAY			
38	67	FINE SAND			
67	78	SAND			
78	79	CLAY			
79	81	LITE COLOR SHALE			
81	87	LIMESTONE			
87	92	GRAY SHALE			

7 CONTRACTOR'S OR LANDOWNER'S CERTIFICATION: This water well was (1) constructed, (2) reconstructed, or (3) plugged under my jurisdiction and was completed on (mo/day/year) 8/3/87 and this record is true to the best of my knowledge and belief. Kansas Water Well Contractor's License No. 397 This Water Well Record was completed on (mo/day/yr) 8/21/87 under the business name of CENTRAL KANSAS DRILLING by (signature) Harold D. Martin

INSTRUCTIONS: Use typewriter or ball point pen. PLEASE PRESS FIRMLY and PRINT clearly. Please fill in blanks, underline or circle the correct answers. Send top three copies to Kansas Department of Health and Environment, Bureau of Water Protection, Topeka, Kansas 66620-7320, Telephone: 913-862-9360. Send one to WATER WELL OWNER and retain one for your records.

1920000078-50