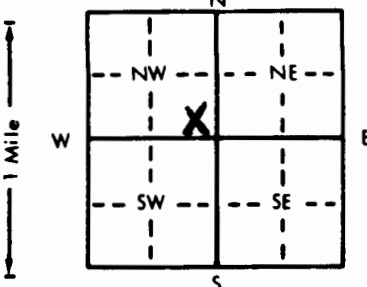


1 LOCATION OF WATER WELL: County: Dickenson Fraction Se 1/4 Se 1/4 NW 1/4 Section Number 21 Township Number T 13 S Range Number R 1 E

Distance and direction from nearest town or city street address of well if located within city?  
2 SE Solomon on Old 40 Hwy

2 WATER WELL OWNER: Charles L. Dunbar  
 RR#, St. Address, Box #: PR1 Box 1A7A Board of Agriculture, Division of Water Resources  
 City, State, ZIP Code: Solomon, KS, 67480 Application Number:

3 LOCATE WELL'S LOCATION WITH AN "X" IN SECTION BOX:  
  
 4 DEPTH OF COMPLETED WELL: 46 ft. ELEVATION:  
 Depth(s) Groundwater Encountered 1. 32 ft. 2. . ft. 3. . ft.  
 WELL'S STATIC WATER LEVEL 17 ft. below land surface measured on mo/day/yr 2-13-92  
 Pump test data: Well water was . ft. after . hours pumping . gpm  
 Est. Yield 20 gpm: Well water was . ft. after . hours pumping . gpm  
 Bore Hole Diameter 4 in. to 46 ft., and . in. to . ft.  
 WELL WATER TO BE USED AS:  
 Domestic 3 Feedlot 6 Oil field water supply 9 Dewatering 11 Injection well  
 Irrigation 4 Industrial 7 Lawn and garden only 10 Monitoring well  
 Was a chemical/bacteriological sample submitted to Department? Yes. . No. ; If yes, mo/day/yr sample was submitted  
 Water Well Disinfected? Yes  No

5 TYPE OF BLANK CASING USED:  
 1 Steel 3 RMP (SR) 5 Wrought iron 8 Concrete tile CASING JOINTS: Glued  Clamped .  
2 PVC 4 ABS 6 Asbestos-Cement 9 Other (specify below) Welded .  
 7 Fiberglass Threaded .  
 Blank casing diameter 5 in. to 32 ft., Dia . in. to . ft., Dia . in. to . ft.  
 Casing height above land surface 12 in., weight CLASS 160 lbs./ft. Wall thickness or gauge No. 219  
 TYPE OF SCREEN OR PERFORATION MATERIAL:  
 1 Steel 3 Stainless steel 5 Fiberglass 8 RMP (SR) 10 Asbestos-cement  
 2 Brass 4 Galvanized steel 6 Concrete tile 9 ABS 11 Other (specify) .  
 12 None used (open hole)  
 SCREEN OR PERFORATION OPENINGS ARE:  
 1 Continuous slot 3 Mill slot 5 Gauzed wrapped 8 Saw cut 11 None (open hole)  
 2 Louvered shutter 4 Key punched 6 Wire wrapped 9 Drilled holes  
 7 Torch cut 10 Other (specify) .  
 SCREEN-PERFORATED INTERVALS: From 32 ft. to 46 ft., From . ft. to . ft.  
 From . ft. to . ft., From . ft. to . ft.  
 GRAVEL PACK INTERVALS: From 21 ft. to 46 ft., From . ft. to . ft.  
 From . ft. to . ft., From . ft. to . ft.

6 GROUT MATERIAL: 1 Neat cement 2 Cement grout 3 Bentonite 4 Other .  
 Grout Intervals: From 0 ft. to 21 ft., From . ft. to . ft., From . ft. to . ft.  
 What is the nearest source of possible contamination:  
 1 Septic tank 4 Lateral lines 7 Pit privy 11 Fuel storage 14 Abandoned water well  
 2 Sewer lines 5 Cess pool 8 Sewage lagoon 12 Fertilizer storage 15 Oil well/Gas well  
 3 Watertight sewer lines 6 Seepage pit 9 Feedyard 13 Insecticide storage 16 Other (specify below)  
 Direction from well? S How many feet? 52

FROM	TO	LITHOLOGIC LOG	FROM	TO	PLUGGING INTERVALS
0	32	Clay			
32	41	medium sand			
41	46	Blue Shale			

7 CONTRACTOR'S OR LANDOWNER'S CERTIFICATION: This water well was (1) constructed, (2) reconstructed, or (3) plugged under my jurisdiction and was completed on (mo/day/year) 2-13-92 and this record is true to the best of my knowledge and belief. Kansas Water Well Contractor's License No. 780 This Water Well Record was completed on (mo/day/yr) 2-13-92 under the business name of Backhus Drilling by (signature) Paul H. Backhus