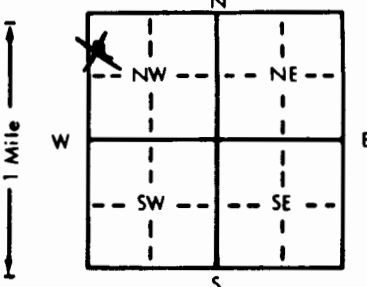


1 LOCATION OF WATER WELL: County: Dickinson Fraction NW 1/4 NW 1/4 NW 1/4 Section Number 23 Township Number T 13 S Range Number R 1 E

Distance and direction from nearest town or city street address of well if located within city?  
4 miles East of Solomon, KS  
 2 WATER WELL OWNER: City of Abilene Board of Agriculture, Division of Water Resources  
 RR#, St. Address, Box # : 2nd & Walnut Application Number: 38,952 redrill  
 City, State, ZIP Code : Abilene, KS 67410

3 LOCATE WELL'S LOCATION WITH AN "X" IN SECTION BOX:  
  
 4 DEPTH OF COMPLETED WELL: 93 ft. ELEVATION: ..... ft.  
 Depth(s) Groundwater Encountered 1. 7.8 ft. 2. .... ft. 3. .... ft.  
 WELL'S STATIC WATER LEVEL 7.8 ft. below land surface measured on mo/day/yr 5-5-92  
 Pump test data: Well water was ..... ft. after ..... hours pumping ..... gpm  
 Est. Yield 400 gpm: Well water was ..... ft. after ..... hours pumping ..... gpm  
 Bore Hole Diameter 3.0 in. to 8.8 ft., and 1.1 in. to 9.3 ft.  
 WELL WATER TO BE USED AS: 5 Public water supply 8 Air conditioning 11 Injection well  
 1 Domestic 3 Feedlot 6 Oil field water supply 9 Dewatering 12 Other (Specify below)  
 2 Irrigation 4 Industrial 7 Lawn and garden only 10 Monitoring well .....  
 Was a chemical/bacteriological sample submitted to Department? Yes.....No...X.....; If yes, mo/day/yr sample was submitted  
 Water Well Disinfected? Yes X No

5 TYPE OF BLANK CASING USED:  
 1 Steel 3 RMP (SR) 5 Wrought iron 8 Concrete tile CASING JOINTS: Glued X Clamped .....  
 2 PVC 4 ABS 6 Asbestos-Cement 9 Other (specify below) Welded .....  
 7 Fiberglass Threaded .....  
 Blank casing diameter 1.6 in. to 8.8 ft., Dia ..... in. to ..... ft., Dia ..... in. to ..... ft.  
 Casing height above land surface 1.2 in., weight 1.6 lbs./ft. Wall thickness or gauge No. 500  
 TYPE OF SCREEN OR PERFORATION MATERIAL: None 7 PVC 10 Asbestos-cement  
 1 Steel 3 Stainless steel 5 Fiberglass 8 RMP (SR) 11 Other (specify) .....  
 2 Brass 4 Galvanized steel 6 Concrete tile 9 ABS 12 None used (open hole)  
 SCREEN OR PERFORATION OPENINGS ARE:  
 1 Continuous slot 3 Mill slot 5 Gauzed wrapped 8 Saw cut 11 None (open hole)  
 2 Louvered shutter 4 Key punched 6 Wire wrapped 9 Drilled holes  
 7 Torch cut 10 Other (specify) .....  
 SCREEN-PERFORATED INTERVALS: From N/A ft. to ..... ft., From ..... ft. to ..... ft.  
 From ..... ft. to ..... ft., From ..... ft. to ..... ft.  
 GRAVEL PACK INTERVALS: From 2.5 ft. to 8.0 ft., From ..... ft. to ..... ft.  
 From ..... ft. to ..... ft., From ..... ft. to ..... ft.

6 GROUT MATERIAL: 1 Neat cement 2 Cement grout 3 Bentonite 4 Other .....  
 Grout intervals: From 5 ft. to 25 ft., From 80 ft. to 88 ft., From ..... ft. to ..... ft.  
 What is the nearest source of possible contamination:  
 1 Septic tank 4 Lateral lines 7 Pit privy 10 Livestock pens 14 Abandoned water well  
 2 Sewer lines 5 Cess pool 8 Sewage lagoon 11 Fuel storage 15 Oil well/Gas well  
 3 Watertight sewer lines 6 Seepage pit 9 Feedyard 12 Fertilizer storage 16 Other (specify below)  
 13 Insecticide storage .....  
 Direction from well? North How many feet? 600 ft

FROM	TO	LITHOLOGIC LOG	FROM	TO	PLUGGING INTERVALS
0	1	Sandy Top Soil			
1	10	Fine Sand			
10	26	Brown Clay			
26	27	Fine Sand			
27	52	Brown Clay			
52	82	Fine Sand			
82	87	Conglomerate-very Hard			
87	88	Limestone			
		Open Hole			
88	90	Limestone			
90	91 1/2	Cavity-Water Bearing			
91 1/2	93	Limestone			

7 CONTRACTOR'S OR LANDOWNER'S CERTIFICATION: This water well was (1) constructed, (2) reconstructed, or (3) plugged under my jurisdiction and was completed on (mo/day/year) 5-5-92 and this record is true to the best of my knowledge and belief. Kansas Water Well Contractor's License No. 138 This Water Well Record was completed on (mo/day/yr) 5-13-92 under the business name of Peterson Irrigation, Inc. by (signature) Mike Peterson