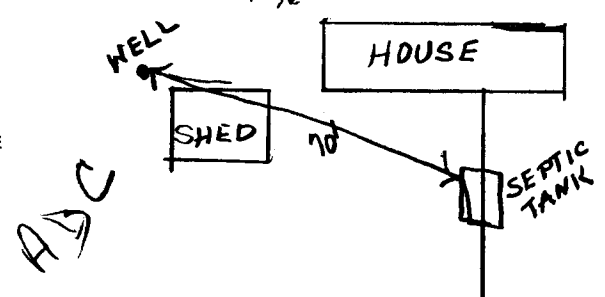


USE TYPEWRITER OR BALL POINT PEN-PRESS FIRMLY, PRINT CLEARLY.

WATER WELL RECORD
KSA 82a-1201-1215

Kansas Department of Health and Environment-Division of Environment
(Water well Contractors)
Topeka, Kansas 66620

1. Location of well:		County Dickinson	Fraction SW 1/4 SE 1/4 NE 1/4	Section number 24	Township number T 13 S R 1	Range number (E)W
2. Distance and direction from nearest town or city: 2 miles west of Abilene				3. Owner of well: George Sanchez R.R. #3 Abilene, Kans.		
4. Locate with "X" in section below: N W E S 1 Mile 1 Mile				Sketch map: N 		
5. Type and color of material				From	To	6. Bore hole dia. 8 in. Completion date 9/19/75 Well depth 59 ft.
Sand				0	11	7. <input checked="" type="checkbox"/> Cable tool <input checked="" type="checkbox"/> Rotary <input type="checkbox"/> Driven <input type="checkbox"/> Aug <input type="checkbox"/> Hollow rod <input type="checkbox"/> Jetted <input type="checkbox"/> Bored <input type="checkbox"/> Reverse rotary
Clay				11	16	8. Use: <input type="checkbox"/> Domestic <input type="checkbox"/> Public supply <input type="checkbox"/> Industry <input checked="" type="checkbox"/> Irrigation <input type="checkbox"/> Air conditioning <input type="checkbox"/> Stock <input type="checkbox"/> Lawn <input type="checkbox"/> Oil field water <input type="checkbox"/> Other
Sandy clay				16	28	9. Casing: Material Plst Height Above or below Threaded <input type="checkbox"/> Welded <input type="checkbox"/> Surface 18 in. RMP <input checked="" type="checkbox"/> PVC <input type="checkbox"/> Weight <input type="checkbox"/> lbs./ft. Dia. 5 in. to 59 ft. depth; Wall Thickness: inches or Dia. <input type="checkbox"/> in. to <input type="checkbox"/> ft. depth; gage No. 0.214
Clay				28	35	10. Screen: Manufacturer's name Western Plastics Type RMP Dia. 5" Slot/gauze 3/32 Length 14 Set between 45 ft. and 59 ft. _____ ft. and _____ ft. Gravel pack? Yes Size range of material 1/16 to 3/8
Sand and clay				35	43	11. Static water level: _____ mo./day/yr. 26 ft. below land surface Date 9/19/75
Small gravel				43	45	12. Pumping level below land surfaces: _____ ft. after _____ hrs. pumping _____ g.p.m. _____ ft. after _____ hrs. pumping _____ g.p.m. Estimated maximum yield 20 g.p.m.
Blue clay				45	47	13. Water sample submitted: _____ mo./day/yr. Yes <input checked="" type="checkbox"/> No <input type="checkbox"/> Date _____
Hollow rock and fine sand				47	53	14. Well head completion: <input checked="" type="checkbox"/> Pitless adapter 18 inches above grade
Bed rock				53	59	15. Well grouted? Yes With: <input checked="" type="checkbox"/> Neat cement <input type="checkbox"/> Bentonite <input type="checkbox"/> Concrete Depth: From 0 ft. to 10 ft.
(Use a second sheet if needed)						16. Nearest source of possible contamination: _____ ft. _____ Direction SE Type septic tank Well disinfected upon completion? _____ Yes _____ No
						17. Pump: _____ Not installed Manufacturer's name Reda Model number 54657 HP 3/4 Volts 220 Length of drop pipe 50 ft. capacity 20 g.p.m. Type: <input checked="" type="checkbox"/> Submersible <input type="checkbox"/> Turbine <input type="checkbox"/> Jet <input type="checkbox"/> Reciprocating <input type="checkbox"/> Centrifugal <input type="checkbox"/> Other
18. Elevation:	19. Remarks:		20. Water well contractor's certification: This well was drilled under my jurisdiction and this report is true to the best of my knowledge and belief. Rader Drilling Co. 194 Business name _____ license No. _____ Address Carlton, Kansas 67429 Signed Brant Rader Date 11-19 Authorized representative			
Topography: <input type="checkbox"/> Hill <input type="checkbox"/> Slope <input type="checkbox"/> Upland <input checked="" type="checkbox"/> Valley						

T 13 - 1 W 24 SE NE 1/4 1/4 1/4

Forward the white, blue and pink copies to the Department of Health and Environment

Form WWC-5