USE TYPEWRITER OR BALL POINT PEN-PRESS FIRMLY, PRINT CLEARLY.

T		R	EW	sec 1/4	1/4	1/4	No.		

WATER WELL RECORD
KSA 82a-1201-1215

Kansas State Dept. Of Health
(Water Well Contractors)
Forbes-Bldg. 740
Topeka, Kansas 66620

1 Location of well:	County	Township name	Fraction	Section number	Town number	Range number
	Dickinson	Lincoln	NE-NW-NW	24	T13 S	R1E

Distance and direction from neorest town or city: 3 mile ~~East~~ West of Abilene

Street address of well location if in city:

3 Owner of well: EL Shafer
Address: Route 4 Abilene Kan 67410

Locate with "X" in section below:

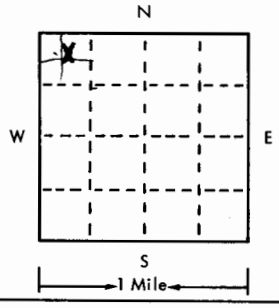

Sketch map:

4 Well depth: 62 ft. Date of completion 13 June 1975
Well diameter 10 in.

5 ☐ Coble tool ☒ Rotary ☐ Driven ☐ Dug ☐ Hollow rod ☐ Jetted ☐ Bored ☐ Reverse rotary

6 Use: ☒ Domestic ☐ Public supply ☐ Industry ☐ Irrigation ☐ Air conditioning ☐ Commercial ☐ Test well ☐

7 Casing: Material RMP Threaded ☐ Welded ☐
Diam. 5 in. to 52 ft. depth
___ in. to ___ ft. depth
Height: above/below Surface 14 in.
Weight ___ lbs./ft.
Drive shoe? ☐ Yes ☒ No

2

Type and color of material	From	To
Blow SAND	0	30
SANDY CLAY	30	54
Large Coarse Sand Water showed at 52 ft.	54	62

(use a second sheet if needed)

8 Screen:
Manufacturer Sunflower
Type RMP Dia. 5"
Slot/gauze 16" Length 10'
Set between 52 ft. and 62 ft.
Fittings:
Gravel pack ☒ Yes ☐ No Size range of material 1/4"

9 Static water level:
35 ft. below land surface Date 13 June

10 Pumping level below land surfaces:
___ ft. after ___ hrs. pumping ___ g.p.m.
___ ft. after ___ hrs. pumping ___ g.p.m.
Estimated maximum yield 20 g.p.m.

11 Water sample submitted:
☐ Yes ☒ No Date ___

12 Well head completion:
☐ Pitless adapter ☒ Inches above grade 14

13 Well grouted? ☒ Yes ☐ No
☒ Neat cement ☐ Bentonite ☐ ___
Depth: From ___ ft. to ___ ft.

14 Nearest source of possible contamination:
ft. 80 Direction Down hill Type Septic
Well disinfected upon completion? ☒ Yes ☐ No

15 Pump: ☒ Not installed
Manufacturer's name ___
Model number ___ HP ___ Volts ___
Length of drop pipe ___ ft. capacity ___ g.m.p.
Type:
☐ Submersible ☐ Turbine
☐ Jet ☐ Reciprocating
☐ Certrifugal ☐ Other

16 Remarks: elevation Concret Slab to be installed by owner during fabrication of well house

Topography:
☐ Hill
☒ Slope
☐ Upland
☐ Valley

17 Water well contractor's certification:
This well was drilled under my jurisdiction and this report is true to the best of my knowledge and belief.
Business name Zinn Water Well Drilling License No. 218
Address Lost Springs, Kan
Signed Joseph A. Zinn Date 29 June 1975
Authorized representative

Forward the white, blue and pink copies to the Kansas State Dept. Of Health.

Form WWC-5

677-H