


1 LOCATION OF WATER WELL: County: **DICKENSON** Fraction: **SE 1/4 NE 1/4** Section Number: **26** Township Number: **T 13 S** Range Number: **R 1 E**

Distance and direction from nearest town or city street address of well if located within city?
340' WEST OF EDEN RD, .7 MI SO. OF SMOKEY HILL RD.

2 WATER WELL OWNER: **CHARLES CLEMENCE**
 RR#, St. Address, Box #: **575 OLD HWY 40** Board of Agriculture, Division of Water Resources
 City, State, ZIP Code: **ABILENE KS 67410** Application Number:

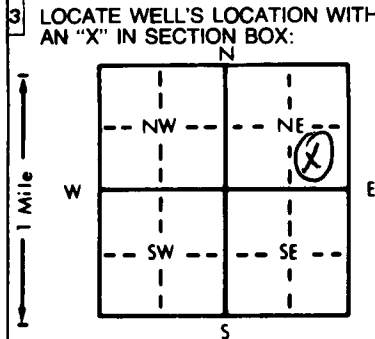

4 DEPTH OF COMPLETED WELL: **25** ft. ELEVATION:
 Depth(s) Groundwater Encountered 1. **20.83** ft. 2. ft. 3. ft.
 WELL'S STATIC WATER LEVEL **20.83** ft. below land surface measured on mo/day/yr **3/11/99**
 Pump test data: Well water was ft. after hours pumping gpm
 Est. Yield gpm: Well water was ft. after hours pumping gpm
 Bore Hole Diameter: **8** in. to **2.5** ft. and in. to ft.
 WELL WATER TO BE USED AS:
 1 Domestic 3 Feedlot 6 Oil field water supply 9 Dewatering 12 Other (Specify below)
 2 Irrigation 4 Industrial 7 Lawn and garden only **10 Monitoring well**
 Was a chemical/bacteriological sample submitted to Department? Yes **No**; If yes, mo/day/yr sample was submitted
 Water Well Disinfected? Yes **No**

5 TYPE OF BLANK CASING USED:
 1 Steel 3 RMP (SR) 5 Wrought iron 8 Concrete tile CASING JOINTS: Glued Clamped
2 PVC 4 ABS 6 Asbestos-Cement 9 Other (specify below) **Welded**
 7 Fiberglass **Threaded**
 Blank casing diameter **2"** in. to ft., Dia in. to ft., Dia in. to ft.
 Casing height above land surface **24"** in., weight lbs./ft. Wall thickness or gauge No. **SCH 40**
 TYPE OF SCREEN OR PERFORATION MATERIAL:
 1 Steel 3 Stainless steel 5 Fiberglass 8 RMP (SR) 10 Asbestos-cement
 2 Brass 4 Galvanized steel 6 Concrete tile 9 ABS 11 Other (specify)
 12 None used (open hole)
 SCREEN OR PERFORATION OPENINGS ARE:
 1 Continuous slot 3 Mill slot 5 Gauzed wrapped 8 Saw cut 11 None (open hole)
 2 Louvered shutter 4 Key punched 6 Wire wrapped 9 Drilled holes
 7 Torch cut 10 Other (specify)
 SCREEN-PERFORATED INTERVALS: From **15** ft. to **25** ft., From ft. to ft.
 GRAVEL PACK INTERVALS: From **14** ft. to **25** ft., From ft. to ft.

6 GROUT MATERIAL: 1 Neat cement 2 Cement grout 3 Bentonite 4 Other
 Grout intervals: From **0** ft. to **2** ft., From **2** ft. to **14** ft., From ft. to ft.
 What is the nearest source of possible contamination:
 1 Septic tank 4 Lateral lines 7 Pit privy 10 Livestock pens 14 Abandoned water well
 2 Sewer lines 5 Cess pool 8 Sewage lagoon 11 Fuel storage 15 Oil well/Gas well
 3 Watertight sewer lines 6 Seepage pit 9 Feedyard 12 Fertilizer storage 16 Other (specify below)
 13 Insecticide storage **NONE**
 Direction from well? How many feet?

FROM	TO	LITHOLOGIC LOG	FROM	TO	PLUGGING INTERVALS
0	2	SILTY LOAM			
2	6	SILTY CLAY			
6	14	CLAY			
14	20	SILTY CLAY			
20	25	CLAYS + HEAVING SANDS			

7 CONTRACTOR'S OR LANDOWNER'S CERTIFICATION: This water well was **(1) constructed**, (2) reconstructed, or (3) plugged under my jurisdiction and was completed on (mo/day/year) **3/11/99** and this record is true to the best of my knowledge and belief. Kansas Water Well Contractor's License No. **659A** This Water Well Record was completed on (mo/day/yr) **3/23/99** under the business name of **STONE ENVIRONMENTAL** by (signature) **PAUL T. DAVE**

OFFICE USE ONLY
T
R
EW
SEC.