

7MO37


WATER WELL RECORD Form WWC-5 KSA 82a-1212

1 LOCATION OF WATER WELL: Fraction NE 1/4 NE 1/4 SE 1/4 Section Number 12 Township Number T 13 S Range Number R 1 E

Distance and direction from nearest town or city street address of well if located within city? I-70 & FAIR RD

2 WATER WELL OWNER: KDHE TIME & MATERIALS RR#, St. Address, Box #: STUCKEYS City, State, ZIP Code: U5-021-039 Board of Agriculture, Division of Water Resources Application Number:

3 LOCATE WELL'S LOCATION WITH AN "X" IN SECTION BOX:

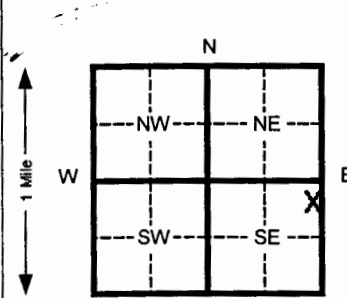

4 DEPTH OF COMPLETED WELL 30 ft. ELEVATION: NA Depth(s) Groundwater Encountered 1 NA ft. 2 ft. 3 ft. WELL'S STATIC WATER LEVEL DRY ft. below land surface measured on mo/day/yr 3/28/01 Pump test data: Well water was Ft. after hours pumping Gpm Est. Yield Gpm: Well water was Ft. after Hours pumping Gpm Bore Hole Diameter 4.25 In. to 30 ft. and in. to Ft. WELL WATER TO BE USED AS: 5 Public water supply 8 Air conditioning 11 Injection well 1 Domestic 3 Feed lot 6 Oil field water supply 9 Dewatering 12 Other (Specify below) 2 Irrigation 4 Industrial 7 Lawn and garden (domestic) 10 Monitoring well MW-14 Was a chemical/bacteriological sample submitted to Department? Yes No X If yes, mo/day/yr sample was Submitted Water Well Disinfected? Yes No X

5 TYPE OF BLANK CASING USED: 1 Steel 3 RMP (SR) 5 Wrought Iron 8 Concrete tile CASING JOINTS: Glued Clamped 2 PVC 4 ABS 6 Asbestos-Cement 9 Other (specify below) Welded 7 Fiberglass Threaded X

Blank casing diameter 2 in. to 10 Ft., Dia in. to ft., Dia in. to ft. Casing height above land surface 2 FT in., weight SCH 40 Lbs./ft. Wall thickness or gauge No.

TYPE OF SCREEN OR PERFORATION MATERIAL: 1 Steel 3 Stainless steel 5 Fiberglass 8 RMP (SR) 11 Other (specify) 2 Brass 4 Galvanized steel 6 Concrete tile 9 ABS 12 None used (open hole) 7 PVC 10 Asbestos-cement

SCREEN OR PERFORATION OPENINGS ARE: 1 Continuous slot 3 Mill slot 5 Gauzed wrapped 8 Saw cut 11 None (open hole) 2 Louvered shutter 4 Key punched 6 Wire wrapped 9 Drilled holes 7 Torch cut 10 Other (specify)

SCREEN-PERFORATED INTERVALS: From 10 ft. to 30 ft. From ft. to ft. From ft. to ft. From ft. to ft. SAND PACK INTERVALS: From 9 ft. to 30 ft. From ft. to ft. From ft. to ft. From ft. to ft.

6 GROUT MATERIAL: 1 Neat cement 2 Cement grout 3 Bentonite 4 Other Grout Intervals From 3 ft. to 9 ft. From 0 ft. to ft. From ft. to ft.

What is the nearest source of possible contamination: 1 Septic tank 4 Lateral lines 7 Pit privy 10 Livestock pens 14 Abandoned water well 2 Sewer lines 5 Cess pool 8 Sewage lagoon 11 Fuel storage 15 Oil well/ Gas well 3 Watertight sewer lines 6 Seepage pit 9 Feedyard 12 Fertilizer storage 16 Other (specify below) Contaminated Site 13 Insecticide storage

Direction from well? How many feet? Table with columns: FROM, TO, CODE, LITHOLOGIC LOG, FROM, TO, PLUGGING INTERVALS. Rows include: 0 to 15 Clay w/ some silt, 15 to 30 Mudstone, 30 to TD End of borehole.

7 CONTRACTOR'S OR LANDOWNER'S CERTIFICATION: This water well was (x) constructed, (2) reconstructed, or (3) plugged under my jurisdiction and was Completed on (mo/day/yr) 3/26/01 And this record is true to the best of my knowledge and belief. Kansas Water Well Contractor's License No. 585 This Water Well Record was completed on (mo/day/yr) 4/03/01 under the business name of Associated Environmental, Inc. By (signature) Darin R Duncan

INSTRUCTIONS: Please fill in blanks and circle the correct answers. Send three copies to Kansas Department of Health and Environment, Bureau of Water, Topeka, Kansas 66620-0001. Telephone: 913-296-5545. Send one to WATER WELL OWNER and retain one for your records.

OFFICE USE ONLY T R SEC