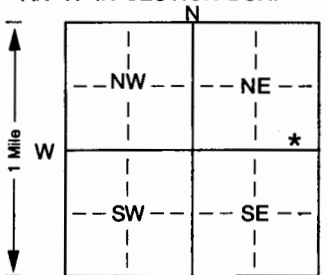


1 LOCATION OF WATER WELL: Fraction SE 1/4 SE 1/4 NE 1/4 Section Number 24 Township Number T 13 S Range Number R 21 E **W****
 County: Dickinson
 Distance and direction from nearest town or city street address of well if located within city?
2 1/2 miles West of Abilene, Ks on 1st St from Hwy 15 & 1 1/2 South & 1/8 mile West

2 WATER WELL OWNER: John & Molly Veach
 RR#, St. Address, Box # : 2141 Briar Meadow Rd. Board of Agriculture, Division of Water Resources
 City, State, ZIP Code : Abilene, Kansas 67410 Application Number:

3 LOCATE WELL'S LOCATION WITH AN "X" IN SECTION BOX:

 4 DEPTH OF COMPLETED WELL: 5.1 ft. ELEVATION: ft.
 Depth(s) Groundwater Encountered 1. 4.0 ft. 2. ft. 3. ft.
 WELL'S STATIC WATER LEVEL 27 ... ft. below land surface measured on mo/day/yr 5 / 10 / 01
 Pump test data: Well water was ft. after hours pumping gpm
 Est. Yield ... 15 ... gpm: Well water was ft. after hours pumping gpm
 Bore Hole Diameter. 9 in. to 5.1 ft., and in. to ft.
 WELL WATER TO BE USED AS: 5 Public water supply 8 Air conditioning 11 Injection well
 1 Domestic 3 Feedlot 6 Oil field water supply 9 Dewatering 12 Other (Specify below)
 2 Irrigation 4 Industrial 7 Domestic (lawn & garden) 10 Monitoring well
 Was a chemical/bacteriological sample submitted to Department? Yes. No. * . . . ; If yes, mo/day/yr sample was sub-
 mitted Water Well Disinfected? Yes * No

5 TYPE OF BLANK CASING USED:
 1 Steel 3 RMP (SR) 5 Wrought iron 8 Concrete tile CASING JOINTS: Glued. * Clamped.
 2 PVC 4 ABS 6 Asbestos-Cement 9 Other (specify below) Welded
 7 Fiberglass Threaded.
 Blank casing diameter 5 in. to 5.1 ft., Dia in. to ft., Dia in. to ft.
 Casing height above land surface. ... 20 in., weight 16.0 lbs./ft. Wall thickness or gauge No. ... 2.14
 TYPE OF SCREEN OR PERFORATION MATERIAL:
 1 Steel 3 Stainless steel 5 Fiberglass 7 PVC 10 Asbestos-cement
 2 Brass 4 Galvanized steel 6 Concrete tile 8 RMP (SR) 11 Other (specify)
 9 ABS 12 None used (open hole)
 SCREEN OR PERFORATION OPENINGS ARE:
 1 Continuous slot 3 Mill slot 5 Gauzed wrapped 8 Saw cut 11 None (open hole)
 2 Louvered shutter 4 Key punched 6 Wire wrapped 9 Drilled holes
 7 Torch cut 10 Other (specify) ft.
 SCREEN-PERFORATED INTERVALS: From 4.4 ft. to 5.1 ft., From ft. to ft.
 GRAVEL PACK INTERVALS: From 2.4 ft. to 5.1 ft., From ft. to ft.
 From ft. to ft., From ft. to ft.

6 GROUT MATERIAL: 1 Neat cement 2 Cement grout 3 Bentonite 4 Other
 Grout Intervals: From 4 ft. to 2.4 ft., From ft. to ft., From ft. to ft.
 What is the nearest source of possible contamination:
 1 Septic tank 4 Lateral lines 7 Pit privy 10 Livestock pens 14 Abandoned water well
 2 Sewer lines 5 Cess pool 8 Sewage lagoon 11 Fuel storage 15 Oil well/Gas well
 3 Watertight sewer lines 6 Seepage pit 9 Feedyard 12 Fertilizer storage 16 Other (specify below)
 13 Insecticide storage
 Direction from well? WEST APPROX How many feet? 130

FROM	TO	LITHOLOGIC LOG	FROM	TO	PLUGGING INTERVALS
0	11	FINE SAND			
11	16	HARD DARK CLAY			
16	24	SOFT SANDY CLAY			
24	38	SOFT DARK CLAY			
38	40	FINE SAND			
40	51	SAND			

7 CONTRACTOR'S OR LANDOWNER'S CERTIFICATION: This water well was (1) constructed, (2) reconstructed, or (3) plugged under my jurisdiction and was completed on (mo/day/year) 5 / 10 / 01 and this record is true to the best of my knowledge and belief. Kansas Water Well Contractor's Licence No. 397 This Water Well Record was completed on (mo/day/yr) 5 / 22 / 01 under the business name of CENTRAL KANSAS DRILLING by (signature) Harold D. Martin