


1 LOCATION OF WATER WELL: Fraction SW 1/4 NE 1/4 NE 1/4 Section Number 2 Township Number T 13 S Range Number R 1 E/W*
 County: Dickinson

Distance and direction from nearest town or city street address of well if located within city?
3 miles North of Solomon, Ks & 4 3/4 miles East

2 WATER WELL OWNER: Neil Blake
 RR#, St. Address, Box # : 2483 Eden Rd. Board of Agriculture, Division of Water Resources
 City, State, ZIP Code : Abilene, Kansas 67410 Application Number:

3 LOCATE WELL'S LOCATION WITH AN "X" IN SECTION BOX:

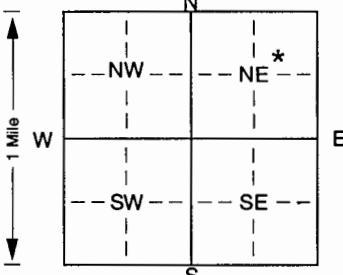

4 DEPTH OF COMPLETED WELL: 45 ft. ELEVATION: ft.
 Depth(s) Groundwater Encountered 1 2.4 ft. 2. ft. 3. ft.
 WELL'S STATIC WATER LEVEL 1.3 ft. below land surface measured on mo/day/yr 8 / 29 / 01
 Pump test data: Well water was ft. after hours pumping gpm
 Est. Yield 1.2 gpm: Well water was ft. after hours pumping gpm
 Bore Hole Diameter. 9 in. to 4.5 ft., and in. to ft.
 WELL WATER TO BE USED AS: 5 Public water supply 8 Air conditioning 11 Injection well
1 Domestic 3 Feedlot 6 Oil field water supply 9 Dewatering 12 Other (Specify below)
2 Irrigation 4 Industrial 7 Domestic (lawn & garden) 10 Monitoring well
 Was a chemical/bacteriological sample submitted to Department? Yes. No. * ; If yes, mo/day/yr sample was submitted Water Well Disinfected? Yes * No

5 TYPE OF BLANK CASING USED: 5 Wrought iron 8 Concrete tile CASING JOINTS: Glued. * Clamped.
1 Steel 3 RMP (SR) 6 Asbestos-Cement 9 Other (specify below) Welded
2 PVC 4 ABS 7 Fiberglass Threaded
 Blank casing diameter 5 in. to 4.5 ft., Dia in. to ft., Dia in. to ft.
 Casing height above land surface. 3.2 in., weight 16.0 lbs./ft. Wall thickness or gauge No. 214
 TYPE OF SCREEN OR PERFORATION MATERIAL: 7 PVC 10 Asbestos-cement
1 Steel 3 Stainless steel 5 Fiberglass 8 RMP (SR) 11 Other (specify)
2 Brass 4 Galvanized steel 6 Concrete tile 9 ABS 12 None used (open hole)
 SCREEN OR PERFORATION OPENINGS ARE: 5 Gauzed wrapped 8 Saw cut 11 None (open hole)
1 Continuous slot 3 Mill slot 6 Wire wrapped 9 Drilled holes
2 Louvered shutter 4 Key punched 7 Torch cut 10 Other (specify) ft.
 SCREEN-PERFORATED INTERVALS: From 2.2 1/2 ft. to 33 ft., From ft. to ft.
 From ft. to ft., From ft. to ft.
 GRAVEL PACK INTERVALS: From 2.0 ft. to 4.5 ft., From ft. to ft.
 From ft. to ft., From ft. to ft.

6 GROUT MATERIAL: 1 Neat cement 2 Cement grout 3 Bentonite 4 Other
 Grout Intervals: From 0 ft. to 2.0 ft., From ft. to ft., From ft. to ft.
 What is the nearest source of possible contamination: 10 Livestock pens 14 Abandoned water well
1 Septic tank 4 Lateral lines 7 Pit privy 11 Fuel storage 15 Oil well/Gas well
2 Sewer lines 5 Cess pool 8 Sewage lagoon 12 Fertilizer storage 16 Other (specify below)
3 Watertight sewer lines 6 Seepage pit 9 Feedyard 13 Insecticide storage
 Direction from well? EAST How many feet? 145

FROM	TO	LITHOLOGIC LOG	FROM	TO	PLUGGING INTERVALS
0	3	FINE SAND			
3	12	DARK CLAY			
12	16	BROWN CLAY & TAN & SHALE			
16	22	SOFT LITE COLOR CLAY			
22	34	SOFT LITE GRAY CLAY			
34	43	FINE SAND			
43	45	CLAY LITE GRAY & SHALEY			

7 CONTRACTOR'S OR LANDOWNER'S CERTIFICATION: This water well was (1) constructed, (2) reconstructed, or (3) plugged under my jurisdiction and was completed on (mo/day/year) 8 / 29 / 01 and this record is true to the best of my knowledge and belief. Kansas Water Well Contractor's Licence No. 397 This Water Well Record was completed on (mo/day/yr) 9 / 11 / 01 under the business name of CENTRAL KANSAS DRILLING by (signature) Herald B. Metz