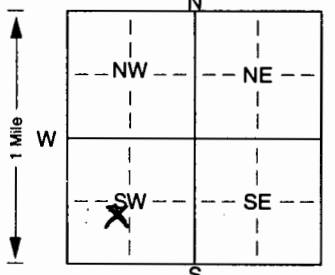


1 LOCATION OF WATER WELL: Fraction NE 1/4 SW 1/4 SW 1/4 Section Number 12 Township Number T 13 S Range Number R 1 E  
 County: Dickenson

Distance and direction from nearest town or city street address of well if located within city?  
1/2 W & N Abilene

2 WATER WELL OWNER: Justin Reynolds  
 RR#, St. Address, Box # : 2321 Eden Rd. Board of Agriculture, Division of Water Resources  
 City, State, ZIP Code : Abilene, KS 67410 Application Number:

3 LOCATE WELL'S LOCATION WITH AN "X" IN SECTION BOX:  
  
 4 DEPTH OF COMPLETED WELL: 74 ft. ELEVATION:  
 Depth(s) Groundwater Encountered: 1. 65 ft. 2. . ft. 3. . ft.  
 WELL'S STATIC WATER LEVEL: 24 ft. below land surface measured on mo/day/yr 10-12-01  
 Pump test data: Well water was . ft. after . hours pumping . gpm  
 Est. Yield: 20 gpm; Well water was . ft. after . hours pumping . gpm  
 Bore Hole Diameter: 2 1/2 in. to 2.0 ft., and 7 in. to 7.4 ft.  
 WELL WATER TO BE USED AS:  
 5 Public water supply 8 Air conditioning 11 Injection well  
 1 Domestic 3 Feedlot 6 Oil field water supply 9 Dewatering 12 Other (Specify below)  
 2 Irrigation 4 Industrial 7 Domestic (lawn & garden) 10 Monitoring well .  
 Was a chemical/bacteriological sample submitted to Department? Yes. . No. X; If yes, mo/day/yr sample was submitted  
 Water Well Disinfected? Yes X No

5 TYPE OF BLANK CASING USED:  
 1 Steel 3 RMP (SR) 5 Wrought iron 8 Concrete tile CASING JOINTS: Glued. X Clamped. .  
 2 PVC 4 ABS 6 Asbestos-Cement 9 Other (specify below) Welded .  
 7 Fiberglass Threaded .  
 Blank casing diameter: 5 in. to 5.4 ft., Dia. . in. to . ft., Dia. . in. to . ft.  
 Casing height above land surface: 12 in., weight CLASS 160 lbs./ft. Wall thickness or gauge No. 214  
 TYPE OF SCREEN OR PERFORATION MATERIAL:  
 1 Steel 3 Stainless steel 5 Fiberglass 7 PVC 10 Asbestos-cement  
 2 Brass 4 Galvanized steel 6 Concrete tile 8 RMP (SR) 11 Other (specify) .  
 9 ABS 12 None used (open hole)  
 SCREEN OR PERFORATION OPENINGS ARE:  
 1 Continuous slot 5 Gauzed wrapped 8 Saw cut 11 None (open hole)  
 2 Louvered shutter 3 Mill slot 6 Wire wrapped 9 Drilled holes  
 4 Key punched 7 Torch cut 10 Other (specify) . ft.  
 SCREEN-PERFORATED INTERVALS: From 54 ft. to 74 ft., From . ft. to . ft.  
 GRAVEL PACK INTERVALS: From . ft. to . ft., From . ft. to . ft.  
 From . ft. to . ft., From . ft. to . ft.

6 GROUT MATERIAL: 1 Neat cement 2 Cement grout 3 Bentonite 4 Other .  
 Grout Intervals: From 0 ft. to 2.0 ft., From . ft. to . ft., From . ft. to . ft.  
 What is the nearest source of possible contamination:  
 1 Septic tank 4 Lateral lines 7 Pit privy 10 Livestock pens 14 Abandoned water well  
 2 Sewer lines 5 Cess pool 8 Sewage lagoon 11 Fuel storage 15 Oil well/Gas well  
 3 Watertight sewer lines 6 Seepage pit 9 Feedyard 12 Fertilizer storage 16 Other (specify below)  
 13 Insecticide storage .  
 Direction from well? S How many feet? 47

FROM	TO	LITHOLOGIC LOG	FROM	TO	PLUGGING INTERVALS
0	25	Yellow Clay			
25	30	lime			
30	45	Blue Gray Shale			
45	55	Red Shale			
55	65	Gray "			
65	66	Water			
66	74	Gray Shale			

7 CONTRACTOR'S OR LANDOWNER'S CERTIFICATION: This water well was (1) constructed, (2) reconstructed, or (3) plugged under my jurisdiction and was completed on (mo/day/year) 10-12-01 and this record is true to the best of my knowledge and belief. Kansas Water Well Contractor's Licence No. 120 This Water Well Record was completed on (mo/day/yr) 10-24-01 under the business name of Backhus Drilling by (signature) Paul R. Backhus