WATER WELL RECORD Form WWC-5 KSA 82a-1212 ID No. _____

1 LOCATION OF WATER WELL:	Fraction	Section Number	Township Number	Range Number
County: Dickinson	NW ¼ SW ¼ SW ¼	10	T 13 S	R 1 E/X

Distance and direction from nearest town or city street address of well if located within city?
3 miles East & 1 mile North of Solomon, KS

2 WATER WELL OWNER: Jeff Cole
RR#, St. Address, Box # : 2330 Daisy Rd.
City, State, ZIP Code : Solomon, KS 67480

Board of Agriculture, Division of Water Resources Application Number:

3 LOCATE WELL'S LOCATION WITH AN "X" IN SECTION BOX:

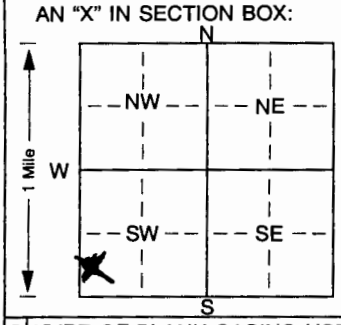

4 DEPTH OF COMPLETED WELL. 54 ft. ELEVATION:
Depth(s) Groundwater Encountered 1. ft. 2. ft. 3. ft.
WELL'S STATIC WATER LEVEL 21 ft. below land surface measured on mo/day/yr 5/14/02
Pump test data: Well water was ft. after hours pumping gpm
Est. Yield 20-25gpm: Well water was ft. after hours pumping gpm
Bore Hole Diameter 9 in. to 54 ft., and in. to ft.
WELL WATER TO BE USED AS: 5 Public water supply 8 Air conditioning 11 Injection well
X Domestic 3 Feedlot 6 Oil field water supply 9 Dewatering 12 Other (Specify below)
2 Irrigation 4 Industrial 7 Domestic (lawn & garden) 10 Monitoring well
Was a chemical/bacteriological sample submitted to Department? Yes No X ; If yes, mo/day/yrs sample was submitted
Water Well Disinfected? Yes X No

5 TYPE OF BLANK CASING USED: 5 Wrought iron 8 Concrete tile CASING JOINTS: Glued X Clamped
1 Steel 3 RMP (SR) 6 Asbestos-Cement 9 Other (specify below) Welded
X PVC 4 ABS 7 Fiberglass Threaded
Blank casing diameter 5 in. to 44 ft., Dia in. to ft., Dia in. to ft.
Casing height above land surface 12 in., weight 2.37 lbs./ft. Wall thickness or gauge No. .214
TYPE OF SCREEN OR PERFORATION MATERIAL: X PVC 10 Asbestos-cement
1 Steel 3 Stainless steel 5 Fiberglass ~~8 RMP (SR)~~ 11 Other (specify)
2 Brass 4 Galvanized steel 6 Concrete tile 9 ABS 12 None used (open hole)
SCREEN OR PERFORATION OPENINGS ARE: 5 Gauzed wrapped 8 Saw cut 11 None (open hole)
1 Continuous slot X Mill slot 6 Wire wrapped 9 Drilled holes
2 Louvered shutter ~~4 Key punched~~ 7 Torch cut 10 Other (specify) ft.
SCREEN-PERFORATED INTERVALS: From 44 ft. to 54 ft., From ft. to ft.
From ft. to ft., From ft. to ft.
GRAVEL PACK INTERVALS: From 24 ft. to 54 ft., From ft. to ft.
From ft. to ft., From ft. to ft.

6 GROUT MATERIAL: 1 Neat cement 2 Cement grout X 3 Bentonite 4 Other
Grout Intervals: From 1 ft. to 24 ft., From ft. to ft., From ft. to ft.
What is the nearest source of possible contamination: 10 X Livestock pens 14 Abandoned water well
1 Septic tank 4 Lateral lines 7 Pit privy 11 Fuel storage 15 Oil well/Gas well
2 Sewer lines 5 Cess pool 8 Sewage lagoon 12 Fertilizer storage 16 Other (specify below)
3 Watertight sewer lines 6 Seepage pit 9 Feedyard 13 Insecticide storage
Direction from well? East How many feet? 100

FROM	TO	LITHOLOGIC LOG	FROM	TO	PLUGGING INTERVALS
0	2	Topsoil			
2	25	Clay, tan			
25	54	Sand, fine to medium sand			
	54	Shale, gray			

7 CONTRACTOR'S OR LANDOWNER'S CERTIFICATION: This water well was (1) X constructed, (2) reconstructed, or (3) plugged under my jurisdiction and was completed on (mo/day/year) 5/14/02 and this record is true to the best of my knowledge and belief. Kansas Water Well Contractor's Licence No. 138 This Water Well Record was completed on (mo/day/yr) 5/28/02
under the business name of Peterson Irrigation, Inc. by (signature) Mike Peterson

INSTRUCTIONS: Use typewriter or ball point pen. *PLEASE PRESS FIRMLY* and *PRINT* clearly. Please fill in blanks, underline or circle the correct answers. Send top three copies to Kansas Department of Health and Environment, Bureau of Water, Topeka, Kansas 66620-0001. Telephone 785-296-5524. Send one to WATER WELL OWNER and retain one for your records. Fee of $5.00 for each constructed well.