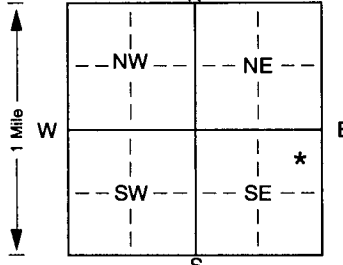


1 LOCATION OF WATER WELL: Fraction NE 1/4 NE 1/4 SE 1/4 Section Number 8 Township Number T 13 S Range Number R 1 E
 County: Dickinson
 Distance and direction from nearest town or city street address of well if located within city?
1 mile East of Solomon, Ks go 1 1/2 North to 2350 Ave & 3/4 miles East

2 WATER WELL OWNER: Mike Schmaderer
 RR#, St. Address, Box # : P.O. Box 313 Board of Agriculture, Division of Water Resources
 City, State, ZIP Code : Solomon, Kansas 67480 Application Number:

3 LOCATE WELL'S LOCATION WITH 4 DEPTH OF COMPLETED WELL: 7.1 ft. ELEVATION:
 AN "X" IN SECTION BOX:

 Depth(s) Groundwater Encountered 1.53 ft. 2. ft. 3. ft.
 WELL'S STATIC WATER LEVEL 3.8 ft. below land surface measured on mo/day/yr 3 / 28 / 02
 Pump test data: Well water was ft. after hours pumping gpm
 Est. Yield 1.5 gpm: Well water was ft. after hours pumping gpm
 Bore Hole Diameter: 9 in. to 7.1 ft., and in. to ft.
 WELL WATER TO BE USED AS: 5 Public water supply 8 Air conditioning 11 Injection well
1 Domestic 3 Feedlot 6 Oil field water supply 9 Dewatering 12 Other (Specify below)
2 Irrigation 4 Industrial 7 Domestic (lawn & garden) 10 Monitoring well
 Was a chemical/bacteriological sample submitted to Department? Yes. No. * ; If yes, mo/day/yr sample was sub-
 mitted Water Well Disinfected? Yes * No

5 TYPE OF CASING USED: 5 Wrought iron 8 Concrete tile CASING JOINTS: Glued. * Clamped.
1 Steel 3 RMP (SR) 6 Asbestos-Cement 9 Other (specify below) Welded
2 PVC 4 ABS 7 Fiberglass Threaded
 Blank casing diameter 5 in. to 7.1 ft., Dia in. to ft., Dia in. to ft.
 Casing height above land surface: 16 in., weight 16.0 lbs./ft. Wall thickness or gauge No. 21.4
 TYPE OF SCREEN OR PERFORATION MATERIAL: 7 PVC 10 Asbestos-cement
1 Steel 3 Stainless steel 5 Fiberglass 8 RMP (SR) 11 Other (specify)
2 Brass 4 Galvanized steel 6 Concrete tile 9 ABS 12 None used (open hole)
 SCREEN OR PERFORATION OPENINGS ARE: 5 Gauzed wrapped 8 Saw cut 11 None (open hole)
1 Continuous slot 3 Mill slot 200# 6 Wire wrapped 9 Drilled holes
2 Louvered shutter 4 Key punched 7 Torch cut 10 Other (specify) ft.
 SCREEN-PERFORATED INTERVALS: From 5.1 ft. to 7.1 ft., From ft. to ft.
 From ft. to ft., From ft. to ft.
 GRAVEL PACK INTERVALS: From 2.4 ft. to 7.1 ft., From ft. to ft.
 From ft. to ft., From ft. to ft.

6 GROUT MATERIAL: 1 Neat cement 2 Cement grout 3 Bentonite 4 Other
 Grout Intervals: From 4 ft. to 24 ft., From ft. to ft., From ft. to ft.
 What is the nearest source of possible contamination:
1 Septic tank 4 Lateral lines 7 Pit privy 10 Livestock pens 14 Abandoned water well
2 Sewer lines 5 Cess pool 8 Sewage lagoon 11 Fuel storage 15 Oil well/Gas well
3 Watertight sewer lines 6 Seepage pit 9 Feedyard 12 Fertilizer storage 16 Other (specify below)
 13 Insecticide storage
 Direction from well? NORTHEAST WILL BE APPROX many feet? 100

FROM	TO	LITHOLOGIC LOG	FROM	TO	PLUGGING INTERVALS
0	4	BROWN SANDY CLAY			
4	9	TAN CLAY			
9	44	LITE COLOR CLAY			
44	53	GRAY CLAY & SHALE			
53	54	HARD GRAY LIMESTONE			
54	68	DARK GRAY SHALE & CLAY			
68	69	GRAY & RED SHALE			
69	70	RED SHALE & GYPSUM			
70	71	GRAY SHALE			

7 CONTRACTOR'S OR LANDOWNER'S CERTIFICATION: This water well was (1) constructed, (2) reconstructed, or (3) plugged under my jurisdiction and was completed on (mo/day/year) 3 / 28 / 02 and this record is true to the best of my knowledge and belief. Kansas Water Well Contractor's Licence No. 397 This Water Well Record was completed on (mo/day/yr) 3 / 31 / 02 under the business name of CENTRAL KANSAS DRILLING by (signature) Harold D. Martin