


1 LOCATION OF WATER WELL: Fraction Section Number Township Number Range Number
 County Dickinson NW 1/4 NE 1/4 SW 1/4 9 T 13 S R 1 E/W

Distance and direction from nearest town or city street address of well if located within city?
1/2 mile North of Solomon, Ks to 2350 Ave & 2 1/4 mile East

2 WATER WELL OWNER: Randy White
 RR#, St. Address, Box # : 320 - 2350 Ave
 City, State, ZIP Code : Solomon, Kansas 67480
 Board of Agriculture, Division of Water Resources
 Application Number:

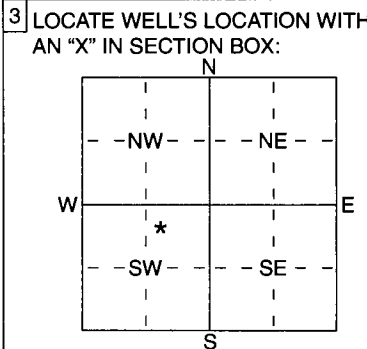

4 DEPTH OF COMPLETED WELL 9.0 ft. ELEVATION:
 Depth(s) Groundwater Encountered 1 2.0 ft. 2 ft. 3 ft.
 WELL'S STATIC WATER LEVEL 1.9 ft. below land surface measured on mo/day/yr 3 / 2.4 / 0.3
 Pump test data: Well water was ft. after hours pumping gpm
 Est. Yield 1.0+ gpm: Well water was ft. after hours pumping gpm
 WELL WATER TO BE USED AS:
 1 Domestic 3 Feedlot 6 Oil field water supply 9 Dewatering 12 Other (Specify below)
 2 Irrigation 4 Industrial 7 Domestic (lawn & garden) 10 Monitoring well
 Was a chemical/bacteriological sample submitted to Department? Yes No *; If yes, mo/day/yr sample was submitted
 Water Well Disinfected? Yes * No

5 TYPE OF BLANK CASING USED:
 1 Steel 3 RMP (SR) 5 Wrought iron 8 Concrete tile CASING JOINTS: Glued * Clamped
 2 PVC 4 ABS 7 Fiberglass 9 Other (specify below) Welded
 Blank casing diameter 5 in. to 9.0 ft., Dia in. to ft., Dia in. to ft.
 Casing height above land surface 2.0 in., weight 2.00 lbs./ft. Wall thickness or gauge No. 2.50
 TYPE OF SCREEN OR PERFORATION MATERIAL:
 1 Steel 3 Stainless Steel 5 Fiberglass 7 PVC 10 Asbestos-Cement
 2 Brass 4 Galvanized Steel 6 Concrete tile 8 RMP (SR) 11 Other (Specify)
 12 None used (open hole)
 SCREEN OR PERFORATION OPENINGS ARE:
 1 Continuous slot 3 Mill slot 5 Gauzed wrapped 8 Saw cut 11 None (open hole)
 2 Louvered shutter 4 Key punched 6 Wire wrapped 9 Drilled holes
 7 Torch cut 10 Other (specify) ft.
 SCREEN-PERFORATED INTERVALS: From 2.0 ft. to 9.0 ft., From ft. to ft.
 From ft. to ft., From ft. to ft.
 GRAVEL PACK INTERVALS: From 1.8 1/2 ft. to 9.0 ft., From ft. to ft.
 From ft. to ft., From ft. to ft.

6 GROUT MATERIAL: 1 Neat cement 2 Cement grout 3 Bentonite 4 Other
 Grout Intervals: From 0 ft. to 1.8 1/2 ft., From ft. to ft., From ft. to ft.
 What is the nearest source of possible contamination:
 1 Septic tank 4 Lateral lines 7 Pit privy 10 Livestock pens 14 Abandoned water well
 2 Sewer lines 5 Cess pool 8 Sewage lagoon 11 Fuel storage 15 Oil well/Gas well
 3 Watertight sewer lines 6 Seepage pit 9 Feedyard 12 Fertilizer storage 16 Other (specify below)
 13 Insecticide storage
 Direction from well? SOUTHWEST APPROX How many feet? 140

FROM	TO	LITHOLOGIC LOG	FROM	TO	PLUGGING INTERVALS
0	5	FINE SAND	61	88	GRAY & LITE CLAY & SHALE
5	10	CLAY & SHALE	88	90	RED SHALE & GYPSUM
10	12	SANDY CLAY			
12	14	FINE SAND LITTLE CLAY			
14	17	LITE COLOR SHALE CLAY			
17	19	LITE COLOR SHALE			
19	22	TAN & GRAY DARK SHALE & CLAY			
22	28	LITE COLOR SHALE			
28	33	DARK SHALE & CLAY			
33	35	LITE COLOR SHALE & CLAY			
35	40	GRAY SHALE			
40	44	GRAY & WHITE SHALE & CLAY			
44	48	GRAY CLAY & SHALE			
48	61	GRAY & LITE COLOR SHALE			

7 CONTRACTOR'S OR LANDOWNER'S CERTIFICATION: This water well was (1) constructed, (2) reconstructed, or (3) plugged under my jurisdiction and was completed on (mo/day/year) 3 / 2.4 / 0.3 and this record is true to the best of my knowledge and belief. Kansas Water Well Contractor's Licence No 397 This Water Well Record was completed on (mo/day/yr) 3 / 2.5 / 0.3 under the business name of CENTRAL KANSAS DRILLING by (signature) Herald D. Mast

INSTRUCTIONS: Use typewriter or ball point pen. PLEASE PRESS FIRMLY and PRINT clearly. Please fill in blanks, underline or circle the correct answers. Send top three copies to Kansas Department of Health and Environment, Bureau of Water, Geology Section, 1000 SW Jackson St., Suite 420, Topeka, Kansas 66612-1367. Telephone 785-296-5522. Send one to WATER WELL OWNER and retain one for your records. Fee of \$5.00 for each constructed well.