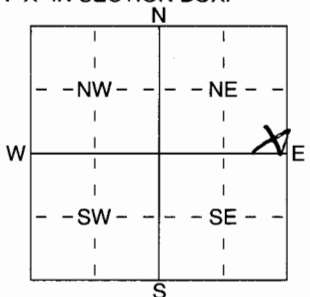


1 LOCATION OF WATER WELL: Fraction SE 1/4 SE 1/4 NE 1/4 Section Number 13 Township Number T 13 S Range Number R 1 EW
 County: DECKENSON

Distance and direction from nearest town or city street address of well if located within city?
2273 FAIR RD, ABILENE

2 WATER WELL OWNER: T.C. HOWARD
 RR#, St. Address, Box # : 2273 FAIR RD Board of Agriculture, Division of Water Resources
 City, State, ZIP Code : ABILENE, KS 67410 Application Number: _____

3 LOCATE WELL'S LOCATION WITH AN "X" IN SECTION BOX:

 4 DEPTH OF COMPLETED WELL 100 ft. ELEVATION: _____
 Depth(s) Groundwater Encountered 1 6.2 ft. 2 _____ ft. 3 _____ ft.
 WELL'S STATIC WATER LEVEL 4.7 ft. below land surface measured on mo/day/yr 4/12/05
 Pump test data: Well water was _____ ft. after _____ hours pumping _____ gpm
 Est. Yield 2.0 gpm: Well water was _____ ft. after _____ hours pumping _____ gpm
 WELL WATER TO BE USED AS:
 1 Domestic 2 Irrigation 3 Feedlot 4 Industrial 5 Public water supply 6 Oil field water supply 7 Domestic (lawn & garden) 8 Air conditioning 9 Dewatering 10 Monitoring well 11 Injection well 12 Other (Specify below)

5 TYPE OF BLANK CASING USED:
 1 Steel 2 Brass 3 RMP (SR) 4 Galvanized Steel 5 Wrought iron 6 Asbestos-Cement 7 Fiberglass 8 Concrete tile 9 Other (specify below)
PVC 4 ABS
 Blank casing diameter 5 in. to 80 ft. Dia _____ in. to _____ ft. Dia _____ in. to _____ ft. Dia _____ in. to _____ ft.
 Casing height above land surface 24 in., weight _____ lbs./ft. Wall thickness or gauge No. SDR21
 TYPE OF SCREEN OR PERFORATION MATERIAL:
 1 Steel 2 Brass 3 Stainless Steel 4 Galvanized Steel 5 Fiberglass 6 Concrete tile 8 RMP (SR) 9 ABS 10 Asbestos-Cement 11 Other (Specify) 12 None used (open hole)
 SCREEN OR PERFORATION OPENINGS ARE:
 1 Continuous slot 2 Louvered shutter 3 Mill slot 4 Key punched 5 Gauzed wrapped 6 Wire wrapped 7 Torch cut 8 Saw cut 9 Drilled holes 10 Other (specify) 11 None (open hole)
 SCREEN-PERFORATED INTERVALS: From 80 ft. to 100 ft. From _____ ft. to _____ ft. From _____ ft. to _____ ft.
 GRAVEL PACK INTERVALS: From 25 ft. to 100 ft. From _____ ft. to _____ ft. From _____ ft. to _____ ft.

6 GROUT MATERIAL: 1 Neat cement 2 Cement grout 3 Bentonite 4 Other _____
 Grout Intervals: From _____ ft. to _____ ft. From _____ ft. to _____ ft. From _____ ft. to _____ ft. From _____ ft. to _____ ft.
 What is the nearest source of possible contamination:
 1 Septic tank 2 Sewer lines 3 Watertight sewer lines 4 Lateral lines 5 Cess pool 6 Seepage pit 7 Pit privy 8 Sewage lagoon 9 Feedyard 10 Livestock pens 11 Fuel storage 12 Fertilizer storage 13 Insecticide storage 14 Abandoned water well 15 Oil well/Gas well 16 Other (specify below)
 Direction from well? NORTH How many feet? 75
HOUSE

FROM	TO	LITHOLOGIC LOG	FROM	TO	PLUGGING INTERVALS
0	4	CLAY, BROWN			
4	20	SANDW/CLAY			
20	44	SHALE, TAN			
44	62	WEATHERED, SHALE, SANDS HD			
62	84	SHALE, GRAY GRABSTO RED			
84	90	LIMESTONE			
90	100	SHALE, GRAY			

7 CONTRACTOR'S OR LANDOWNER'S CERTIFICATION: This water well was (1) constructed, (2) reconstructed, or (3) plugged under my jurisdiction and was completed on (mo/day/year) 4/12/05 and this record is true to the best of my knowledge and belief. Kansas Water Well Contractor's Licence No SBS This Water Well Record was completed on (mo/day/yr) 5/30/05 under the business name of ASSOCIATED DRILLING INC. by (signature) _____