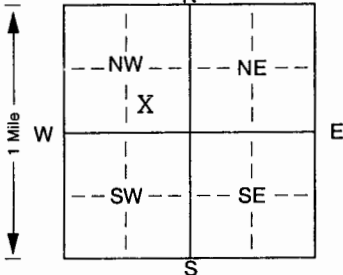


1 LOCATION OF WATER WELL: Fraction SW 1/4 SE 1/4 NW 1/4 Section Number 18 Township Number T 13 S Range Number R 1 E/W  
 County: Dickinson

Distance and direction from nearest town or city street address of well if located within city?  
211 E. 7th, Solomon

2 WATER WELL OWNER: Brian Jennings  
 RR#, St. Address, Box #: 211 E. 7th Board of Agriculture, Division of Water Resources  
 City, State, ZIP Code: Solomon, KS 67480 Application Number:

3 LOCATE WELL'S LOCATION WITH AN "X" IN SECTION BOX:  
  
 4 DEPTH OF COMPLETED WELL: 58 ft. ELEVATION:  
 Depth(s) Groundwater Encountered 1. 1 ft. 2. 1 ft. 3. 1 ft.  
 WELL'S STATIC WATER LEVEL: 25 ft. below land surface measured on mo/day/yr 6/20/07  
 Pump test data: Well water was 10 gpm after 10 hours pumping  
 Est. Yield 10 gpm: Well water was 8 in. to 58 ft. after 10 hours pumping  
 Bore Hole Diameter: 8 in. to 58 ft. and 58 in. to 58 ft.  
 WELL WATER TO BE USED AS: 5 Public water supply 8 Air conditioning 11 Injection well  
 1 Domestic 3 Feedlot 6 Oil field water supply 9 Dewatering 12 Other (Specify below)  
 2 Irrigation 4 Industrial 7 Domestic (lawn & garden) 10 Monitoring well  
 Was a chemical/bacteriological sample submitted to Department? Yes. No. X; If yes, mo/day/yr sample was submitted  
 Water Well Disinfected? Yes X No

5 TYPE OF BLANK CASING USED:  
 1 Steel 3 RMP (SR) 5 Wrought iron 8 Concrete tile CASING JOINTS: Glued X Clamped  
2 PVC 4 ABS 6 Asbestos-Cement 9 Other (specify below) Welded  
 7 Fiberglass Threaded  
 Blank casing diameter 5 in. to 38 ft., Dia. 18 in. to 160 lbs./ft. Wall thickness or gauge No.  
 Casing height above land surface 18 in., weight 160 lbs./ft. Wall thickness or gauge No.  
 TYPE OF SCREEN OR PERFORATION MATERIAL:  
 1 Steel 3 Stainless steel 5 Fiberglass 7 PVC 10 Asbestos-cement  
 2 Brass 4 Galvanized steel 6 Concrete tile 8 RMP (SR) 11 Other (specify)  
 9 ABS 12 None used (open hole)  
 SCREEN OR PERFORATION OPENINGS ARE:  
 1 Continuous slot 3 Mill slot 5 Gauzed wrapped 8 Saw cut 11 None (open hole)  
 2 Louvered shutter 4 Key punched 6 Wire wrapped 9 Drilled holes  
 7 Torch cut 10 Other (specify) ft.  
 SCREEN-PERFORATED INTERVALS: From 38 ft. to 58 ft., From 38 ft. to 58 ft.  
 GRAVEL PACK INTERVALS: From 22 ft. to 58 ft., From 22 ft. to 58 ft.

6 GROUT MATERIAL: 1 Neat cement 2 Cement grout 3 Bentonite 4 Other  
 Grout Intervals: From 0 ft. to 22 ft., From 3 ft. to 22 ft., From 3 ft. to 22 ft.  
 What is the nearest source of possible contamination:  
 1 Septic tank 4 Lateral lines 7 Pit privy 10 Livestock pens 14 Abandoned water well  
 2 Sewer lines 5 Cess pool 8 Sewage lagoon 11 Fuel storage 15 Oil well/Gas well  
 3 Watertight sewer lines 6 Seepage pit 9 Feedyard 12 Fertilizer storage 16 Other (specify below)  
 13 Insecticide storage  
 Direction from well? South How many feet? 50

| FROM | TO | LITHOLOGIC LOG                   | FROM | TO | PLUGGING INTERVALS |
|------|----|----------------------------------|------|----|--------------------|
| 0    | 6  | Clay                             |      |    |                    |
| 6    | 16 | Sand - med.                      |      |    |                    |
| 16   | 22 | Gravel                           |      |    |                    |
| 22   | 23 | Clay - yellow                    |      |    |                    |
| 23   | 38 | Clay - gray                      |      |    |                    |
| 38   | 39 | Sandstone                        |      |    |                    |
| 39   | 40 | Sand - med.                      |      |    |                    |
| 40   | 43 | Clay - gray, with sand stringers |      |    |                    |
| 43   | 60 | Clay - gray                      |      |    |                    |

7 CONTRACTOR'S OR LANDOWNER'S CERTIFICATION: This water well was (1) constructed, (2) reconstructed, or (3) plugged under my jurisdiction and was completed on (mo/day/year) 7/15/2007 and this record is true to the best of my knowledge and belief. Kansas Water Well Contractor's Licence No. 527. This Water Well Record was completed on (mo/day/yr) 6/15/2007 under the business name of GeoCore Inc. by (signature) Dale Kelly