

WATER WELL RECORD


Form WWC-5

Division of Water Resources App. No.

1 LOCATION OF WATER WELL: County: Dickinson Fraction 1/4 NE 1/4 NE 1/4 SE 1/4 Section Number 3 Township No. T 13 S Range Number R 1 [X]E []W

Street/Rural Address of Well Location; if unknown, distance & direction from nearest town or intersection: If at owner's address, check here []. Global Positioning System (GPS) information: Latitude: Longitude: Elevation: Datum: [] WGS 84, [] NAD 83, [] NAD 27

2 WATER WELL OWNER: Michael Clark RR#, Street Address, Box #: 119 E. 4th St. City, State, ZIP Code: Solomon, KS 67480 Collection Method: [] GPS unit, [] Digital Map/Photo, [] Topographic Map, [] Land Survey

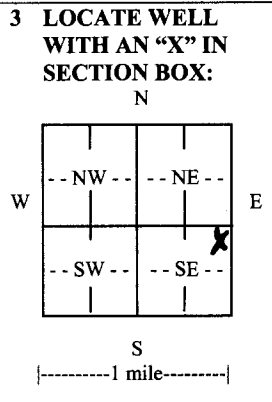

3 LOCATE WELL WITH AN 'X' IN SECTION BOX: 4 DEPTH OF COMPLETED WELL 60 ft. Depth(s) Groundwater Encountered (1) 21 ft. (2) ft. (3) ft. WELL'S STATIC WATER LEVEL 21 ft. below land surface measured on mo/day/yr 3/13/12

5 TYPE OF CASING USED: [] Steel [X] PVC [] Other CASING JOINTS: [X] Glued [] Clamped [] Welded [] Threaded Casing diameter 5 in. to 40 ft., Diameter in. to ft., Diameter in. to ft. Casing height above land surface 12 in., Weight 2.37 lbs./ft., Wall thickness or gauge No. 214

6 GROUT MATERIAL: [] Neat cement [] Cement grout [X] Bentonite [] Other Grout Intervals: From 0 ft. to 20 ft., From ft. to ft., From ft. to ft. What is the nearest source of possible contamination: None within 1/4 mile

Table with columns: FROM, TO, LITHOLOGIC LOG, FROM, TO, LITHO. LOG (cont.) or PLUGGING INTERVALS. Rows include: 0-5 Sandy Topsoil, 5-50 Fine Sand, 50-56 Clay, gray, 56-57 Cavity, 57-65 Shale, gray

7 CONTRACTOR'S OR LANDOWNER'S CERTIFICATION: This water well was [X] constructed, [] reconstructed, or [] plugged under my jurisdiction and was completed on (mo/day/year) 3/13/12 and this record is true to the best of my knowledge and belief.

INSTRUCTIONS: Use typewriter or ball point pen. PLEASE PRESS FIRMLY and PRINT clearly. Please fill in blanks and check the correct answers. Send three copies (white, blue, pink) to Kansas Department of Health and Environment, Bureau of Water, Geology Section, 1000 SW Jackson St., Suite 420, Topeka, Kansas 66612-1367.