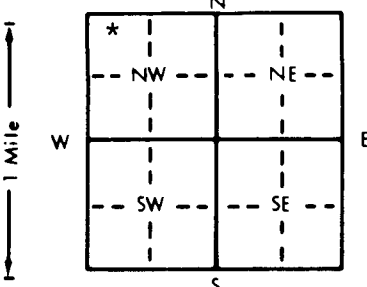


1 LOCATION OF WATER WELL: Fraction NW 1/4 NW 1/4 NW 1/4 Section Number 21 Township Number T 13 S Range Number R 1 E/W  
 County: Dickinson

Distance and direction from nearest town or city street address of well if located within city?  
 2 miles East & 1/4 mile South of Solomon, Kansas

2 WATER WELL OWNER: Dorothy Montgomery  
 RR#, St. Address, Box #: Rt 2, Box 278 Board of Agriculture, Division of Water Resources  
 City, State, ZIP Code: Chapman, Kansas 67431 Application Number:

3 LOCATE WELL'S LOCATION WITH AN "X" IN SECTION BOX:  4 DEPTH OF COMPLETED WELL: 56 ft. ELEVATION:  
 Depth(s) Groundwater Encountered 1. 4.7 ft. 2. ft. 3. ft.  
 WELL'S STATIC WATER LEVEL 1.6 ft. below land surface measured on mo/day/yr 3 / 17 / 95  
 Pump test data: Well water was ft. after hours pumping gpm  
 Est. Yield 15+ gpm: Well water was ft. after hours pumping gpm  
 Bore Hole Diameter 9 in. to 5.6 ft., and in. to ft.  
 WELL WATER TO BE USED AS: 5 Public water supply 8 Air conditioning 11 Injection well  
 1 Domestic 3 Feedlot 6 Oil field water supply 9 Dewatering 12 Other (Specify below)  
 2 Irrigation 4 Industrial 7 Lawn and garden only 10 Monitoring well  
 Was a chemical/bacteriological sample submitted to Department? Yes No \*; If yes, mo/day/yr sample was submitted  
 Water Well Disinfected? Yes \* No

5 TYPE OF BLANK CASING USED: 5 Wrought iron 8 Concrete tile CASING JOINTS: Glued \* Clamped  
 1 Steel 3 RMP (SR) 6 Asbestos-Cement 9 Other (specify below) Welded  
 2 PVC 4 ABS 7 Fiberglass Threaded  
 Blank casing diameter 5 in. to 5.6 ft., Dia in. to ft., Dia in. to ft.  
 Casing height above land surface 2.0 in., weight 16.0 lbs./ft. Wall thickness or gauge No. 214  
 TYPE OF SCREEN OR PERFORATION MATERIAL: 7 PVC 10 Asbestos-cement  
 1 Steel 3 Stainless steel 5 Fiberglass 8 RMP (SR) 11 Other (specify)  
 2 Brass 4 Galvanized steel 6 Concrete tile 9 ABS 12 None used (open hole)  
 SCREEN OR PERFORATION OPENINGS ARE: 5 Gauzed wrapped 8 Saw cut 11 None (open hole)  
 1 Continuous slot 3 Mill slot 6 Wire wrapped 9 Drilled holes  
 2 Louvered shutter 4 Key punched 7 Torch cut 10 Other (specify)  
 SCREEN-PERFORATED INTERVALS: From 4.7 ft. to 5.6 ft., From ft. to ft.  
 From ft. to ft., From ft. to ft.  
 GRAVEL PACK INTERVALS: From 2.6 ft. to 5.6 ft., From ft. to ft.  
 From ft. to ft., From ft. to ft.

6 GROUT MATERIAL: 1 Neat cement 2 Cement grout 3 Bentonite 4 Other  
 Grout Intervals: From 3 ft. to 2.6 ft., From ft. to ft., From ft. to ft.  
 What is the nearest source of possible contamination:  
 1 Septic tank 4 Lateral lines 7 Pit privy 10 Livestock pens 14 Abandoned water well  
 2 Sewer lines 5 Cess pool 8 Sewage lagoon 11 Fuel storage 15 Oil well/Gas well  
 3 Watertight sewer lines 6 Seepage pit 9 Feedyard 12 Fertilizer storage 16 Other (specify below)  
 13 Insecticide storage  
 Direction from well? WEST WILL BE APPROX How many feet? 125

FROM	TO	LITHOLOGIC LOG	FROM	TO	PLUGGING INTERVALS
0	1	DARK CLAY			
1	8	BROWN CLAY			
8	10	BROWN SANDY CLAY			
10	13	FINE SAND			
13	29	CLAY BROWN SANDY			
29	34	FINE SAND			
34	36	BROWN CLAY			
36	43	FINE SAND			
43	49	SAND			
49	54	CLAY LITE COLOR			
54	56	GRAY & RED CLAY			

7 CONTRACTOR'S OR LANDOWNER'S CERTIFICATION: This water well was (1) constructed, (2) reconstructed, or (3) plugged under my jurisdiction and was completed on (mo/day/year) 3 / 17 / 95 and this record is true to the best of my knowledge and belief. Kansas  
 Water Well Contractor's License No. 397 This Water Well Record was completed on (mo/day/yr) 3 / 26 / 95  
 under the business name of CENTRAL KANSAS DRILLING by (signature) Harold D. Martin

INSTRUCTIONS: Use typewriter or ball point pen, PLEASE PRESS FIRMLY and PRINT clearly. Please fill in blanks, underline or circle the correct answers. Send top three copies to Kansas Department of Health and Environment, Bureau of Water, Topeka, Kansas 66620-0001. Telephone: 913-296-5545. Send one to WATER WELL OWNER and retain one for your records.

000460

OFFICE USE ONLY  
T  
R  
EW  
SEC  
1/4  
1/4  
1/4