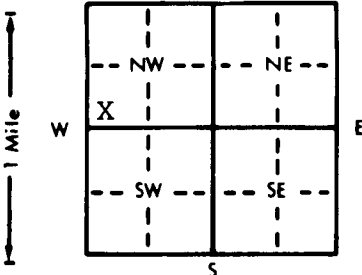


1 LOCATION OF WATER WELL:		Fraction		Section Number		Township Number		Range Number			
County: <u>WABAUNSEE</u>		<u>SW</u> $\frac{1}{4}$ <u>SW</u> $\frac{1}{4}$ <u>NW</u> $\frac{1}{4}$		<u>28</u>		<u>T</u> <u>13</u> <u>S</u>		<u>R</u> <u>11</u> <u>E/W</u>			
Distance and direction from nearest town or city street address of well if located within city? <u>1 1/2 miles south of Hessdale</u>											
2 WATER WELL OWNER: <u>David Breiner</u>											
RR#, St. Address, Box #: <u>Rt. 2 Box 158</u>											
City, State, ZIP Code: <u>Alma, KS 66401</u>											
Board of Agriculture, Division of Water Resources Application Number:											
3 LOCATE WELL'S LOCATION WITH AN "X" IN SECTION BOX:		4 DEPTH OF COMPLETED WELL: <u>47</u> ft. ELEVATION:									
		Depth(s) Groundwater Encountered 1. ft. 2. ft. 3. ft.									
		WELL'S STATIC WATER LEVEL <u>18'</u> ft. below land surface measured on mo/day/yr <u>11/04/99</u>									
		Pump test data: Well water was ft. after hours pumping gpm									
		Est. Yield <u>10</u> gpm: Well water was ft. after hours pumping gpm									
		Bore Hole Diameter <u>10</u> in. to ft., and in. to ft.									
		WELL WATER TO BE USED AS:									
		5 Public water supply 8 Air conditioning 11 Injection well									
		<u>1 Domestic</u> 3 Feedlot 6 Oil field water supply 9 Dewatering 12 Other (Specify below)									
		2 Irrigation 4 Industrial 7 Lawn and garden only 10 Monitoring well									
		Was a chemical/bacteriological sample submitted to Department? Yes.....No..... <u>X</u> ; If yes, mo/day/yr sample was submitted									
		Water Well Disinfected? Yes <u>X</u> No									
5 TYPE OF BLANK CASING USED:											
1 Steel 3 RMP (SR) 5 Wrought iron 8 Concrete tile CASING JOINTS: Glued <u>X</u> Clamped											
<u>2 PVC</u> 4 ABS 6 Asbestos-Cement 9 Other (specify below) Welded											
7 Fiberglass Threaded											
Blank casing diameter <u>5"</u> in. to <u>0-14</u> ft., Dia <u>5"</u> in. to <u>34-46</u> ft., Dia in. to ft.											
Casing height above land surface <u>24"</u> in., weight <u>2.82</u> lbs./ft. Wall thickness or gauge No. <u>258</u>											
TYPE OF SCREEN OR PERFORATION MATERIAL:											
1 Steel 3 Stainless steel 5 Fiberglass 8 RMP (SR) 10 Asbestos-cement											
2 Brass 4 Galvanized steel 6 Concrete tile 9 ABS 11 Other (specify)											
12 None used (open hole)											
SCREEN OR PERFORATION OPENINGS ARE:											
5 Gauzed wrapped 8 Saw cut 11 None (open hole)											
1 Continuous slot 3 Mill slot 6 Wire wrapped 9 Drilled holes											
2 Louvered shutter 4 Key punched 7 Torch cut 10 Other (specify)											
SCREEN-PERFORATED INTERVALS: From <u>14</u> ft. to <u>34</u> ft., From ft. to ft.											
From <u>46</u> ft. to <u>47</u> ft., From ft. to ft.											
GRAVEL PACK INTERVALS: From <u>13</u> ft. to <u>47</u> ft., From ft. to ft.											
From ft. to ft., From ft. to ft.											
6 GROUT MATERIAL: 1 Neat cement 2 Cement grout * <u>3 Bentonite</u> 4 Other											
Grout Intervals: From <u>0</u> ft. to <u>13</u> ft., From ft. to ft., From ft. to ft.											
What is the nearest source of possible contamination:											
1 Septic tank 4 Lateral lines 7 Pit privy 10 Livestock pens 14 Abandoned water well											
2 Sewer lines 5 Cess pool 8 Sewage lagoon 11 Fuel storage 15 Oil well/Gas well											
3 Watertight sewer lines 6 Seepage pit 9 Feedyard 12 Fertilizer storage 16 Other, (specify below)											
13 Insecticide storage <u>creek</u>											
Direction from well? <u>WEST</u> How many feet? <u>80'</u>											
FROM		TO		LITHOLOGIC LOG		FROM		TO		PLUGGING INTERVALS	
0		3		Top Soil							
3		13		Clay-Brown						* NOTE: Permission to shallow	
13		26		Chert Gravel $\frac{1}{4} \times \frac{1}{2}$						grout from Don Taylor	
26		29		Shale-Grey						11/09/99	
29		30		Limestone-Grey							
30		35		Shale-Yellow							
35		42		Shale-Grey							
42		47		Limestone-Grey							
7 CONTRACTOR'S OR LANDOWNER'S CERTIFICATION: This water well was (1) <u>constructed</u> , (2) reconstructed, or (3) plugged under my jurisdiction and was completed on (mo/day/year) <u>11/04/99</u> and this record is true to the best of my knowledge and belief. Kansas											
Water Well Contractor's License No. <u>182</u> This Water Well Record was completed on (mo/day/yr) <u>11-3-99</u>											
under the business name of <u>STRADER DRILLING CO., INC.</u> by (signature) <u>Dale Askren</u>											
INSTRUCTIONS: Use typewriter or ball point pen. PLEASE PRESS FIRMLY and PRINT clearly. Please fill in blanks, underline or circle the correct answers. Send top three copies to Kansas Department of Health and Environment, Bureau of Water, Topeka, Kansas 66620-0001. Telephone: 913-296-5545. Send one to WATER WELL OWNER and retain one for your records.											