

CORRECTION TO WATER WELL RECORD (WWC-5)

The following correction(s) was made to the attached WWC-5 log, in order to file the item or to rectify lacking or incorrect information.

Fraction (1/4 1/4 1/4) Section-Township-Range changed:

listed as SW SE NE, 25

changed to SW SE NE, 25-13S-11E

Other changes: Initial statements: _____

Changed to: _____

Comments: Written directions originate in Eskridge.

verification method: Phone call to well driller, and Eskridge,

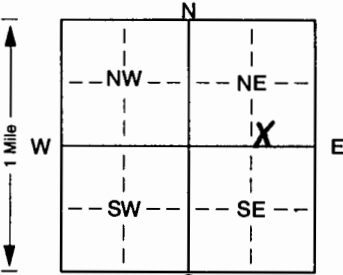
Lake Wabaunsee, & Hessdale 1:24,000 topo. maps, initials: DRD date: 5/16/2001

submitted by: Kansas Geological Survey, Data Resources Library, 1930 Constant Ave., Lawrence, KS 66047-3726
to: Kansas Dept of Health & Environment Bureau of Water Industrial Programs, Bldg 283, Forbes Field, KS 66620

1 LOCATION OF WATER WELL: Fraction SW 1/4 SE 1/4 NE 1/4 Section Number 25 Township Number T Range Number S R EW

Distance and direction from nearest town or city street address of well if located within city?
1/4 MILES WEST AND 2 MILES NORTH

2 WATER WELL OWNER: MICHAEL STUBBS
 RR#, St. Address, Box #: P.O. BOX 5040 Board of Agriculture, Division of Water Resources
 City, State, ZIP Code: SANTA BARBARA, CA 93150 Application Number: _____

3 LOCATE WELL'S LOCATION WITH AN "X" IN SECTION BOX:

 4 DEPTH OF COMPLETED WELL: 207 ft. ELEVATION: _____
 Depth(s) Groundwater Encountered 1. 119 ft. 2. _____ ft. 3. _____ ft.
 WELL'S STATIC WATER LEVEL: 115 ft. below land surface measured on mo/day/yr _____
 Pump test data: Well water was _____ ft. after _____ hours pumping _____ gpm
 Est. Yield: 34 gpm; Well water was _____ ft. after _____ hours pumping _____ gpm
 Bore Hole Diameter: 8.75 in. to 207 ft., and _____ in. to _____ ft.
 WELL WATER TO BE USED AS:
 1 Domestic 3 Feedlot 6 Oil field water supply 9 Dewatering 12 Other (Specify below)
 2 Irrigation 4 Industrial 7 Domestic (lawn & garden) 10 Monitoring well
 Was a chemical/bacteriological sample submitted to Department? Yes _____ No X; If yes, mo/day/yr sample was submitted Water Well Disinfected? Yes X No _____

5 TYPE OF BLANK CASING USED:
 1 Steel 3 RMP (SR) 5 Wrought iron 8 Concrete tile CASING JOINTS: Glued X Clamped _____
 2 PVC 4 ABS 6 Asbestos-Cement 9 Other (specify below) Welded _____
 3 Fiberglass Threaded _____
 Blank casing diameter: 5 in. to 107 ft., Dia. 5 in. to 107 ft., Dia. _____ in. to _____ ft.
 Casing height above land surface: 10 in., weight _____ lbs./ft. Wall thickness or gauge No. SDR 26
 TYPE OF SCREEN OR PERFORATION MATERIAL:
 1 Steel 3 Stainless steel 5 Fiberglass 8 RMP (SR) 10 Asbestos-cement
 2 Brass 4 Galvanized steel 6 Concrete tile 9 ABS 11 Other (specify) _____
 12 None used (open hole)
 SCREEN OR PERFORATION OPENINGS ARE:
 1 Continuous slot 3 Mill slot .030 5 Gauzed wrapped 8 Saw cut 11 None (open hole)
 2 Louvered shutter 4 Key punched 6 Wire wrapped 9 Drilled holes
 7 Torch cut 10 Other (specify) _____ ft.
 SCREEN-PERFORATED INTERVALS: From 107 ft. to 117 ft., From _____ ft. to _____ ft.
 From 177 ft. to 207 ft., From _____ ft. to _____ ft.
 GRAVEL PACK INTERVALS: From 25 ft. to 207 ft., From _____ ft. to _____ ft.
 From _____ ft. to _____ ft., From _____ ft. to _____ ft.

6 GROUT MATERIAL: 1 Neat cement 2 Cement grout 3 Bentonite 4 Other _____
 Grout intervals: From 0 ft. to 25 ft., From _____ ft. to _____ ft., From _____ ft. to _____ ft.
 What is the nearest source of possible contamination:
 1 Septic tank 4 Lateral lines 7 Pit privy 10 Livestock pens 14 Abandoned water well
 2 Sewer lines 5 Cess pool 8 Sewage lagoon 11 Fuel storage 15 Oil well/Gas well
 3 Watertight sewer lines 6 Seepage pit 9 Feedyard 12 Fertilizer storage 16 Other (specify below) BARN
 13 Insecticide storage
 Direction from well? SOUTH How many feet? 100 PLUS

FROM	TO	LITHOLOGIC LOG	FROM	TO	PLUGGING INTERVALS
0	4	LIMESTONE, WHITE	115	119	LIMESTONE, YELLOW
4	5	SHALE, GRAY	119	132	SHALE, TAN
5	7	LIMESTONE	132	136	LIMESTONE, FRACTURED
7	17	SHALE, VARIOUS COLORS	136	145	SHALE, GRAY
17	21	LIMESTONE	145	151	LIMESTONE, GRAY
21	34	SHALE, GRAY	151	170	SHALE, GRAY
34	36	LIMESTONE	170	174	LIMESTONE, MOTTLED TAN/GRAY
36	40	SHALE, GRAY	174	189	SHALE
40	41	LIMESTONE	189	193	LIMESTONE, LIGHT WHITE
41	60	SHALE	193	207	SHALE, GRAY
60	65	LIMESTONE, YELLOW		207	TOTAL DEPTH
65	71	SHALE, GRAY			
71	79	LIMESTONE, TAN			
79	115	SHALE, TAN			

7 CONTRACTOR'S OR LANDOWNER'S CERTIFICATION: This water well was constructed, reconstructed, or plugged under my jurisdiction and was completed on (mo/day/year) 1/23/01 and this record is true to the best of my knowledge and belief. Kansas Water Well Contractor's Licence No. 585 This Water Well Record was completed on (mo/day/yr) 2/18/01 under the business name of Assoc. Environmental Inc by (signature) [Signature]