

80

Hosdale

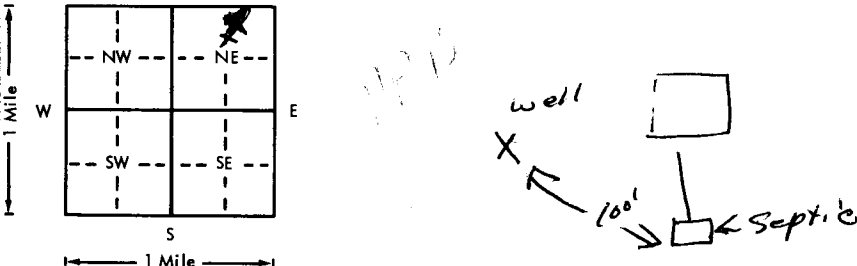
USE TYPEWRITER OR BALL
POINT PEN-PRESS FIRMLY,
PRINT CLEARLY.

WATER WELL RECORD
KSA 82a-1201-1215

Kansas Department of Health and
Environment-Division of Environment
(Water well Contractors)
Topeka, Kansas 66620

1. Location of well: County Labawunsee Fraction SW 1/4 NE 1/4 NE 1/4 Section number 9 Township number T 13 S Range number R 11 E QW

2. Distance and direction from nearest town or city: 2 N 3/4 E 3. Owner of well: Hugo. O. Saffery
Street address of well location if in city: Hosdale R.R. or street: Rt. 2
City, state, zip code: Alma, Kansas 66401

4. Locate with "X" in section below: Sketch map: 

6. Bore hole dia. 8 in. Completion date 10-6-77
Well depth 80 ft.

7. ☐ Cable tool ☒ Rotary ☐ Driven ☐ Dug
☐ Hollow rod ☐ Jetted ☐ Bored ☐ Reverse rotary

8. Use: ☒ Domestic ☐ Public supply ☐ Industry
☐ Irrigation ☐ Air conditioning ☐ Stock
☐ Lawn ☐ Oil field water ☐ Other

9. Casing: Material PVC Height Above or below
Threaded ☐ Welded ☐ Surface 24 in.
RMP PVC BLUE Weight 2.74 lbs./ft.
Dia. 5 in. to 30 ft. depth Wall Thickness: inches or
Dia. 5 in. to 30 ft. depth gage No. 258

10. Screen: Manufacturer's name Pumpco
Type PVC Dia. 5
Slot/gauze 080 Length 20
Set between 40 ft. and 60 ft.
Gravel pack? YES Size range of material 1/4 x 1/4

11. Static water level: 45 ft. below land surface Date 10-6-77 mo./day/yr.

12. Pumping level below land surfaces: 12 ft. after 0 hrs. pumping 12 g.p.m.
12 ft. after 0 hrs. pumping 12 g.p.m.
Estimated maximum yield 12 g.p.m.

13. Water sample submitted: YES ☒ Yes ☐ No Date 10-6-77 mo./day/yr.

14. Well head completion: Topcap
0 Pitless adapter 24 inches above grade

15. Well grouted? YES
With: ☒ Neat cement ☐ Bentonite ☐ Concrete
Depth: From 0 ft. to 10 ft.

16. Nearest source of possible contamination: 100 ft. Direction SE Type septic
Well disinfected upon completion? ☒ Yes ☐ No

17. Pump: ☒ Not installed
Manufacturer's name _____
Model number _____ HP _____ Volts _____
Length of drop pipe _____ ft. capacity _____ g.p.m.
Type: ☐ Submersible ☐ Turbine
☐ Jet ☐ Reciprocating
☐ Centrifugal ☐ Other

18. Elevation: 1209
Topography: ☒ Hill ☐ Slope ☐ Upland ☐ Valley

19. Remarks: owner to pour cement slab

20. Water well contractor's certification:
This well was drilled under my jurisdiction and this report
is true to the best of my knowledge and belief.
STRADER DAIG Co Inc. 182
Business name License No. _____
Address Holtan, KS
Signed Dale C. Strader Date 10-27-77
Authorized representative

Forward the white, blue and pink copies to the Department of Health and Environment

Form WWC-5