


1 LOCATION OF WATER WELL: Fraction NW $\frac{1}{4}$ $\frac{1}{4}$ Section Number 31 Township Number 13 Range Number 13E
 County: Wabaunsee

Distance and direction from nearest town or city street address of well if located within city?

2 WATER WELL OWNER: TOMAS CLEMENTS
 RR #, St. Address, Box #: RR 1 Box 37A Board of Agriculture, Division of Water Resources
 City, State, ZIP Code: ESK RIDGE, KS 66432 Application Number:

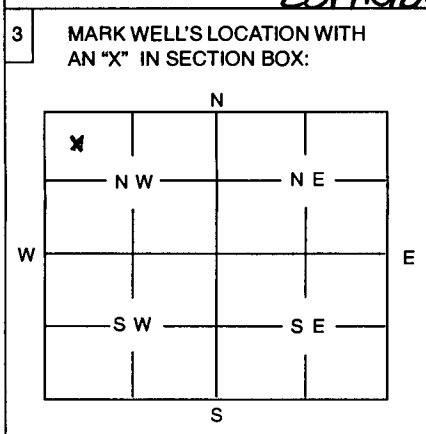

4 DEPTH OF WELL 12 ft
 WELL'S STATIC WATER LEVEL 2 ft.
 WELL WAS USED AS:
 1 Domestic 5 Public Water Supply 9 Dewatering
 2 Irrigation 6 Oil Field Water Supply 10 Monitoring Well
 3 Feedlot 7 Domestic (Lawn & Garden) 11 Injection Well
 4 Industrial 8 Air Conditioning 12 Other
 Was a chemical / bacteriological sample submitted to Department? Yes No
 If yes, mo/day/yr sample was submitted
 Water Well Disinfected: Yes No

5 TYPE OF BLANK CASING USED:
 1 Steel 3 RMP (SR) 5 Wrought 7 Fiberglass 9 Other (Specify below) hand dug 4'
 2 PVC 4 ABS 6 Asbestos-Cement 8 Concrete Tile
 Blank casing diameter in. Was casing pulled? Yes No If yes, how much
 Casing height above or below land surface in.

6 GROUT PLUG MATERIAL: 1 Neat cement 2 Cement grout 3 Bentonite 4 Other
 Grout Plug Intervals: From ft. to ft., From ft. to ft., From to ft.
 What is the nearest source of possible contamination:
 1 Septic tank 6 Seepage pit 11 Fuel storage 16 Other (specify below)
 2 Sewer lines 7 Pit privy 12 Fertilizer storage
 3 Watertight sewer lines 8 Sewage lagoon 13 Insecticide storage
 4 Lateral lines 9 Feedyard 14 Abandoned water well
 5 Cess Pool 10 Livestock pens 15 Oil well/Gas well
 Direction from well? WEST How many feet?

FROM	TO	PLUGGING MATERIALS
<u>7 1/2'</u>	<u>12'</u>	<u>fill dirt</u>
<u>4'</u>	<u>7 1/2'</u>	<u>Bentonite</u>
<u>3'</u>	<u>4'</u>	<u>fill dirt</u>
<u>0'</u>	<u>3'</u>	<u>washed gravel</u>
<u>0'</u>		<u>clorox</u>

7 CONTRACTOR'S OR LANDOWNER'S CERTIFICATION: This water well was plugged under my jurisdiction and was completed on (mo/day/year) 10-31-01 and this record is true to the best of my knowledge and belief. Kansas Water Well Contractor's License No. This Water Well Record was completed on (mo/day/year)
 under the business name of Bob's Backhoe Service
 by (signature) Bob [Signature]

INSTRUCTIONS: Use typewriter or ball point pen. Please press firmly and print clearly. Please fill in blanks, underline or circle the correct answers. Send top three copies to Kansas Department of Health and Environment, Bureau of Water, Topeka, Kansas 66620-0001. Telephone: 785/296-3565. Send one to Water Well Owner and retain one for your records.