

223

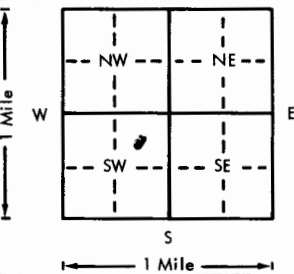
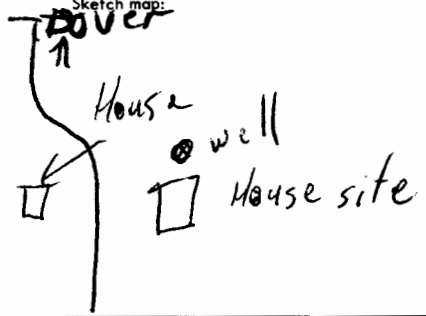
loc  
15/8/8

ACD

USE TYPEWRITER OR BALL POINT PEN-PRESS FIRMLY, PRINT CLEARLY.

WATER WELL RECORD  
KSA 82a-1201-1215

Kansas Department of Health and Environment-Division of Environment (Water well Contractors) Topeka, Kansas 66620

1. Location of well: County <u>Shawnee</u>		Fraction <u>SW NW NE</u> <u>SE 1/4 1/4 SW 1/4</u>		Section number <u>11</u>		Township number <u>T 13 S</u>		Range number <u>R 13 E</u>	
2. Distance and direction from nearest town or city: <u>1 1/2 m south of Dover.</u>				3. Owner of well: <u>Mike Welborn</u> R.R. or street: <u>3621 Madison</u> City, state, zip code: <u>Topeka, KS 66685</u>					
X Locate with "X" in section below: 				Sketch map: 				6. Bore hole dia. <u>7</u> in. Completion date <u>May 1-76</u> Well depth <u>128</u> ft.	
				7. <input checked="" type="checkbox"/> Cable tool <input type="checkbox"/> Rotary <input type="checkbox"/> Driven <input type="checkbox"/> Dug <input type="checkbox"/> Hollow rod <input type="checkbox"/> Jetted <input type="checkbox"/> Bored <input type="checkbox"/> Reverse rotary					
				8. Use: <input checked="" type="checkbox"/> Domestic <input type="checkbox"/> Public supply <input type="checkbox"/> Industry <input type="checkbox"/> Irrigation <input type="checkbox"/> Air conditioning <input type="checkbox"/> Stock <input type="checkbox"/> Lawn <input type="checkbox"/> Oil field water <input type="checkbox"/> Other					
				9. Casing: Material <u>PITS</u> Height: Above or below Threaded <input type="checkbox"/> Welded <input type="checkbox"/> Surface <u>24</u> in. RMP <input checked="" type="checkbox"/> PVC <input type="checkbox"/> Weight <input type="checkbox"/> lbs./ft. Dia. <u>5</u> in. to <u>128</u> ft. depth Wall Thickness: inches or Dia. <input type="checkbox"/> in. to <input type="checkbox"/> ft. depth Gauge No. <u>200</u>					
5. Type and color of material				From		To		10. Screen: Manufacturer's name <u>Jesse Lowell</u> <u>200</u>	
<u>Clay &amp; Broken lime</u>				<u>0</u>		<u>15</u>		Type <u>RMP</u> Dia. <u>5"</u>	
<u>Shale grey sandy</u>				<u>15</u>		<u>25</u>		Slot/gauze <u>3/16</u> Length <u>113</u>	
<u>Shale grey</u>				<u>25</u>		<u>35</u>		Set between <u>15</u> ft. and <u>128</u> ft.	
<u>Lime L grey</u>				<u>35</u>		<u>37</u>		Gravel pack? <u>No</u> Size range of material <input type="checkbox"/>	
<u>shale grey sticky</u>				<u>37</u>		<u>42</u>		11. Static water level: <input type="checkbox"/> mo./day/yr. <u>17</u> ft. below land surface Date <u>May 1-76</u>	
<u>Lime Grey M</u>				<u>42</u>		<u>43</u>		12. Pumping level below land surfaces: <input type="checkbox"/> ft. after <input type="checkbox"/> hrs. pumping <input type="checkbox"/> g.p.m. <input type="checkbox"/> ft. after <input type="checkbox"/> hrs. pumping <input type="checkbox"/> g.p.m. Estimated maximum yield <u>8-10 GPH</u> g.p.m.	
<u>shale</u>				<u>43</u>		<u>58</u>		13. Water sample submitted: <input type="checkbox"/> mo./day/yr. <input checked="" type="checkbox"/> Yes <input type="checkbox"/> No Date <input type="checkbox"/>	
<u>Lime Grey M</u>				<u>58</u>		<u>66</u>		14. Well head completion: <input type="checkbox"/> Pitless adapter <u>24</u> Inches above grade	
<u>Shale sandy</u>				<u>66</u>		<u>102</u>		15. Well grouted? <u>yes</u> With: <input checked="" type="checkbox"/> cement <input type="checkbox"/> Bentonite <input type="checkbox"/> Concrete Depth: From <u>0</u> ft. to <u>15</u> ft.	
<u>Shale &amp; sand stone</u>				<u>102</u>		<u>128</u>		16. Nearest source of possible contamination: ft. <u>100+</u> Direction <input type="checkbox"/> Type <u>Septic</u> Well disinfected upon completion? <input checked="" type="checkbox"/> Yes <input type="checkbox"/> No	
								17. Pump: <input checked="" type="checkbox"/> Not installed Manufacturer's name <input type="checkbox"/> Model number <input type="checkbox"/> HP <input type="checkbox"/> Volts <input type="checkbox"/> Length of drop pipe <input type="checkbox"/> ft. capacity <input type="checkbox"/> g.p.m. Type: <input type="checkbox"/> Submersible <input type="checkbox"/> Turbine <input type="checkbox"/> Jet <input type="checkbox"/> Reciprocating <input type="checkbox"/> Centrifugal <input type="checkbox"/> Other	
(Use a second sheet if needed)									
18. Elevation: <u>1246</u>		19. Remarks: <u>Owner to install slab</u>							
Topography: <u>Rm</u> <input type="checkbox"/> Hill <input type="checkbox"/> Slope <input type="checkbox"/> Upland <input type="checkbox"/> Valley		20. Water well contractor's certification: This well was drilled under my jurisdiction and this report is true to the best of my knowledge and belief. <u>Robison D. King</u> 316A Business name <u>Perry KS</u> License No. <u>1/4 1/4 1/4</u> Address <u>Perry KS</u> Signed <u>Jack Johnson</u> Date <u>1-19-80</u> Authorized representative							

13 130 11 Sec 11

Forward the white, blue and pink copies to the Department of Health and Environment

Form WW6-5