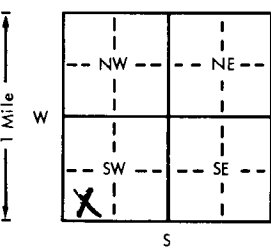
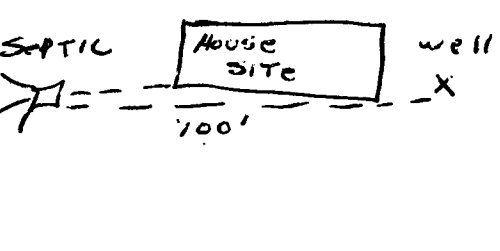


1. Location of well: Wabaunsee		County CCC		Fraction SW 1/4 SW 1/4 SW 1/4		Section number 34		Township number T 13 S 13 R 13		Range number 13							
2. Distance and direction from nearest town or city: 5 N of						3. Owner of well: Bob Logan											
Street address of well location if in city: Harveyville, KS.						R.R. or street: RR											
						City, state, zip code: Harveyville, Kansas 66431											
4. Locate with "X" in section below: 						Sketch map: 						6. Bore hole dia. 8 in. Completion date Well depth 118 ft. 9-20-79					
5. Type and color of material						7. <input checked="" type="checkbox"/> Cable tool <input type="checkbox"/> Rotary <input type="checkbox"/> Driven <input type="checkbox"/> Dug <input type="checkbox"/> Hollow rod <input type="checkbox"/> Jetted <input type="checkbox"/> Bored <input type="checkbox"/> Reverse rotary											
						8. Use: <input checked="" type="checkbox"/> Domestic <input type="checkbox"/> Public supply <input type="checkbox"/> Industry <input type="checkbox"/> Irrigation <input type="checkbox"/> Air conditioning <input type="checkbox"/> Stock <input type="checkbox"/> Lawn <input type="checkbox"/> Oil field water <input type="checkbox"/> Other											
						9. Casing: Material PVC Height: Above or below Threaded <input type="checkbox"/> Welded <input checked="" type="checkbox"/> Surface 24 in. RMP <input type="checkbox"/> PVC <input checked="" type="checkbox"/> Weight 282 lbs./ft. Dia. 5 in. to 118 ft. depth Wall Thickness: inches or Dia. <input type="checkbox"/> in. to <input type="checkbox"/> ft. depth Gauge No. 350											
						10. Screen: Manufacturer's name PUMPCO MPI Type PVC Dia. 5 Slot/gauze 1060 Length 60 Set between 30 ft. and 90 ft. Gravel pack? <input checked="" type="checkbox"/> Size range of material 1/4 x 1/8											
Top Soil						6		3		11. Static water level: 35 ft. below land surface Date 9-20-79							
Clay, brown						3		20		12. Pumping level below land surfaces: ____ ft. after ____ hrs. pumping ____ g.p.m. ____ ft. after ____ hrs. pumping ____ g.p.m. Estimated maximum yield 1.5 AT 36' g.p.m.							
Sandstone, water bearing						20		36		13. Water sample submitted: Yes <input checked="" type="checkbox"/> No <input type="checkbox"/> Date ____							
Shale, grey						36		79		14. Well head completion: CAP ____ Pitless adapter 24 inches above grade							
Limestone, grey						79		82		15. Well grouted? <input checked="" type="checkbox"/> With: <input checked="" type="checkbox"/> Neat cement <input type="checkbox"/> Bentonite <input type="checkbox"/> Concrete Depth: From 0 ft. to 10 ft.							
Shale, grey						82		118		16. Nearest source of possible contamination: ft. 100 Direction W Type SEPTIC Well disinfected upon completion? <input checked="" type="checkbox"/> Yes <input type="checkbox"/> No							
										17. Pump: <input checked="" type="checkbox"/> Not installed Manufacturer's name _____ Model number _____ HP _____ Volts _____ Length of drop pipe _____ ft. capacity _____ g.p.m. Type: <input type="checkbox"/> Submersible <input type="checkbox"/> Turbine <input type="checkbox"/> Jet <input type="checkbox"/> Reciprocating <input type="checkbox"/> Centrifugal <input type="checkbox"/> Other							
										18. Elevation: 1280							
										19. Remarks: owner to install slab							
										20. Water well contractor's certification: This well was drilled under my jurisdiction and this report is true to the best of my knowledge and belief. STRADER DRUG CO INC 182 Business name License No. Address RT1 HOLTON, KS Signed Dale Barker Date 4-23-80 Authorized representative							