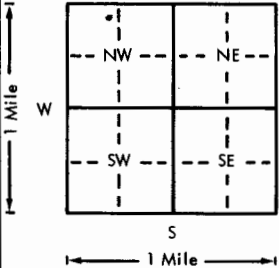
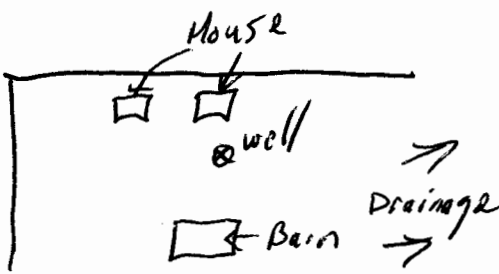


USE TYPEWRITER OR BALL POINT PEN-PRESS FIRMLY, PRINT CLEARLY.

WATER WELL RECORD
KSA 82a-1201-1215

Kansas Department of Health and Environment-Division of Environment
(Water well Contractors)
Topeka, Kansas 66620

1. Location of well:		County Shawnee	Fraction NE 1/4 NW 1/4 NW 1/4	Section number 18	Township number T 13S	Range number S R 14E E/W
2. Distance and direction from nearest town or city: 2 mi South Street address of well location if in city: 1 1/4 E of Dover				3. Owner of well: Eugene Rohlmaier R.R. or street: Rt 7 Topeka, KS 66619 City, state, zip code:		
<input checked="" type="checkbox"/> Locate with "X" in section below: 		Sketch map: 			Bore hole dia. 7 in. Completion date May 17 76 Well depth 131 ft.	
5. Type and color of material		From	To	7. <input checked="" type="checkbox"/> Cable tool <input type="checkbox"/> Rotary <input type="checkbox"/> Driven <input type="checkbox"/> Dug <input type="checkbox"/> Hollow rod <input type="checkbox"/> Jetted <input type="checkbox"/> Bored <input type="checkbox"/> Reverse rotary		
Soil		0	2	8. Use: <input checked="" type="checkbox"/> Domestic <input type="checkbox"/> Public supply <input type="checkbox"/> Industry <input type="checkbox"/> Irrigation <input type="checkbox"/> Air conditioning <input type="checkbox"/> Stock <input type="checkbox"/> Lawn <input type="checkbox"/> Oil field water <input type="checkbox"/> Other		
Clay yellow		2	14	9. Casing: Material PITS Height: Above or below Threaded <input type="checkbox"/> Welded <input type="checkbox"/> Surface 12 in. RMP <input checked="" type="checkbox"/> PVC <input type="checkbox"/> Weight _____ lbs./ft. Dia. 5 in. to 131 ft. depth Wall Thickness: inches or Dia. _____ in. to _____ ft. depth gage No. 200		
Shale grey		14	45	10. Screen: Manufacturer's name Jess & Livell 200 Type RMP Dia. 5 Slot/gauze 3/16 Length 115 Set between 15 ft. and 130 ft. _____ ft. and _____ ft. Gravel pack? No Size range of material _____		
Lime grey Hard		45	47	11. Static water level: _____ mo./day/yr. 15 ft. below land surface Date May 17 76		
Shale grey		47	53	12. Pumping level below land surfaces: _____ ft. after _____ hrs. pumping _____ g.p.m. _____ ft. after _____ hrs. pumping _____ g.p.m. Estimated maximum yield 10 GPH _____ g.p.m.		
Broken Lime		53	62	13. Water sample submitted: _____ mo./day/yr. Yes <input checked="" type="checkbox"/> No <input type="checkbox"/> Date _____		
Clay Red		62	63	14. Well head completion: <input type="checkbox"/> Pitless adapter 12 Inches above grade		
Shale + Broken Lime		63	83	15. Well grouted? yes With: <input checked="" type="checkbox"/> neat cement <input type="checkbox"/> Bentonite <input type="checkbox"/> Concrete Depth: From 0 ft. to 14 ft.		
Shale very sandy in layers		83	123	16. Nearest source of possible contamination: Barn yard ft. 100 Direction South Type _____ Well disinfected upon completion? <input checked="" type="checkbox"/> Yes <input type="checkbox"/> No		
Shale grey		123	131	17. Pump: Hand Pump installed August Manufacturer's name _____ Model number _____ HP _____ Volts _____ Length of drop pipe 130 ft. capacity _____ g.p.m. Type: <input type="checkbox"/> Submersible <input type="checkbox"/> Turbine <input type="checkbox"/> Jet <input type="checkbox"/> Reciprocating <input type="checkbox"/> Centrifugal Hand Other _____		
18. Elevation: 1206 ft. Topography: <input checked="" type="checkbox"/> Hill <input checked="" type="checkbox"/> Slope <input checked="" type="checkbox"/> Upland <input type="checkbox"/> Valley		19. Remarks: owner to install slab		20. Water well contractor's certification: This well was drilled under my jurisdiction and this report is true to the best of my knowledge and belief. Robison Dr. May 31 76 Business name Perry KS License No. _____ Address _____ Signed Jack Robison Date 8-19-76 Authorized representative		

Forward the white, blue and pink copies to the Department of Health and Environment

Form WWC-5