

58

USE TYPEWRITER OR BALL POINT PEN-PRESS FIRMLY, PRINT CLEARLY.


ACD
WATER WELL RECORD
KSA 82a-1201-1215

T R EW sec 1/4 1/4 1/4 No.

Kansas State Dept. Of Health
(Water Well Contractors)
Forbes-Bldg. 740
Topeka, Kansas 66620

1 Location of well: County Shawnee Township name Auburn Fraction ~~SW 1/4~~ SE 1/4 Section number 30 Town number T135 Range number R14E

Distance and direction from nearest town or city: _____ 3 Owner of well: Stowe, Larry
Street address of well location if in city: _____ Address: RFD. Auburn, Mo

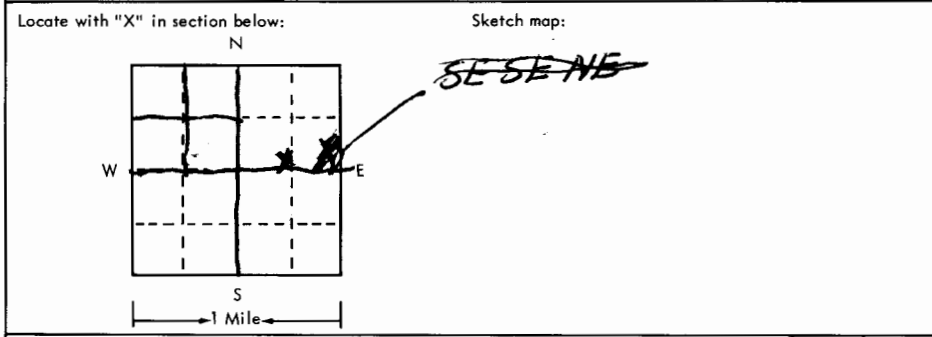

4 Well depth: 62 ft. Date of completion 3/22/75
Well diameter 10 in.

5 Cable tool Rotary Driven Dug
 Hollow rod Jetted Bored Reverse rotary

6 Use: Domestic Public supply Industry
 Irrigation Air conditioning Commercial
 Test well

7 Casing: Material PVC Height: above below
Threaded Welded Surface 36 in.
Diam. 5" Weight _____ lbs./ft. _____
_____ in. to _____ ft. depth Drive shoe? Yes No
_____ in. to _____ ft. depth!

2	Type and color of material	From	To
	Top soil	0	3
	Yellow Clay	3	6
	Sand Rock	6	21
	Break in the Sand Rock	21	21.5
	Sand Rock	21.5	51
	Gray Shale	51	62
	Rock Lime	62	
	Total Depth: 62 Feet		
	Slab to be installed by customer		

8 Screen: Manufacturer Pump Co
Type 200 special Dia. 5"
Slot gauge 1/4 Length 20'
Set between 42 ft. and 62 ft.
Fittings: Gravel pack Yes No Size range of material 1/2

9 Static water level: _____ ft. below land surface Date 3/13/75
4

10 Pumping level below land surfaces:
_____ ft. after _____ hrs. pumping _____ g.p.m.
_____ ft. after _____ hrs. pumping _____ g.p.m.
Estimated maximum yield 3.5 g.p.m.

11 Water sample submitted: Yes No Date _____

12 Well head completion: Pitless adapter 36 inches above grade
 Flush joint

13 Well grouted? Yes No
 Neat cement Bentonite _____
Depth: From 3 ft. to 13 ft.

14 Nearest source of possible contamination:
ft. 25 Direction South Type Druck
Well disinfected upon completion? Yes No

15 Pump: Not installed
Manufacturer's name Gould
Model number 7EH HP 1/2 Volts 230
Length of drop pipe 53 ft. capacity 7 g.p.m.
Type: Submersible Turbine
 Jet Reciprocating
 Centrifugal Other

16 Remarks: elevation 1110 4 FT. Perforations: 20' to 24" Ft.
Topography: Hill Slope Slope to the North
 Upland Valley

17 Water well contractor's certification:
This well was drilled under my jurisdiction and this report is true to the best of my knowledge and belief.
Cummings Drilling 148
Business name BRV 10 License No. _____
Address Shawnee
Signed Theodore Cummings Date 3/22/75
Authorized representative

Forward the white, blue and pink copies to the Kansas State Dept. Of Health.

Form WWC-5

BR = 1112

≡ = 1114