


1 LOCATION OF WATER WELL: Fraction SW 1/4 SW 1/4 SE 1/4 Section Number 06 Township Number T 13 S Range Number R 16 0W

Distance and direction from nearest town or city street address of well if located within city? 400 FT. N of intersection of 3 South and K Streets, Forbes Field

2 WATER WELL OWNER: KDHE/BER RR#, St. Address, Box # : 1000 SW Jackson, Topeka KS 66612-1367 Board of Agriculture, Division of Water Resources Application Number:

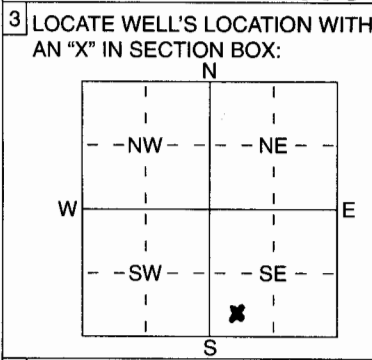

3 LOCATE WELL'S LOCATION WITH AN 'X' IN SECTION BOX: 4 DEPTH OF COMPLETED WELL 13 ft. ELEVATION: 1058.34 TOC

5 TYPE OF BLANK CASING USED: 2 PVC 5 Wrought iron 8 Concrete tile CASING JOINTS: Glued, Clamped, Welded, Threaded X Blank casing diameter 2 in. Dia 8 in. Type of screen or perforation material: 7 PVC SCREEN OR PERFORATION OPENINGS ARE: 8 Saw cut GRAVEL PACK INTERVALS: 6 ft. From 13 ft. From 13 ft. From

6 GROUT MATERIAL: 2 Cement grout 3 Bentonite 4 Other Grout intervals: From 1 ft. to 6 ft. From 0 ft. to 1 ft. Nearest source of possible contamination: 2 Sewer lines Direction from well? E How many feet? 75

FROM	TO	LITHOLOGIC LOG	FROM	TO	PLUGGING INTERVALS
0	1	Topsoil			
1	10	Lean Clay with trace Gravel			
10	12	Fat Clay with sand			
12	13	Limestone			

7 CONTRACTOR'S OR LANDOWNER'S CERTIFICATION: This water well was (1) constructed (2) reconstructed, or (3) plugged under my jurisdiction and was completed on (mo/day/year) 04/21/04 and this record is true to the best of my knowledge and belief. Kansas Water Well Contractor's Licence No 1500 This Water Well Record was completed on (mo/day/yr) 06/13/2004 under the business name of KDHE/BER by (signature) D. J. R. Smith