

USE TYPEWRITER OR BALL POINT PEN-PRESS FIRMLY, PRINT CLEARLY.


WATER WELL RECORD
KSA 82a-1201-1215

T R EW sec 1/4 1/4 1/4 No.

Kansas State Dept. Of Health
(Water Well Contractors)
Forbes-Bldg. 740
Topeka, Kansas 66620

1 Location of well: County Shawnee Township name _____ Fraction SE 1/4 SE 1/4 SE 1/4 Section number 21 Town number T135 Range number R16E

Distance and direction from nearest town or city: _____ 3 Owner of well: Wade, Dan
Street address of well location if in city: _____ Address: 2726 S.E. 93rd Topeka

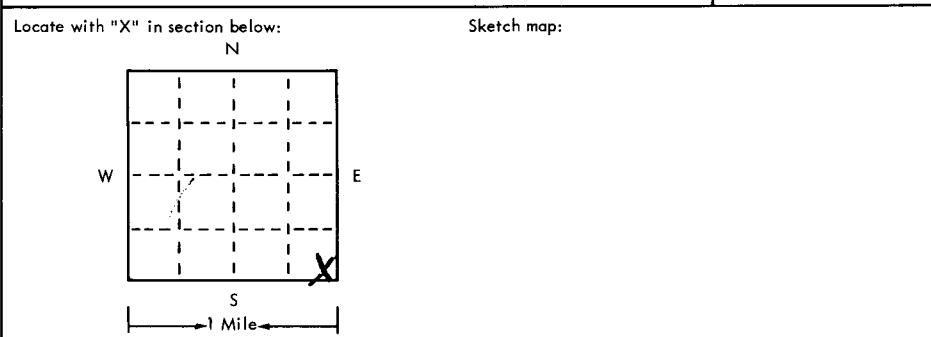

4 Well depth: 80 ft. Date of completion 7/16/75
Well diameter 10 in.

5 Cable tool Rotary Driven Dug
 Hollow rod Jetted Bored Reverse rotary

6 Use: Domestic Public supply Industry
 Irrigation Air conditioning Commercial
 Test well

7 Casing: Material pvc Height: above/below
Threaded Welded Surface 12 in.
Diam. Weight 200 lbs./ft.
___ in. to ___ ft. depth! Drive shoe? Yes No
___ in. to ___ ft. depth!

2	Type and color of material	From	To
	top soil	0	1
	yellow clay with sand	1	5
	lime rock with yellow clay	5	16
	gray shale	16	20
	black shale	20	21
	lime rock	21	24
	gray shale	24	29
	lime rock	29	35
	gray shale	35	36
	yellow lime rock	36	43
	gray shale	43	48
	blue shale	48	80
	total 80 ft.		

8 Screen: Modern
Manufacturer _____
Type p.v.c. Dia. 5
Slot gauze 1/4 Length 20 ft.
Set between 60 ft. and 80 ft. 20
Fittings: _____
Gravel pack Yes No Size range of material 1/2

9 Static water level: 26 ft. below land surface Date _____

10 Pumping level below land surfaces:
___ ft. after ___ hrs. pumping ___ g.p.m.
___ ft. after ___ hrs. pumping ___ g.p.m.
Estimated maximum yield 5 g.p.m./h.

11 Water sample submitted:
 Yes No Date _____

12 Well head completion:
 Pitless adapter Inches above grade

13 Well grouted? Yes No
 Neat cement Bentonite _____
Depth: From 3 ft. to 13 ft.

14 Nearest source of possible contamination:
ft. 70 Direction N.W Type lateral
Well disinfected upon completion? Yes No

15 Pump: Not installed
Manufacturer's name _____
Model number _____ HP _____ Volts _____
Length of drop pipe _____ ft. capacity _____ g.m.p.
Type:
 Submersible Turbine
 Jet Reciprocating
 Centrifugal Other

16 Remarks: elevation 3 ft. perforation ; 30 to 33 ft. slab will be installed by customer

Topography:
 Hill
 Slope
 Upland
 Valley

17 Water well contractor's certification:
This well was drilled under my jurisdiction and this report is true to the best of my knowledge and belief.
Cummins Drilling Co 148
Business name _____ License No. _____
Address 3710 Topeka
Signed Jeanette Cummins Date 9/2/75
Authorized representative

Forward the white, blue and pink copies to the Kansas State Dept. Of Health.

Form WWC-5

BR = 980

≡ = 959