

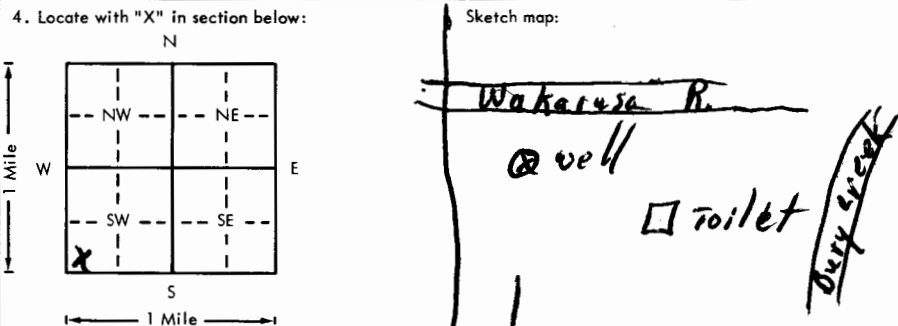
USE TYPEWRITER OR BALL POINT PEN-PRESS FIRMLY, PRINT CLEARLY.

WATER WELL RECORD
KSA 82a-1201-1215

Kansas Department of Health and Environment-Division of Environment
(Water well Contractors)
Topeka, Kansas 66620

1. Location of well: County Shawnee Fraction SW 1/4 SW 1/4 SW 1/4 Section number 27 Township number T 13 S Range number R 16 E E/W

2. Distance and direction from nearest town or city: 4 mi south 3. Owner of well: Richard P Faberline
Street address of well location if in city: of Berpton R.R. or street: Box 575
City, state, zip code: Rossville, KS 66532

4. Locate with "X" in section below: Sketch map:


6. Bore hole dia. 5 1/2 in. Completion date 7-12-78
Well depth 38 ft.

7. Cable tool Rotary Driven Dug
 Hollow rod Jetted Bored Reverse rotary

8. Use: Domestic Public supply Industry
 Irrigation Air conditioning Stock
 Lawn Oil field water Other

9. Casing: Material RMP Height: Above of Below 24 ft.
Threaded Welded Surface 24 in.
RMP PVC Weight 200 lbs./ft.
Dia. 5 in. to 38 ft. depth; Wall Thickness: inches or
Dia. 5 in. to 38 ft. depth; gage No. 200

10. Screen: Manufacturer's name Sunflower
Type RMP Dia. 5 in.
Slot/gauze 1050 Length 30 ft.
Set between 18 ft. and 38 ft.
Gravel pack? yes Size range of material 1/8-1/4

11. Static water level: 19 ft. below land surface Date 4-13-78 mo./day/yr.

12. Pumping level below land surfaces:
19 ft. after 12-1 hrs. pumping 12-1 g.p.m.
Estimated maximum yield 12-1 g.p.m.

13. Water sample submitted: no mo./day/yr.
Yes no No Date

14. Well head completion: 24 Pitless adapter 24 Inches above grade

15. Well grouted? yes
With: Neat cement Bentonite Concrete
Depth: From 0 ft. to 18 ft.

16. Nearest source of possible contamination:
ft. 100 Direction SE Type Toilet
Well disinfected upon completion? yes Yes No

17. Pump: Not installed
Manufacturer's name _____
Model number _____ HP _____ Volts _____
Length of drop pipe _____ ft. capacity _____ g.p.m.
Type:
 Submersible Turbine
 Jet Reciprocating
 Centrifugal Other

18. Elevation: 922 ft
Topography: Hill Slope Upland Valley

19. Remarks:

20. Water well contractor's certification:
This well was drilled under my jurisdiction and this report is true to the best of my knowledge and belief.
Robison Drilling 316 License No. _____
Business name Ferry, KS Address _____
Signed Jack Faberline Date 4-13-78
Authorized representative

Forward the white, blue and pink copies to the Department of Health and Environment

Form WWC-5