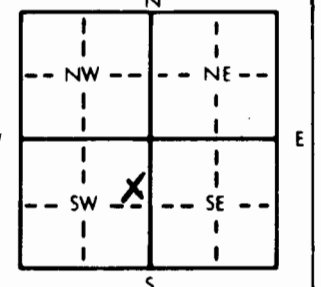


| | | | | | | | | | |
|--|--|----------------------|--|----------------|---|-----------------|--|--------------|--|
| 1 LOCATION OF WATER WELL: | | Fraction | | Section Number | | Township Number | | Range Number | |
| County: Shawnee | | SE 1/4 NE 1/4 SW 1/4 | | 31 | | T 13 S | | R 16 E | |
| Distance and direction from nearest town or city street address of well if located within city? | | | | | | | | | |
| Fuel lateral #6 | | | | | | | | | |
| 2 WATER WELL OWNER: Kansas Air National Guard | | | | | | | | | |
| RR#, St. Address, Box #: Forbes Field ANG | | | | | | | | | |
| City, State, ZIP Code: Topeka, Kansas | | | | | | | | | |
| Board of Agriculture, Division of Water Resources | | | | | | | | | |
| Application Number: | | | | | | | | | |
| 3 LOCATE WELL'S LOCATION WITH AN "X" IN SECTION BOX: | | | | | 4 DEPTH OF COMPLETED WELL: 15.0 ft. ELEVATION: 1043.9 | | | | |
|  | | | | | Depth(s) Groundwater Encountered 1. ft. 2. ft. 3. ft. | | | | |
| | | | | | WELL'S STATIC WATER LEVEL 8.67 ft. below land surface measured on mo/day/yr 7/10/88 | | | | |
| | | | | | Pump test data: Well water was ft. after hours pumping gpm | | | | |
| | | | | | Est. Yield gpm: Well water was ft. after hours pumping gpm | | | | |
| | | | | | Bore Hole Diameter 8 in. to 15.0 ft. and in. to ft. | | | | |
| | | | | | WELL WATER TO BE USED AS: 5 Public water supply 8 Air conditioning 11 Injection well | | | | |
| | | | | | 1 Domestic 3 Feedlot 6 Oil field water supply 9 Dewatering 12 Other (Specify below) | | | | |
| | | | | | 2 Irrigation 4 Industrial 7 Lawn and garden only 10 Monitoring well | | | | |
| | | | | | Was a chemical/bacteriological sample submitted to Department? Yes No X; If yes, mo/day/yr sample was submitted | | | | |
| | | | | | Water Well Disinfected? Yes No | | | | |
| 5 TYPE OF BLANK CASING USED: | | | | | | | | | |
| 1 Steel 3 RMP (SR) 5 Wrought iron 8 Concrete tile CASING JOINTS: Glued Clamped | | | | | | | | | |
| 2 PVC 4 ABS 6 Asbestos-Cement 9 Other (specify below) Welded | | | | | | | | | |
| Blank casing diameter 2 in. to 9.5 ft. Dia in. to ft. Dia in. to ft. | | | | | | | | | |
| Casing height above land surface in., weight lbs./ft. Wall thickness or gauge No. Sch. 40 | | | | | | | | | |
| TYPE OF SCREEN OR PERFORATION MATERIAL: | | | | | | | | | |
| 1 Steel 3 Stainless steel 5 Fiberglass 7 PVC 10 Asbestos-cement | | | | | | | | | |
| 2 Brass 4 Galvanized steel 6 Concrete tile 8 RMP (SR) 11 Other (specify) | | | | | | | | | |
| SCREEN OR PERFORATION OPENINGS ARE: | | | | | | | | | |
| 1 Continuous slot 3 Mill slot 5 Gauzed wrapped 8 Saw cut 11 None (open hole) | | | | | | | | | |
| 2 Louvered shutter 4 Key punched 6 Wire wrapped 9 Drilled holes | | | | | | | | | |
| 7 Torch cut 10 Other (specify) | | | | | | | | | |
| SCREEN-PERFORATED INTERVALS: From 9.5 ft. to 14.5 ft. From ft. to ft. | | | | | | | | | |
| GRAVEL PACK INTERVALS: From 8.5 ft. to 15.0 ft. From ft. to ft. | | | | | | | | | |
| 6 GROUT MATERIAL: 1 Neat cement 2 Cement grout 3 Bentonite 4 Other | | | | | | | | | |
| Grout Intervals: From 3 ft. to 15.0 ft. From ft. to ft. From ft. to ft. | | | | | | | | | |
| What is the nearest source of possible contamination: | | | | | | | | | |
| 1 Septic tank 4 Lateral lines 7 Pit privy 10 Livestock pens 14 Abandoned water well | | | | | | | | | |
| 2 Sewer lines 5 Cess pool 8 Sewage lagoon 11 Fuel storage 15 Oil well/Gas well | | | | | | | | | |
| 3 Watertight sewer lines 6 Seepage pit 9 Feedyard 12 Fertilizer storage 16 Other (specify below) | | | | | | | | | |
| 13 Insecticide storage | | | | | | | | | |
| Direction from well? West/North How many feet? 2000± | | | | | | | | | |
| FROM TO LITHOLOGIC LOG FROM TO PLUGGING INTERVALS | | | | | | | | | |
| 0 3 Native material | | | | | | | | | |
| 3 15.0 Cement grout | | | | | | | | | |
| 7 CONTRACTOR'S OR LANDOWNER'S CERTIFICATION: This water well was (1) constructed, (2) reconstructed, or (3) plugged under my jurisdiction and was completed on (mo/day/year) 4/9/90 and this record is true to the best of my knowledge and belief. Kansas | | | | | | | | | |
| Water Well Contractor's License No. 102 K This Water Well Record was completed on (mo/day/yr) 5/9/90 | | | | | | | | | |
| under the business name of Layne-Western Co., Inc. by (signature) [Signature] | | | | | | | | | |