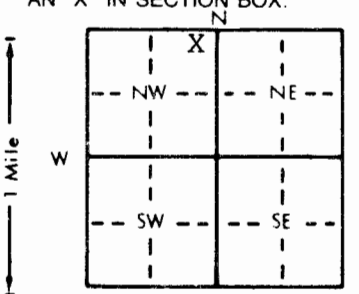


1 LOCATION OF WATER WELL: Fraction NE 1/4 NE 1/4 NW 1/4 Section Number 4 Township Number T 13 S Range Number R 16 E/W
 County: SHAWNEE
 Distance and direction from nearest town or city street address of well if located within city?
1 1/2 south, 2 1/2 east of Topeka

2 WATER WELL OWNER: Kerry Burrus
 RR#, St. Address, Box # : 2245 SE 61st Board of Agriculture, Division of Water Resources
 City, State, ZIP Code : Berryton, KS 66409 Application Number:

3 LOCATE WELL'S LOCATION WITH AN "X" IN SECTION BOX:  4 DEPTH OF COMPLETED WELL: 80' ft. ELEVATION:
 Depth(s) Groundwater Encountered 1. 19' ft. 2. ft. 3. ft.
 WELL'S STATIC WATER LEVEL: 15' ft. below land surface measured on mo/day/yr 10-17-94
 Pump test data: Well water was ft. after hours pumping gpm
 Est. Yield 1 gpm: Well water was ft. after hours pumping gpm
 Bore Hole Diameter: 8 3/4 in. to ft. and in. to ft.
 WELL WATER TO BE USED AS: 5 Public water supply 8 Air conditioning 11 Injection well
 1 Domestic 3 Feedlot 6 Oil field water supply 9 Dewatering 12 Other (Specify below)
 2 Irrigation 4 Industrial 7 Lawn and garden only 10 Monitoring well
 Was a chemical/bacteriological sample submitted to Department? Yes No X; If yes, mo/day/yr sample was submitted
 Water Well Disinfected? Yes X No

5 TYPE OF BLANK CASING USED: 5 Wrought iron 8 Concrete tile CASING JOINTS: Glued X Clamped
 1 Steel 3 RMP (SR) 6 Asbestos-Cement 9 Other (specify below) Welded
 2 PVC 4 ABS 7 Fiberglass Threaded
 Blank casing diameter 5" in. to 0-18 ft., Dia 5" in. to 31-40 ft., Dia 5" in. to 65-80 ft.
 Casing height above land surface: 24" in. weight 2.82 lbs. ft. Wall thickness or gauge No. .258
 TYPE OF SCREEN OR PERFORATION MATERIAL: 7 PVC 10 Asbestos-cement
 1 Steel 3 Stainless steel 5 Fiberglass 8 RMP (SR) 11 Other (specify)
 2 Brass 4 Galvanized steel 6 Concrete tile 9 ABS 12 None used (open hole)
 SCREEN OR PERFORATION OPENINGS ARE: 5 Gauzed wrapped 8 Saw cut 11 None (open hole)
 1 Continuous slot 3 Mill slot 6 Wire wrapped 9 Drilled holes
 2 Louvered shutter 4 Key punched 7 Torch cut 10 Other (specify)
 SCREEN-PERFORATED INTERVALS: From 18 ft. to 31 ft., From ft. to ft.
 From 40 ft. to 65 ft., From ft. to ft.
 GRAVEL PACK INTERVALS: From 15 ft. to 80 ft., From ft. to ft.
 From ft. to ft., From ft. to ft.

6 GROUT MATERIAL: 1 Neat cement 2 Cement grout 3 Bentonite 4 Other
 Grout Intervals: From 0 ft. to 15 ft., From ft. to ft., From ft. to ft.
 What is the nearest source of possible contamination:
 1 Septic tank 4 Lateral lines 7 Pit privy 10 Livestock pens 14 Abandoned water well
 2 Sewer lines 5 Cess pool 8 Sewage lagoon 11 Fuel storage 15 Oil well/Gas well
 3 Watertight sewer lines 6 Seepage pit 9 Feedyard 12 Fertilizer storage 16 Other (specify below)
 13 Insecticide storage
 Direction from well? east How many feet? 210'

FROM	TO	LITHOLOGIC LOG	FROM	TO	PLUGGING INTERVALS
0	1	Top Soil			
1	13	Clay-Brown			
13	17	FS-CS-MED Gravel			
17	19	FS-CS-Med-Pea 1/2x1/2			
19	29	Limestone-Grey			
29	34	Shale-Grey			
34	36	Sandstone-Grey			
36	39	Shale-Grey			
39	53	Sandstone-Dirty			
53	56	Shale-Grey			
56	65	Sandstone-Grey			
65	80	Shale-Grey			

NOTE: 10-20-94 Permission to shallow grout from Don Taylor.

7 CONTRACTOR'S OR LANDOWNER'S CERTIFICATION: This water well was (1) constructed, (2) reconstructed, or (3) plugged under my jurisdiction and was completed on (mo/day/year) 10-17-94 and this record is true to the best of my knowledge and belief. Kansas Water Well Contractor's License No. 182 This Water Well Record was completed on (mo/day/yr) 11-9-94 under the business name of STRADER DRILLING CO., INC. by (signature) Dale Strader