


1 LOCATION OF WATER WELL: Fraction SW 1/4 NW 1/4 NE 1/4 Section Number 5 Township Number T 13 Range Number R 16 EW  
 County: Shawnee

Distance and direction from nearest town or city street address of well if located within city?  
3 miles south of Topeka at J-470 on HWY 75 at Forbes Field

2 WATER WELL OWNER: USACE Kansas City District  
 RR#, St. Address, Box #: 700 Federal Bldg Board of Agriculture, Division of Water Resources  
 City, State, ZIP Code: Kansas City Mo 74106 Application Number:

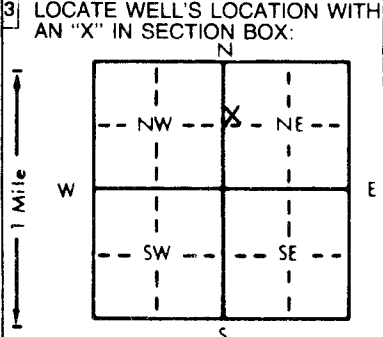

4 DEPTH OF COMPLETED WELL: 35.4 ft. ELEVATION: —  
 Depth(s) Groundwater Encountered 1. — ft. 2. — ft. 3. — ft.  
 WELL'S STATIC WATER LEVEL 0 ft. below land surface measured on mo/day/yr  
 Pump test data: Well water was — ft. after — hours pumping — gpm  
 Est. Yield — gpm: Well water was — ft. after — hours pumping — gpm  
 Bore Hole Diameter 12 in. to 22 ft., and 3718 in. to 46.8 ft.  
 WELL WATER TO BE USED AS:  
 5 Public water supply 8 Air conditioning 11 Injection well  
 1 Domestic 3 Feedlot 6 Oil field water supply 9 Dewatering 12 Other (Specify below)  
 2 Irrigation 4 Industrial 7 Lawn and garden only 10 Monitoring well  
 Was a chemical/bacteriological sample submitted to Department? Yes — No X; If yes, mo/day/yr sample was submitted  
 Water Well Disinfected? Yes — No X

5 TYPE OF BLANK CASING USED:  
 1 Steel 3 RMP (SR) 5 Wrought iron 8 Concrete tile CASING JOINTS: Glued — Clamped —  
2 PVC 4 ABS 25 6 Asbestos-Cement 9 Other (specify below) Welded —  
 7 Fiberglass Threaded X  
 Blank casing diameter 2 in. to 22 ft., Dia — in. to — ft., Dia — in. to — ft.  
 Casing height above land surface 30 in., weight Sch 40 lbs./ft. Wall thickness or gauge No. —  
 TYPE OF SCREEN OR PERFORATION MATERIAL:  
 1 Steel 3 Stainless steel 5 Fiberglass 8 RMP (SR) 10 Asbestos-cement 11 Other (specify) —  
 2 Brass 4 Galvanized steel 6 Concrete tile 9 ABS 12 None used (open hole)  
 SCREEN OR PERFORATION OPENINGS ARE:  
 1 Continuous slot 3 Mill slot 5 Gauzed wrapped 8 Saw cut 11 None (open hole)  
 2 Louvered shutter 4 Key punched 6 Wire wrapped 9 Drilled holes  
 7 Torch cut 10 Other (specify) —  
 SCREEN-PERFORATED INTERVALS: From 25.0 ft. to 35.0 ft., From — ft. to — ft.  
 From — ft. to — ft., From — ft. to — ft.  
 GRAVEL PACK INTERVALS: From 24.0 ft. to 46 ft., From — ft. to — ft.  
 From — ft. to — ft., From — ft. to — ft.

6 GROUT MATERIAL: 1 Neat cement 2 Cement grout 3 Bentonite 4 Other Sacrete  
 Grout Intervals: From 0-0 ft. to 21 ft., From 21 ft. to 24 ft., From — ft. to — ft.  
 What is the nearest source of possible contamination:  
 1 Septic tank 4 Lateral lines 7 Pit privy 10 Livestock pens 14 Abandoned water well  
 2 Sewer lines 5 Cess pool 8 Sewage lagoon 11 Fuel storage 15 Oil well/Gas well  
 3 Watertight sewer lines 6 Seepage pit 9 Feedyard 12 Fertilizer storage 16 Other (specify below) Landfill  
 13 Insecticide storage  
 Direction from well? East How many feet?

FROM	TO	LITHOLOGIC LOG	FROM	TO	PLUGGING INTERVALS
0.0	10.0	st cl Br.			
10.0	23.0	ss shale yellow Br.			
23.0	29.0	G- L/S			
29.0	33.6	limey ss shale G-			
33.6	46.8	G- shale + lime stone			

7 CONTRACTOR'S OR LANDOWNER'S CERTIFICATION: This water well was 1 constructed, (2) reconstructed, or (3) plugged under my jurisdiction and was completed on (mo/day/year) 10/4/94 and this record is true to the best of my knowledge and belief. Kansas Water Well Contractor's License No. 416 This Water Well Record was completed on (mo/day/yr) 11/3/94 under the business name of Terracon Consultants Inc by (signature) Richard Denny

INSTRUCTIONS: Use typewriter or ball point pen. PLEASE PRESS FIRMLY and PRINT clearly. Please fill in blanks, underline or circle the correct answers. Send top three copies to Kansas Department of Health and Environment, Bureau of Water, Topeka, Kansas 66620-0001. Telephone: 913-296-5545. Send one to WATER WELL OWNER and retain one for your records.