


1 LOCATION OF WATER WELL: County: Douglas Fraction: NW 1/4 NE 1/4 SE 1/4 Section Number: 2 Township Number: T 13 S Range Number: R 19 E/W

Distance and direction from nearest town or city street address of well if located within city?

2 WATER WELL OWNER: Kansas Geological Survey RR#, St. Address, Box #: 1930 Constant Avenue Board of Agriculture, Division of Water Resources City, State, ZIP Code: Lawrence, KS 66045 Application Number:

3 LOCATE WELL'S LOCATION WITH AN "X" IN SECTION BOX:

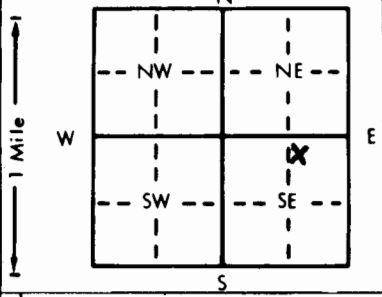

4 DEPTH OF COMPLETED WELL: 293 ft. ELEVATION: 922

Depth(s) Groundwater Encountered: 1. ft. 2. ft. 3. ft. WELL'S STATIC WATER LEVEL: 86.75 ft. below land surface measured on mo/day/yr: 5/10/85 Pump test data: Well water was ... ft. after ... hours pumping ... gpm Est. Yield ... gpm: Well water was ... ft. after ... hours pumping ... gpm Bore Hole Diameter: 10 in. to 31.5 ft., and 6 3/4 in. to 26.3 ft. WELL WATER TO BE USED AS: 5 Public water supply 8 Air conditioning 11 Injection well 4 3/4-2 1 Domestic 3 Feedlot 6 Oil field water supply 9 Dewatering 12 Other (Specify below) 2 Irrigation 4 Industrial 7 Lawn and garden only 10 Observation well Research Was a chemical/bacteriological sample submitted to Department? Yes ... No XX; If yes, mo/day/yr sample was submitted Water Well Disinfected? Yes No XX

5 TYPE OF BLANK CASING USED: 1 Steel 3 RMP (SR) 5 Wrought iron 8 Concrete tile CASING JOINTS: Glued XX Clamped Welded 2 PVC 4 ABS 6 Asbestos-Cement 9 Other (specify below) Threaded 7 Fiberglass

Blank casing diameter: 8 in. to 31.5 ft., Dia. in. to ft., Dia. in. to ft. Casing height above land surface: 1.61 in., weight lbs./ft. Wall thickness or gauge No. Schd. 40

TYPE OF SCREEN OR PERFORATION MATERIAL: 1 Steel 3 Stainless steel 5 Fiberglass 8 RMP (SR) 11 Other (specify) 2 Brass 4 Galvanized steel 6 Concrete tile 9 ABS 12 None used (open hole)

SCREEN OR PERFORATION OPENINGS ARE: 1 Continuous slot 3 Mill slot 5 Gauzed wrapped 8 Saw cut 11 None (open hole) 2 Louvered shutter 4 Key punched 6 Wire wrapped 9 Drilled holes 7 Torch cut 10 Other (specify)

SCREEN-PERFORATED INTERVALS: From ft. to ft., From ft. to ft., From ft. to ft. GRAVEL PACK INTERVALS: From ft. to ft., From ft. to ft., From ft. to ft.

6 GROUT MATERIAL: 1 Neat cement 2 Cement grout 3 Bentonite 4 Other Grout intervals: From 0 ft. to 31.5 ft., From ft. to ft., From ft. to ft.

What is the nearest source of possible contamination: 1 Septic tank 4 Lateral lines 7 Pit privy 10 Livestock pens 14 Abandoned water well 2 Sewer lines 5 Cess pool 8 Sewage lagoon 11 Fuel storage 15 Oil well/Gas well 3 Watertight sewer lines 6 Seepage pit 9 Feedyard 12 Fertilizer storage 16 Other (specify below) 13 Insecticide storage Direction from well? How many feet? 20 feet East

Table with columns: FROM, TO, LITHOLOGIC LOG, FROM, TO, LITHOLOGIC LOG. Content: PLEASE SEE ATTACHED PAGE

7 CONTRACTOR'S OR LANDOWNER'S CERTIFICATION: This water well was (1) constructed, (2) reconstructed, or (3) plugged under my jurisdiction and was completed on (mo/day/year) 5/10/85 and this record is true to the best of my knowledge and belief. Kansas Water Well Contractor's License No. This Water Well Record was completed on (mo/day/yr) 6-9-85 under the business name of Kan. Geol. Survey by (signature) Thomas J. ...

INSTRUCTIONS: Use typewriter or ball point pen, PLEASE PRESS FIRMLY and PRINT clearly. Please fill in blanks, underline or circle the correct answers. Send top three copies to Kansas Department of Health and Environment, Division of Environment, Environmental Geology Section, Topeka, KS 66620. Send one to WATER WELL OWNER and retain one for your records.

(604)

Log for Well 13<sub>E</sub>-19<sub>S</sub>-2 DAB

FROM      TO                      LITHOLOGIC LOG

0	1 01	Topsoil	Lawrence Shale
1	4	Weathered shale-light brown to gray weathered shale	
4	104 19	Lite to dark clayey to silty shale with harder calcaneous zones scattered throughout	Haskell Lime stone
104	110 20	Limestone-light gray to light tan	
110	127 23	Sandstone tan silty	Vinland Shal
127	135 19	Shale gray-with coal at approx. 133' (upper sibley)	Tonganoxie Sandstone
135	158 23	Sandstone	
158	165 19	Shale	
165	171 23	Sandstone-light tan-silty medium grained	
171	172 27	Coal	
172	181 19	Shale	
181	268.5 23	Sandstone light gray medium grained	
268.5	279.5 20	Limestone-South Bend	South Bend Limestone
279.5	291.5 19	Shale-Rocklake	Rocklake Shale
291.5	293 20	Limestone-Stoner	Stoner Limest

This hole was cored from 31.5' to 26.5'. Drill cuttings were collected from 0 to 31.5' and from 265 to 293'. The hole will be used as a test and calibration pit for a Geophysical logger and for testing various hydrogeologic hardware. The cores will be analyzed for their hydrologic and geologic properties.

**RECEIVED**

Tom McClain  
Kansas Geological Survey  
6/5/85

JUN 07 1985

BUREAU OF OIL FIELD &  
ENVIRONMENTAL GEOLOGY

March 28, 1985

Mr. Ron Cook  
Kansas University Facilities Operations  
CAMPUS

Dear Ron:

I'm enclosing a copy of one of your maps showing the location of the test hole we would like to drill just south of Foley Hall on West Campus. As noted on the map, the test hole is 80 feet south and 21 feet west of the southeast corner of Foley Hall. It is 25 feet west of the gravel road that goes to the nursery and 16 feet north of an outlet culvert for a drain for our parking lot at Foley. It's about 4 feet east of a chain link fence that runs north-south in that area.

The test hole we anticipate will be about 250 feet deep and will consist of about an 8-inch casing extending 12 inches above the land surface. This would be surrounded by a concrete pad approximately 18 inches square to cement the surface casing in place. This surface casing will extend to approximately 50 feet below the land surface and will be cemented in. Below that the hole would be uncased. We would like to use this hole for calibration of a geophysical logger and would like the hole in this location in order to have access to it in any weather.

I would anticipate infrequent (several times a year) use of the site in order to back a van up next to the well and run a probe up and down the well to take some readings. Hopefully this will not interfere with any future plans on this part of campus. Please let me know if there are any conflicts with Facilities Operations. We would like to start drilling about April 8 and should finish in 2-3 weeks.

Sincerely,


Thomas J. McClain  
Research Associate  
Geohydrology Section

TJM:kl


Encl.

Proposed location  
for test well.  
Location moved  
to NE  
of Foley  
NW NE SE

US

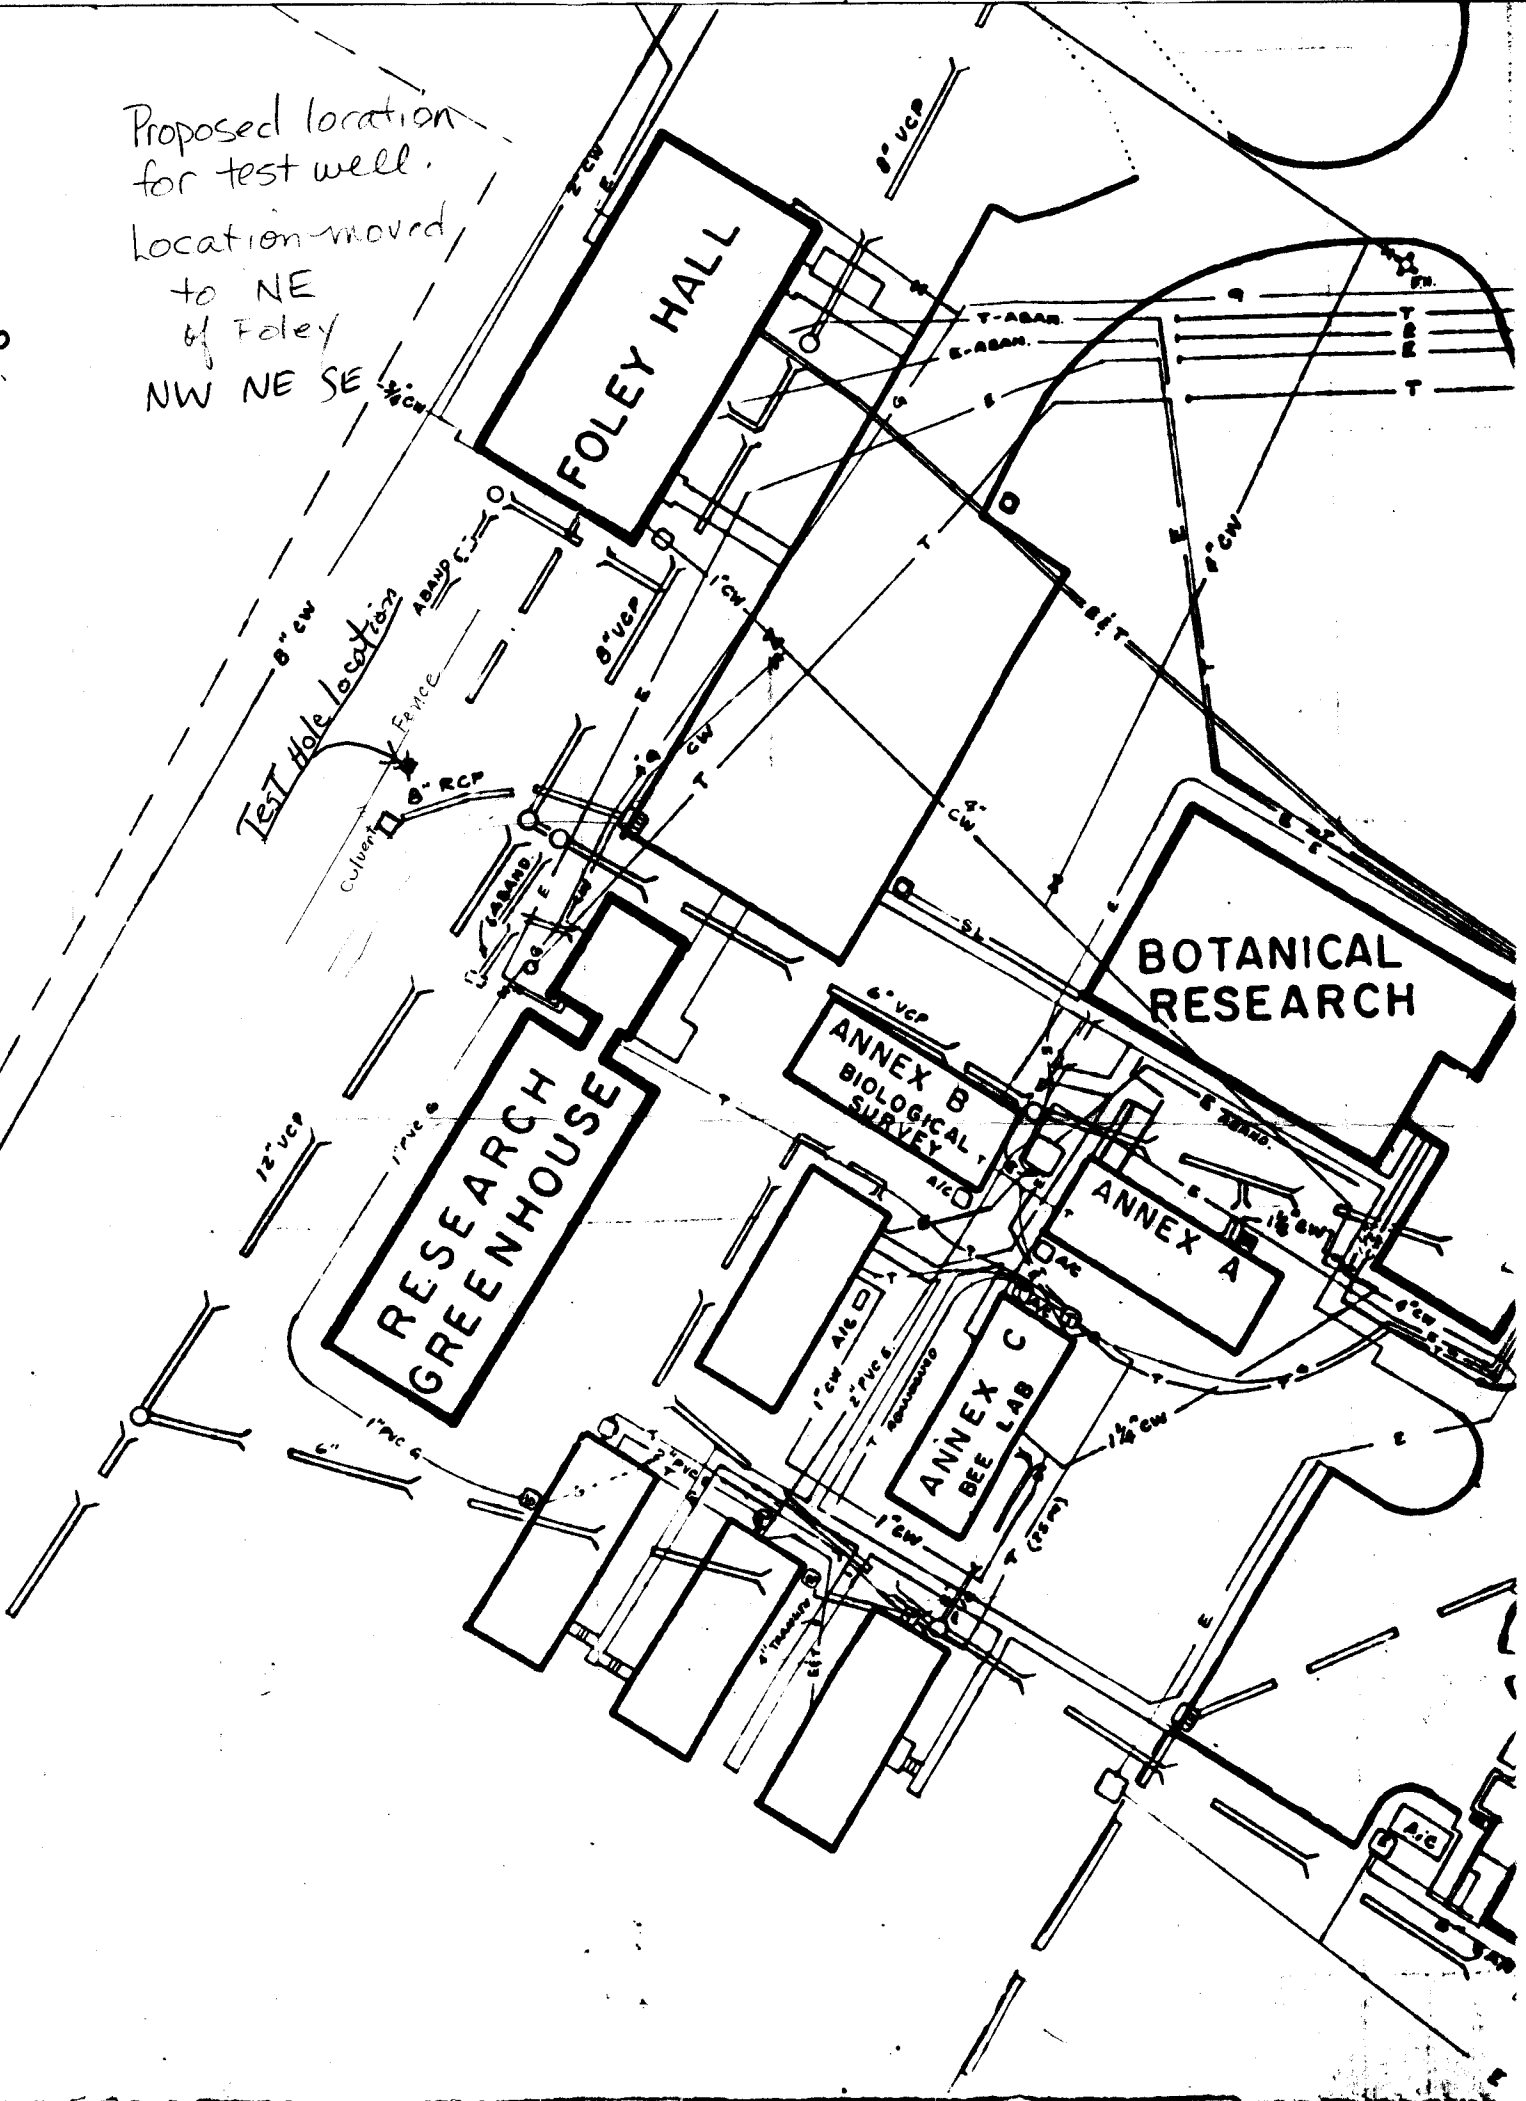



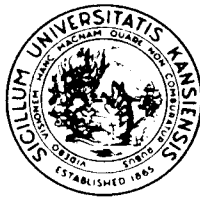

## THE UNIVERSITY OF KANSAS

Site and Landscape Planning  
Sudler House  
P.O. Box 2008, Lawrence, Kansas 66045  
(913) 864-4636

April 4, 1985

TO: Jim Canole

FROM: Greg Wade *glw*

SUBJECT: Test Well North of Foley Hall - 922 SL

Attached is a location map showing the site for a test well to be drilled north of Foley Hall. Your memo to me, dated April 2, in regard to this subject included correspondence and a location map from Tom McClain which identified a proposed location for this well south of Foley Hall. As you can see from the attachments, possible permanent building sites are identified south of Foley Hall and therefore a new site was sought. Ron Cook and I met with Tom McClain on site yesterday and established the site north of Foley Hall as a good one for the test well. Availability of electrical service was part of the criteria which resulted in the chosen site. One small tree is to be removed to accommodate this well. I have asked Facilities Operations' landscape crew to accomplish this work as soon as possible, due to the fact that the test well drilling could begin as early as the first of next week.


GLW/dz

Encl.

cc: Allen Wiechert  
Ron Cook  
Tom McClain ✓  
Dick Bivens

922. 81 Fishponds #3

~ 904 - Fishpond 1+2

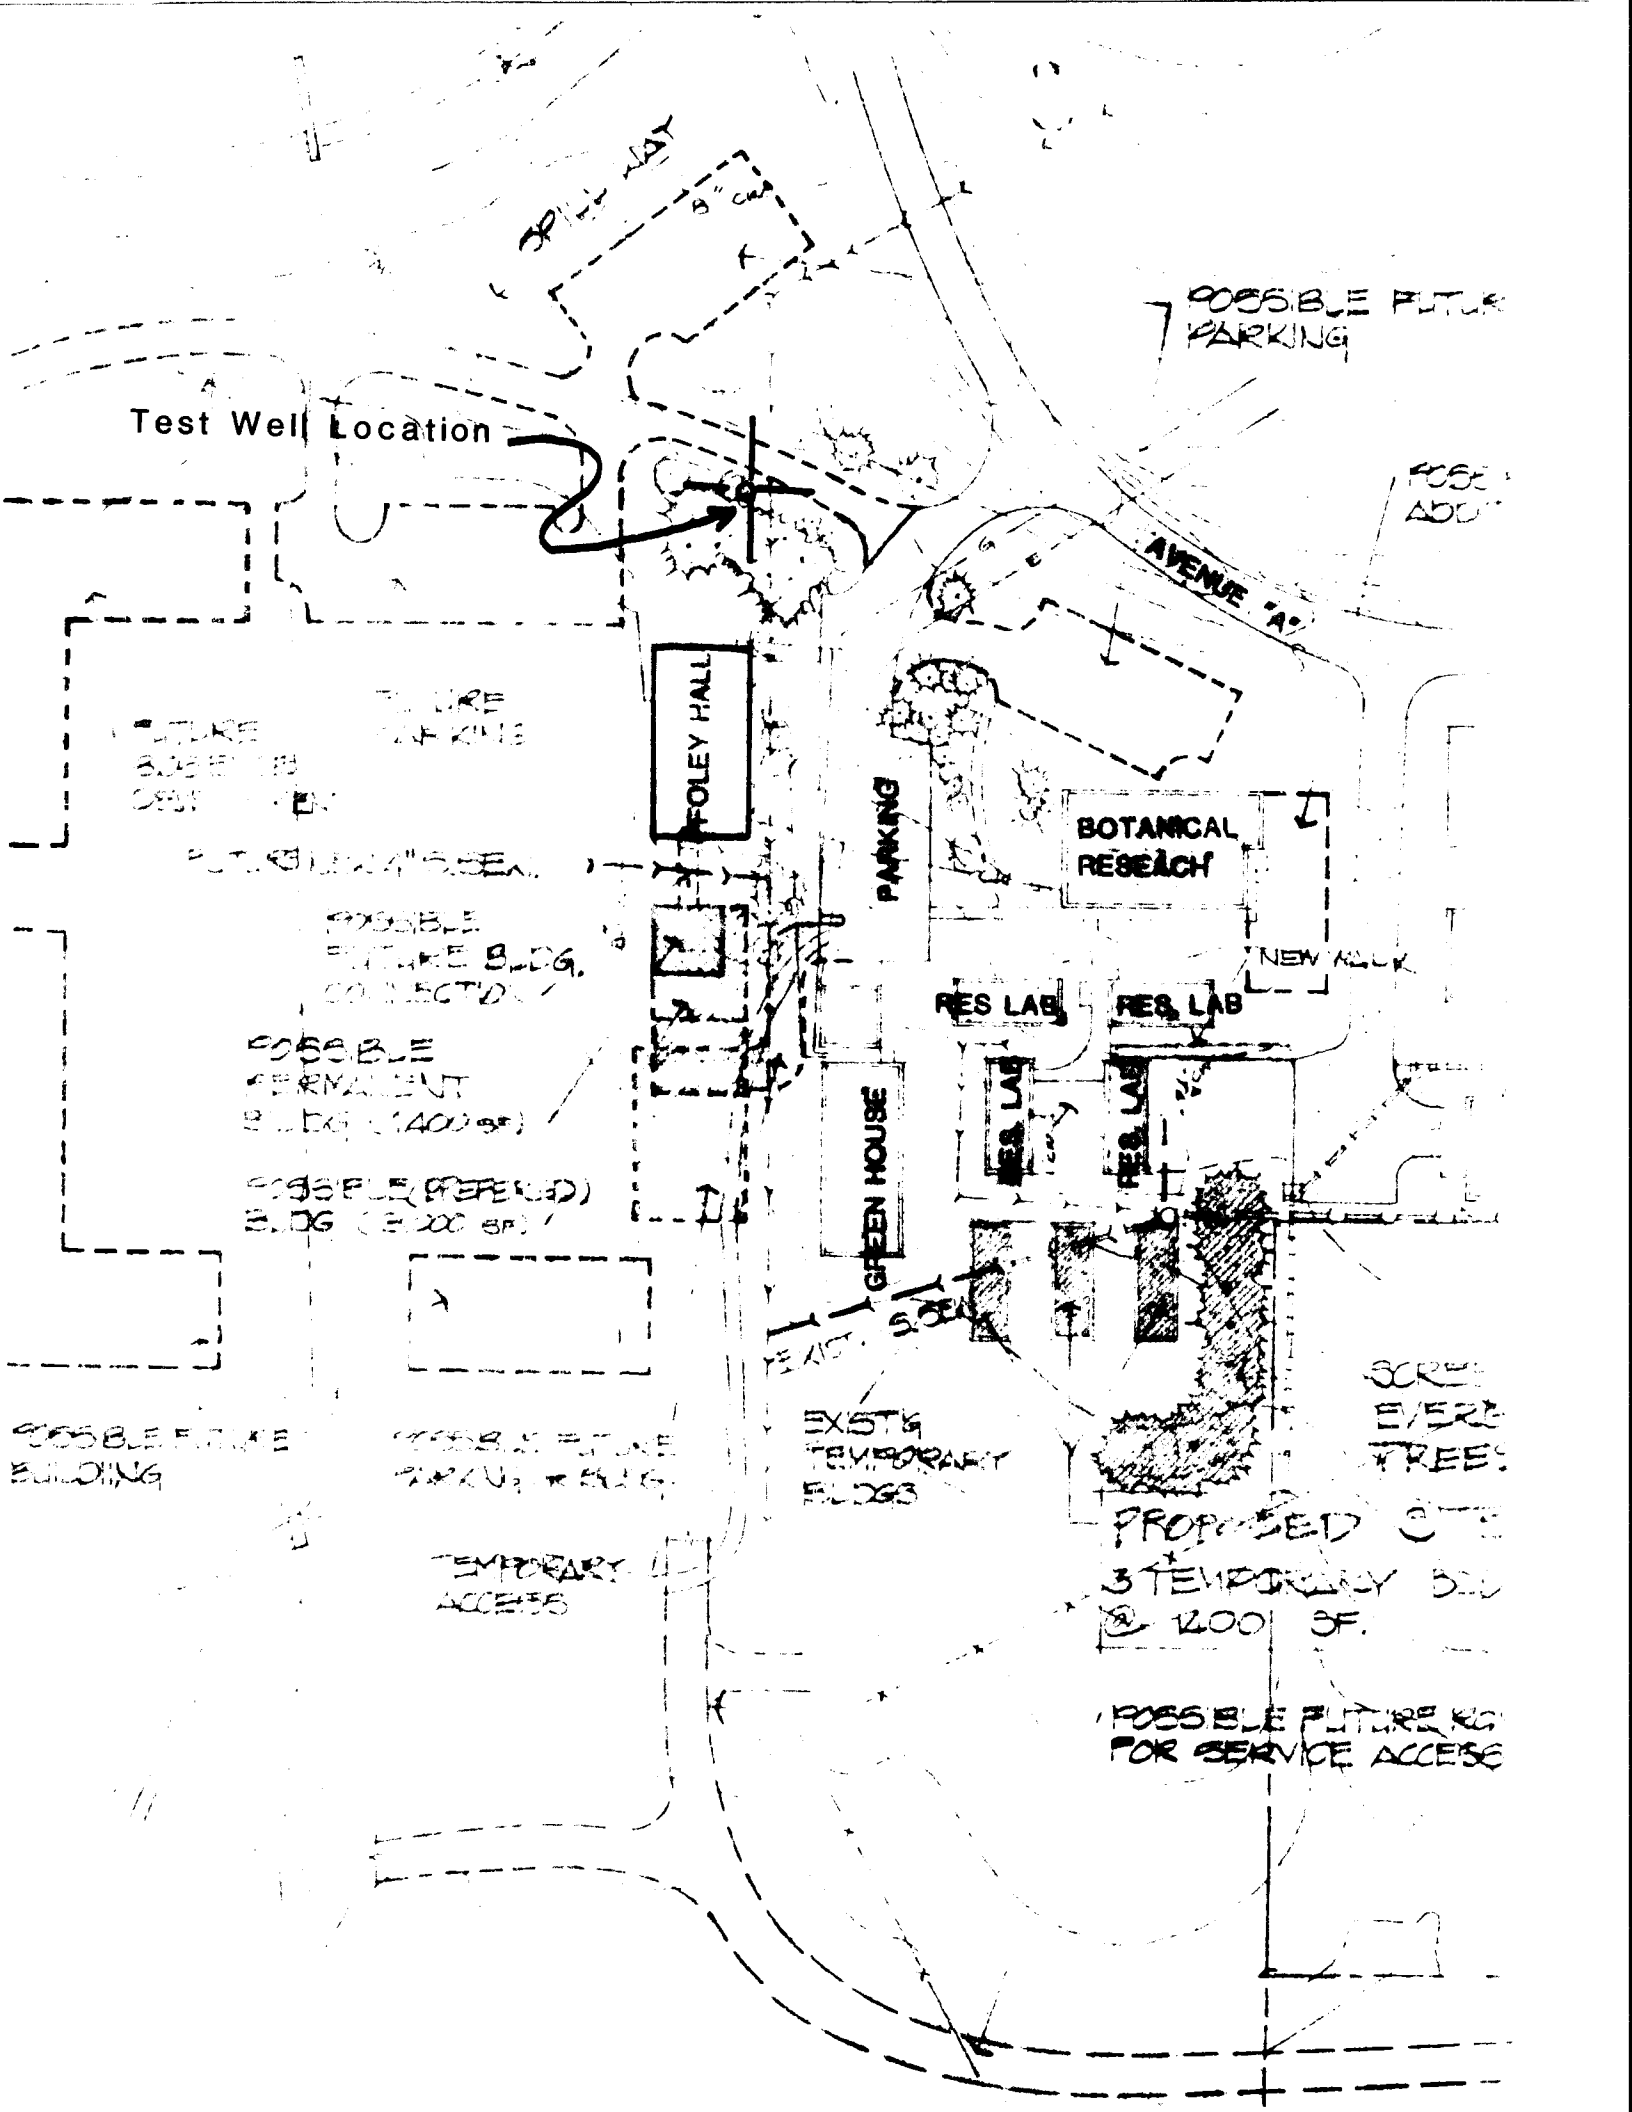

DRILL WAY  
9" DIA.

Test Well Location

POSSIBLE FUTURE  
PARKING

POSSIBLE  
ADD

AVENUE A

FOLEY HALL

PARKING

BOTANICAL  
RESEARCH

NEW WALK

RES. LAB.

RES. LAB.

GREEN HOUSE

RES. LAB.

RES. LAB.

POSSIBLE  
FUTURE  
PARKING

POSSIBLE  
FUTURE BLDG.  
CONNECTION

POSSIBLE  
PERMANENT  
BLDG (1400 SF)

POSSIBLE  
PERMANENT  
BLDG (3200 SF)

POSSIBLE (PERMANENT)  
BLDG (3200 SF)

POSSIBLE FUTURE  
BUILDING

POSSIBLE FUTURE  
PARKING BLDG.


EXISTING  
TEMPORARY  
BLDGS

SCREEN  
EVERGREEN  
TREES

TEMPORARY  
ACCESS

PROPOSED SITE  
3 TEMPORARY BLDG  
@ 1200 SF.

POSSIBLE FUTURE ROAD  
FOR SERVICE ACCESS

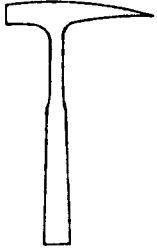

KANSAS GEOLOGICAL SURVEY

1930 Constant Avenue, Campus West  
The University of Kansas  
Lawrence, Kansas 66044-3896  
913-864-5672

June 5, 1985

Greg Wade  
Facilities Operations  
Campus


Dear Greg:

We have finished the test hole just north of Foley Hall on west campus. I am enclosing a log for your information. I appreciate your help with the location of the utilities and if there is ever anything I can do for you please let me know.

Sincerely,

Tom McClain

Enclosure

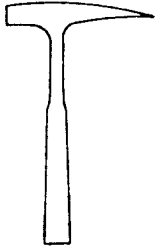

# KANSAS GEOLOGICAL SURVEY

1930 Constant Avenue, Campus West  
The University of Kansas  
Lawrence, Kansas 66044-3896  
913-864-5672

June 6, 1985

Ron Cook  
Facilities Operations  
Campus

Dear Ron:

We finally finished the test hole north of Foley Hall on west campus. You have probably noticed the white pvc casing and the concrete slab in place. We got fairly good rock samples down to 293' while we were drilling the hole and it makes a perfect test hole to calibrate our geophysical logger. I am enclosing a log which summarizes the particulars of the hole and if you need more detailed information please let me know. We plan to take some of the cores that we got from the drilling process and analyze them in the lab for porosity and permeability. I appreciate your help with the location of the well and if there is ever anything I can do for you please let me know.

Sincerely,

Tom McClain

Enclosure

Depth	Recorded
31.5-42	~6'
43-52	●
52-59-62	● 1'
53-63	8'
63.5-69.6	— ?
70.5-77.5	— ?
76.5-83.0	— ?
83-89.4	— ?
89.4-102	— ?
101-106.7	5'
106.7-115	9'
116-123.6	8'
121-129	— ?
127-132	~6'
131-140	6.8'
138-147	8'
147-156.2	9.3'
154-162	7'
162-168	0'
168-176	5.3'
174-182	~8'
182.5-194.3	8'
192.3-201.5	5'
201.5-210.5	5'

Depth	
205-215?	— ?
215-?	○
218-225	2.8'
225-231.5	3'
234-243.5	8.75'
243.5-252.5	2.8'
252-255.5	1'
247-255.5	2'
255-260	3.5'
260-265	○
265-293	cuttings only

?  
?




80' S  
21' W of Bldg } SE corner  
25' W of road  
16' N of Culvert

Fence = 35' W of market canal

Market to outlet drain = 35'

N. end of fence to market 50'

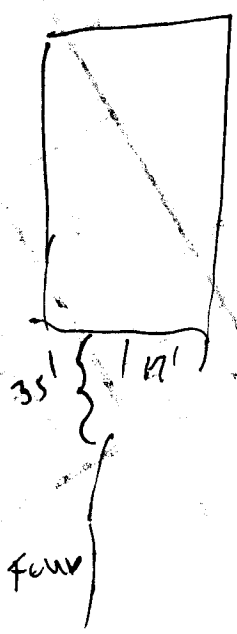

Owner KCS-TU Fishers #3 1/4 1/4 1/4 sec. 2 T. 13 R. 19

County DG Date 4-9-85


Static Water Level \_\_\_\_\_

Topo. Sheet Law W Elev. 922

Depth \_\_\_\_\_ Yield \_\_\_\_\_

Location ~ 60' N and 15' W of NE corner of Foley Hall

~ 20' S of Gravel Rd. #13-19-204B

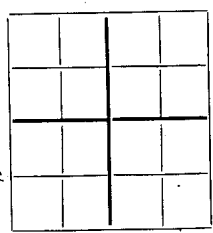

Formation Record

Ft.	From	To	Description
0	3		Topsoil
3	19		Weathered shale light brown - sandy
19	24		gray shale - only specimen found pit
24	25		gray limestone - Hard drilling
25	25 1/2		smoother at 25 1/2
25	32		gray shale & limestone harder drilling
32			smoother drilling at 32'

10" rotary hole  
To 32 1/2 feet  
set surface  
casing of 8"  
PVC

135-19E-02 DAB el ~ 928



April 12, 85 (~~At~~ ~~to~~ ~~pliocene~~)

18.9 ft from MP: depth of hole at 9:30 am

To be drilled down to 33 ft

≤ 31.5' from MP: depth of hole after it<sup>was</sup> drilled out. Finished at 10:30 am

Core barrel ready to be put in

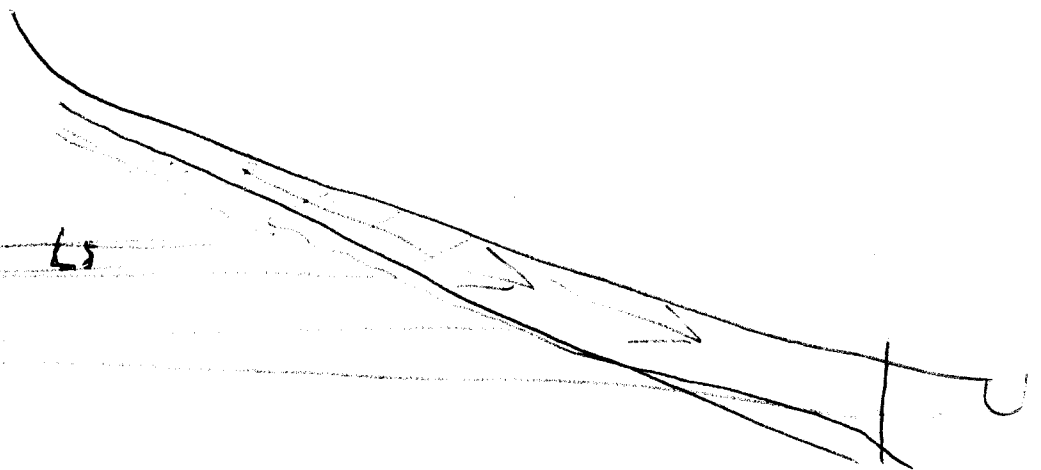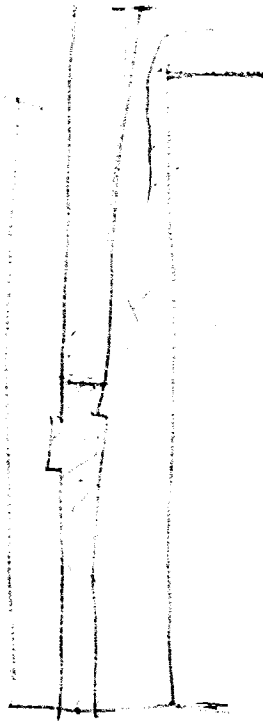

April 12, 85

12:16 at 32 1/2' using water with cement grout  
contamination Engine 1700 max power 2 1/2 hp  
Rotation 140 RPM

12:20 at 33 1/2'

12:29 at 34 1/2'

12:43 at 36'

12:49 at 36.5' hit something hard for < 30 sec.

12:53 at 37'

1:01 at 38'

1:10 at 39' (1:12 my watch) turned very dark (shale)

1:19 at 40'

1:27 at 41'



1:37 at 42'

(Mel's watch)

stop for core retrieval

recovered ~ 3' foot of core  
depth of hole from MP = 35 ft.  
~ 42 inches length of core

Mel went in again with the core barrel recovered something now the depth of hole = 38' ft core not reaching to acid at all.

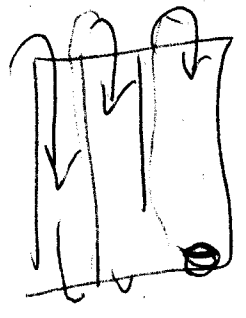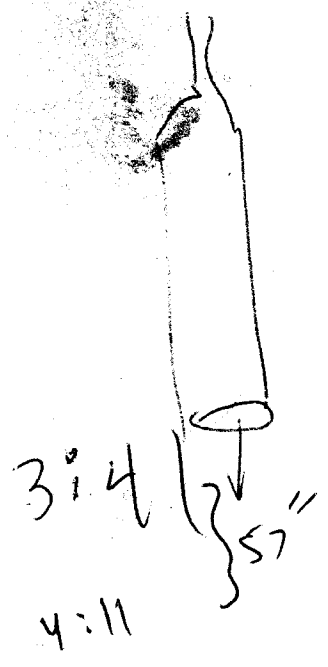

Measured to 38

Reamed to 37 1/2" with 6 3/4" Miller

Corrug Bagen at 38'

stopped Depth 43 1/2'

15 April 85 P. A. Macfarlane

began setting up at 9:30 AM  
depth of hole @ 43' below top of casing  
started drilling @ 10:00 AM

10:05 - 10:15 corrd 1.5' to 44.5  
 10:15 - 10:35 47 to ~~47.5~~ 47.5  
 hard layer @ ~~47~~ 47 (brist)  
 hard layer @ 48.5 smoothed out @ 48.4 | progress  
 hard layer @ 49.5 smoothed out @ 49.2 | 57 + W  
 11:28 — corrd to 50  
 11:24 — corrd to 51  
 11:30 corrd to 52 → quit  
 51.75 imp pulled up to get core  
 reamed from 38 to 52

began coring using large barrel  
 1:24 began coring corrd @ 1' per min for 20 min  
 2:25 first shot coring corrd 7 ft in 50 minutes  
 core recovery on the first try is zero

April 15 R. Miller  
 going down w/ large barrel to try & recover core  
 3:25 began from 52' ~~go down~~ (5') (5')  
 3:27 - began coring (hard - rattling)  
 3:32 - 1' <sup>of</sup> coring (6') - smoother @ (6')  
 3:39 - rattling - stop - pull

3  
 48  
 55  
 57  
 15  
 12  
 15  
 15  
 50  
 265  
 9  
 56

61' ~~hard~~  
 62' ~~hard~~



4:20 Apr. 15 85

- get core that small cover already covered (can see marks)  
gray - F sandy silty shale  
tape goes down to 49' (~~was~~ core barrel was down 62')
- get 1' of core from 52' - 62' (prob. from very top)

4:22 - go down w/ barrel <sup>large</sup> & CABLE to try for core (3 times w/ no luck)

4:42 try again w/ spring catcher on large barrel struck @ 55' (no drilling)  
(core pull up? see if some core (BOX not full yet))

April 16, 85 (A. Sophocleous)

start ~ 8:30 am.

Depth of hole ~ 54 ft.

Mel Talked to Hunter from the Corps of Engineers & got some suggestions.

Mel could not get the core out of the hole with the large covers yesterday. He will try again with some Hunter tricks this morning.

Steel ball missing from top of cover that's why may be water goes inside the core barrel & washes the core out. By calling around they found extra balls. Joe is going to get some at ~ 9:30 am

" " " ~ 63 ft after core was extracted  
~ 11:00 Core from 53' to 63' recovered (~ 80%)  
2 Boxes marked 53' to 63' - (Box 1 + Box 2)  
4" core

11:08 started corey (small barrel) - at 63 1/2'  
8 min to 65 1/2' ~ 4 min/ft  
65 1/2' - 66 1/2' 3 1/2 min  
66 1/2' - 67 1/2' 5 min

IM chain  
4-16-85  
6 1/2'

~~69-69 2/3~~ - 1'

69-69 2/3' - 14 minutes - stopped drilling at 70 1/2'

To clean Barrel -

Reamed To 70 1/2 feet with Roller  
started 4" Barrel at 70 1/2'

72-73' 14 1/2 min

73-74' 14 min

74-75' 18 min

75-76'

76-77'

76-77 1/2' 9 min

} 45 min (4')

Stopped drilling @ 4:38 drilled 7' on Big Barrel

4-17-85

12 April 85

P. B. MacFarlane

began @ 8:00 AM small barrel. pick up some  
core pieces of core

began coring @ 76.5' below mp

cored 5 ft by 8:45 AM finished coring 9:15 AM

83.6 below mp attached to this coring

ran out to 83.0 ft. 11:00 AM

began coring @ 12:00 with big barrel. completed @ 12:40 PM

had coring from the big barrel tried again for 5 min

completed big core @ 2:10 depth to mp is 89.4.

used small barrel for next coring beginning @ 89.4

finished coring 4:10 PM with stuck barrel.  
estimated depth from top 15102 ft.

3 ft sub  
10 ft small core barrel  
88

April 18, 1985 Pam Chaffee

w/ Joe Anderson  
Ron Johnson  
+ Don B.



Start reaming the hole at 9:22 am

Reamed to 93 ft 9:38 am

add a stem

Start reaming 9:41 am

noisy drilling at 100.3 ft

Stop reaming at 101.6 feet ~10:00 am

put sm core barrel in (12 ft)

- 1st stem (15 ft)
- 2nd stem (15 ft)
- 3rd stem (15 ft)
- 4th stem (15 ft)
- 5 stem (15 ft)
- 6 stem (10 ft)

Total stem count  
15 stem (151)  
1 stem (10')

Kelly 15 ft

18 ft difference  
in elevation plus  
hole vs. hole 5 of  
Foley which we have  
log for.

Start coring at 10:

Footage Marker	Depth
3	~100
4	103
5	104
6	105

10:42 am

Time

10:42 mud pressure 100 psi

10:55 color change in foam on mud pit

11:12 (dk gray-black) 102-103

11:40 mud pressure ~140 psi  
foam on mud black to  
pressure back down 100  
fine black film on  
top of water  
pulled down chain loose

continued next page

April 18, 1985 Pam Chaffee

7

Footage Marker	Depth (ft)	Time	Remarks
7	106	12:00 noon	mud pressure ~ 100 psi. <sup>sm. amt</sup> Black seum on top of water
7.7	106.7	12:17 pm	pull down chain loose again stop coring - pull stem

Recovered ~ 5 ft of shale & mud core. The core had to be removed from the small core barrel from the top end of the barrel (except the <sup>very</sup> bottom 3 inches of very hard (calc.?) shale); so explains the shape of the mud/shale ~~pieces~~ pieces w/ bits of wood.

PKC quit 1:45 pm

~~4-22-85  
start 11:13 -  
Foot marker Depth  
~ 7.07 106.7~~

4-19-85

Start at 106.7?

From  
Melia's  
Notes

1:56	4.2'	on Kelly
2:23	10'	on Kelly
	10½'	"
3:00	11'	on Kelly
3:28	11½'	"
3:44	12'	"
4:13	12½'	"

- pulled Barrel - full -

Drilled To ~ 116 - But did not pull all  
of Core - recovered ~ 9' Some Haskell  
in Bottom

4-22-85

Started 11:13

Foot made <del>to</del>	Depth	Time	Remarks
7.7	~ 116	11:13	Small Barrel in Haskell
8.7	~ 117	11:25	
9.0	~ 117.3	11:32	Drill quarter - Bottom of Haskell
11.0	~ 119	11:38	
12.0	120	11:40	← much chatter at 119 -
13.0	121	11:43	Top of Sandstone?
14.0	122	11:45	↑ smoother
15.0	123	11:47	no chatter
15.3	123.6	11:48	Fast drilling

recovered ~ 8' core



T. McLean  
 12:20 moved ~~to~~ from 116 to 122 at 2:10 pm

15.3'

Footmark	Depth	Time	
1.3	121	2:19	Big Barrel - smooth Drilling
2.0	2.3 --- 122	2:20	
3.0	3.3 --- 123	2:25	
4.0	4.3 --- 124	2:31	
5.0	5.3 --- 125	2:35	
6.0	6.3 --- 126	2:43	5.5 Drill chattering slightly
7.0	7.3 --- 127	2:52	5.8 " " " " " " " "
8.0	8.3 --- 128	3:00	6.5 Drilling smoother 5.5-6.5 hard zone
9.0		3:09	9.0 Drilling harder
<del>9.3</del>	129	3:14	stopped drilling to pull core

6 1/2	127	3:48	Small Barrel
7	127 1/2		
7 1/2			
8			
8 1/2			
9		3:56	
9 1/2			
10		4:00	
10 1/2			
11		4:07	
11 1/2	132	4:14	} Break woken leak. began again after repair - small leak again ~ 4:26 Big leak @ 4:27 - pulled core
~ 11 3/4		4:28	

Jane  
 Demo  
 +  
 P.A.M.

got ~ 4' of core out of small Barrel - ~ 2 feet ~~stuck~~ stuck  
in Barrel - quit for day - Try to get shale out of  
Barrel tomorrow

4/23/85

Started large Barrel

Footmark	Depth	Time	
1.4	131	12:53	
2.0			
3.0			
4.0		1:13	
5.0		1:27	
6.0		1:42	
7.0		1:56	7.5 harder zone Sandstone
8.0		2:08	↓ coming up in cuttings
9.0		2:21	
10.0		2:28	10.0 Harder
10.5	140	2:33	stopped drilling - pulled core

pulled core - recovered ~ 68' lost ~ 2.2'  
good coal at bottom of core

3.15  
10.3  
2.0  
1.50  
1.46  
6.50

4-23

Started small barrel at

Footmark	depth	Time
1	<del>138</del> 138	3:13 PM - dropped 1' in 1 minute
2	139	3:14 P
3	140	3:15 ← Coed fast To 3' - probably
4	141	3:18 2' piece of Big core left whole
5	142	3:23 from last Try
6	143	3:26
7	144	3:30
8	145	3:33
9	146	3:38
10	147	3:44 - 3:48 Stopped drilling - pulled core

Recovered 8' of core -  
 Reamed to 147 -  
 End of Day

4-24-85

9 x 15 = 135  
 1 x 10 = 145  
 1 x 15 = 15  
 160  
 (2' mark) - 13  
 147

Foot Mark	depth	Time
2	147	10:48
3	148	10:55
4	149	11:01
5	150	11:07
6	151	11:14
7	152	11:22
8	153	missed
9	154	11:37
10	155	11:45

Big Barrel - hand drilling  
 } drill chattering  
 } in zones of 2 or  
 } 3 inches  
 } further - may sand?

4-24 (cont)

Footmark	Depth	Time
11	156	11:53
11 1/2	156 1/2	11:57

pulled core Recovered 29.3' Whole core

Small Panel

Apr 24, 85

Foot	Depth	Time
12:55	start from 154 ft	
12:57	155	
5	155'	12:57
6	156	01:02
7	157	01:07

(Sapropelicous)

before reading 10 (29.8) rig stopped waiting for Ron to return with drinks resume at 1:40. Took all stems out

2:00 pm depth check Ron could not measure if He thinks we must be around 168 ft

Core recovery started. Difficulties in extracting core. Marios attempted depth measurement. ~~He~~ came up with ~168 ft (2:25 pm)

Recovered about 7 ft. of core  $\Rightarrow 156 + 7 = 163'$

4:00 pm Hole reamed by Mel estimated approx depth 162 ft which agrees with our estimated 163 ft.

2	162'	4:11
3	163'	4:24
4	164	4:40

Footmark	Depth	Time
5'	165'	4:55
6	166'	5:10
7	167'	5:26
8	168'	5:40

stop coring  
 5:44 pm cable broke  
 6:15 pm <sup>broken</sup> cable taken out of system

Pulled up Barrel no core - 162-168

4-25  
 fixed cable - went in with small barrel to  
 try to get core from yesterday - started coring

at 162 - cored to 166 - plugged - pulled small barrel  
 and cleared it out - decided to ream to 168' and  
 start fresh - 11/14

135  
 17  
 10  
 162

3'	168'	1:13
4'	169	1:25
5'	170	1:36
6'	171	1:48
7'	172	2:02
8'	173	2:14
9'	174	2:30
10'	175	2:48
11'	176	3:06

} started coring with 13' barrel  
 smooth to ~~2~~ 3 1/2' - noisy - harder dully.  
 hard and soft zones -  
 ← { Coal pieces in cuttings @ ~ 172-172 1/2'  
 Lower 5' 1/2' by coal

- stopped coring  
 pulled barrel - recovered 5.3' core  
 lower 5 1/2' by coal at bottom of core  
 Put in small barrel - plugged - put at 4 pm for day



4-26-85

Ran small Barrel down to 174' - barrel went  
down fast to ~ 175½ then slower - Small Barrel

Foot	Depth	Time	
7	174	8:50	fast 1'
8	175	8:51	slower ~ 175½
9	176	8:54	
10	177	9:00	
11	178	9:06	drills quiet - still in shale
12	179	9:11	" "
13	180	9:18	" "
14	181	9:24	" "
15	182	9:28	" "

Stopped @ 182 - pulled Barrel  
core slightly stuck - used water pressure -  
~ Top 2 feet of core (174-176) came out in order.  
176-182 Blew out and is not in good  
order except for ~ 181-182 which is probably  
good. Recovered about 6-7' core in pieces.  
Stopped - Sully due to Rain -

MONDAY 4-29-85

9.45 - REAMING of HOLE BEGINS

Started  $\frac{1}{16}$  at one ft

10.10 - REAMING DOWN TO 10 FT MARK

10.22 - Reaming DOWN TO 14 FT MARK

C. 10.30 - REAMED TO ALMOST 15 FT MARK (SHOULD BE AT A DEPTH OF 182.5 FT)

10.36 - BEGIN TO PULL UP REAMBIT.

11.16 - READY TO BEGIN THE LARGE CORER TOUCHED BOTTOM AT THE 2.2 FT MARK (= 182.5 FT)

182.5

1.8

192.3

11.23 - 3.0 FT MARK

11.31 - 4.0 FT MARK

4.8 - INCREASING BUCKING FOR A WHILE

11.35 5.0 FT MARK

11.39 6.0 FT MARK

11.43 7.0 FT MARK

11.46 8.0 FT MARK

11.48 9.0 FT MARK - INCREASED BUCKING

11.50 11 FT MARK

11.52 12 FT MARK - PULL UP CORE

CORE CAME OUT VERY NICELY - A LITTLE OVER 8 FT of core, TOP 8 inches are shale + fine sand lenses. Lower part is sandstone (TONKONOXIE)

12.51 - RESUME COREING, SMALL BORE, O<sub>MARK</sub> = 192.3 FT

12.55 - 2 FT MARK

12.57 - 3 FT MARK

1.00 - 4 FT MARK

1.02 - 5 FT MARK

1.06 - 7 FT MARK

James  
M. Calister

QUICK ROTATIONS

1.09 - 8 ft

1.12 - 9 ft MARK

1.13 - 9.2 ft - core retrieved

c. 5 feet of core was retrieved, - all sandstone / 0 mark = 192.3 ft  
9.2 mark = 201.5 ft

2.15 - START COREING → 4.2 ft MARK = 201.5 ft

2.16 - 5 ft MARK → SMALL CORE

2.22 - 7 ft MARK

2.25 - 8 ft MARK

8.5 - BUCKING for a 1/2 minute

2.28 - 9 ft MARK

2.30 - 10 ft MARK

2.32 - 11 ft MARK

2.35 - 12 ft MARK

2.38 13.2 ft MARK - CORE RETRIEVED

c. 5 ft of core, - sandstone with MINOR ORGANIC STREAKS,  
from a 9.0 ft section (201.5 to 210.5 ft)

Finished for Day @ 210.5'

4.2 ft MARK = 201.5  
13.2 ft MARK = 210.5

30 April

Started coring

at 10:37 AM Started @ ~ ~~215~~ 205

Foot 1	- 10:42 AM	
2	- 10:44 AM	Chattering at 1.8
3	- 10:49 AM	slight chattering
4	- 10:53 AM	quiet
5	- 10:58 AM	quiet
6	- 11:03 AM	Some chatter
7	- 11:09 AM	some chatter
8	- 11:11 AM	some chatter
9.5	- 11:13	some chatter

cored to 215

started at 12:25

Foot 7.0 - 12:25  
10 - 12:31  
11 - 12:46

stopped temporarily at 11 to clear bit  
because of slow progress  
12 - 1:05

stopped coring and pulled out @ 219

5-2-85 - Thu  
 Ran down to 218 - put on Big Barrel -  
 Started core @ 10-21

Foot	Depth	Time	
8	218	10:21	Drill chattering - no pull down
9	219	10:24	" ↓ pressure -
10	220	10:26	" only weight of
11	221	10:27	" stem + barrel
12	222	10:30	" on bit,
13	223	10:32	" easy smooth
14	224	10:34	" drilling
15	225	10:36	"

Pulled barrel - recovered 2.5' of poorly cemented  
 gray sandstone. - @ 1.2' of upper part of core already  
 cored by small barrel -  
 Several thin zones with plant remains (carbonized).  
 Bottom of core ~ 3-4 inches hanging out bottom of  
 core barrel.

put on small barrel - ran down to ~ 221 barrel stopped  
 on the 4' of last run - cored thru that foot < 1 min and started at  
 Foot Depth Time 3 marks

3	<del>225</del>	11:29	5 min 1/2 Drilling
4		11:32	
5		11:35	
6		11:39	

Foot	Depth	Time
7	229	11:42
8	230	11:48
9	231	11:55
9 1/2	231.5	11:59

Marker @ 6 1/2'

Stopped drilling @ 9 1/2'

by 3:34 we succeed in plugging small barrel  
and finding a bad throat bearing in a clutch.  
No core. Reamed to so we can start fresh  
Tomorrow.

234 ft

3  
 MAY 11 1985 (FRIDAY)  
 CORING - USING LG BORE

- 9.13 - START at 234 ft, about 1 ft above zero MARK
- 9.16 - 2 ft MARK
- 9.18 - 3 ft MARK
- 9.25 4 ft MARK - THE progress was very slow about 3.7 to 4.0
- 9.38 5 ft MARK progress CONTINUED slow till 5 ft mark
- 9.41 6 ft MARK - BACK TO "RAPID" PROGRESS, esp. after 5.5 ft
- 9.42 7 ft MARK
- 9.43 8 ft

HARD zone  
 23

8.5 - BUCKING of DRILL

9.44 - PULL UP CORE for 234 - 243.5 interval - 3 BOXES PUT IN

COALS SANDSTONE w/ shale and  
 IN MIDDLE. shale INTERCLASTS  
 ARE PRESENT IN S.S. some coal streaks  
 8 ft 7 in of retrieval core

10.56 - 1.5 ft MARK = 243.5 - Resume coring - small bore

10.58 - 4 ft MARK

11.00 - 5 ft MARK

11.05 - 6 ft MARK

11.09 - 7 ft MARK

11.12 - 8 ft MARK

11.16 - 9 ft MARK

11.24 - 10 ft mark

11.29 - 10.5 ft mark - pull up core -

Labelled this  
 "#1" in box

10.5  
 1.5  
 9.0 INTERVAL  
 ca 2.8 ft CORE recovered

Core is all Sandstone,  
 and Broken in 1-4 in  
 Segments

INTERVAL CORED 243.5 - 252.5

Top of core recovered at 12:00 noon.

Mark	Depth	Time
5	252'	12:45
6	253'	12:49
7	254'	12:58
8	255'	1:04
9/8.5	255.5	1:09

Mel is trying to go from 252 to 256' (5-9 markings)  
 to see if he could recover more core  
 of that partial recovery from 243.5 - 252.5  
 ← felt crunchy  
 stop to recover core

234  
 810.5  
 244.5  
 18.5  
 17.5  
 10.0  
 18.0  
 1.5  
 8.0  
 8.5  
 8.25  
 16.0  
 38.  
 1032.5

12.47

~~12.47~~  
~~12.47~~  
~~12.47~~

~ 1:50 pm - Recovered only ~ 1 ft. of core. Most in small pieces. Longest is 2 1/2 in. Box label calls this "#2".

Broke bit

Core should have been 246 - 255.5'

so return = 246 - 247 ???

Jamp  
Down

Material is gray ss w/ few small streaks or very thin layers of blk organics

Also cracked econo shoe, <sup>badly</sup> so stopped coring. <sup>or could have had new bit!</sup>  
There is already a new " " ordered, <sup>no \$16 here</sup> pm.

Ream hole to 247 - Begin putting stem back in ~ 2:30 pm

5-6-85

Big Barrel run down to 247' started & Coring @ 10:14  
New Bit on Big Barrel

Foot	Depth	Time
7	247	10:14
8	248	10:15
9	249	10:17
10	250	10:18
11	251	10:19
12	252	10:21
13	253	10:24
14	254	10:26
15	255	10:27
15 1/2	255 1/2	10:28



Pulled Barrel up - lost most of core - 2' <sup>big</sup> pieces with small barrel core out of them. Cleaned big Barrel and put back in hole to see what to do to recover lost core

15 x 15 = 225  
 1 x 10 = 10  
 1 x 15 = 15  
 250  
 + 5 on top of 250

Foot	Depth	Time
5	255	11:35
6	256	11:37
7	257	11:44
8	258	11:56
9	259	12:00
10	260	12:05

Did not Ream

} No pull down pressure - only wt. of stem + Barrel

} pull down on

pulled up at 12:05 - forgot to put steel ball on top of barrel - core washed body - recovered about 3 1/2 feet - core on 3" diameter - Did not ream - put Big Barrel back in to core more -

Foot	Depth	Time
5	260	1:10
6	261	1:12
7	262	1:15
8	263	1:18
9	264	1:21
10	265	1:25

pull down on - pull quiet

pull chatter at 263 1/2



stopped @ 265 - pulled Barrel - no core!!

Started drilling with  $4\frac{3}{4}$ " Bit at 265' -  
Took samples every foot - No core

265 - 55

266 55

267 55 + coal

268 L5

269 L5

270 L5 - End of stem

271 L5 new stem 3:32 pm

272 L5

273 L5

↓ all L5

281  $\frac{1}{4}$  - Drills quiet → Rock lab  
285 stopped drilling (in shale) 9:41 pm

5-7-85

~~285~~ started with  $4\frac{5}{8}$ " Bit at 286' - samples

6 286 10:38 sh only - NO core

7 287 10:43 sh

8 288 10:49 sh

9 289 10:59 sh

10 290 11:07 sh

11 291 11:13 sh

12 292 11:17 sh

13 293 11:29 sh

bleed hole

} not much pressure any, dull down  
very little cuttings

291  $\frac{1}{2}$  harder - chatter - lignite chips

hard drilling - chatter -

293 Bottom of hole

Drilled ~ 2' into Top of Tanager Limestone -  
Stopped and pulled stem up a few feet.  
Flushed Hole with ~ — gallons of Fresh  
Water.

Then pulled all stem <sup>out</sup> and started logging.  
Porogama & caliper - look good - quit  
for the Day -

5-8-85

afternoon logged hole - Ran SP-Res. -  
got decent logs - cleaned up site and  
made form for concrete pod. -


5-9-85 -

no logging - poured concrete for pod around  
well.

5-10-85

water level measured by Tuna  
86.75' below top of 8" casing

S Tanton Ls.

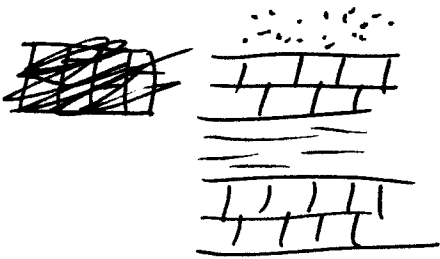

Tanganoxie

South Bend 1.5' - 5'

Rock lake 2' - 14' (av. 8) sh + ss, siltst.

Stoner 13' - 18'

TEST HOLE KU FISH PONDS #3

Test Hole located approximately 50' N of Foley Hall on west campus, KU.

T13S - R19E - 02 DAB - EL. 922

	<u>TIME</u>	
4/10-/85		4/10/85
0-33'		Drilled with 10" rollerbit - samples collected - no cores - upper part of hole weathered Lawrence shale - lower - gray shale calcaeous - hard. Hole drilled to 33' and 8" pvc surface casing installed and grouted in place from top to bottom. (0-33'). Allowed to harden for 48 hrs. Cement came up inside the casing to 31.5'.

---

measured Tom: 2/27/85  
Depth of holes south of Foley  
SW Hole with Bailer in it - 138'  
Hole with 3" pvc & with T - 235'  
Hole with 1 1/2" steel pipe - 7'  
Hole with 1 1/4 galvanized pipe at an angle  
25'

Drill Crew:

	<u>DEPTH</u>	<u>TIME</u>	
4/12/85	0-31.5'		
M.A.S			
	32.5'	12:16	
	33.5'	12:20	
	34.5'	12:29	
	36'	12:43	
	36.5'	12:49	Hard zone at 36.5
	37'	12:53	
	38'	1:01	
	39'	1:10	Mud turned very dark (shale?)
	40'	1:19	
	41'	1:27	
	42'	1:37	Core recovery approximately 43" - measured depth of hole 35' - went back in and recovered approximately 3 more feet - measured depth = 38' - reamed to 37 1/2' with 6 3/4" roller bit.
	38'	3:41	
	43.5'	4:11	Started coring at 38' with small barrel - stopped at 43 1/2. Retrieved about 57" of core.
4/15/85	43'	10:00	Started at approximately 10 a.m. - small barrel
P.A.M.			
	44.5'	10:15	Hard layer at 47
	47.5'	10:36	Hard layer at 48-48.4
	50.0'	11:18	Hard layer at 49.5-49.7
	51'	11:24	Pulled barrel to retrieve core - recovery?
	52'	11:30	Reamed from 38' to 52' with 6 3/4" rollerbit.
	52'	1:24	Started coring with large barrel at 52'.
	59'	2:25	Pulled barrel - <u>NO CORE</u>
		3:25 pm	Went in with large barrel to try and recover core from last run. (52'-59') Barrel dropped 5' then stopped.
R.Miller	60'	3:27 pm	Began coring at 60'.
	61'	3:32 pm	1' cored, (6' on tower) - smoother
	62'	3:39 pm	rattling - stopped coring - pulled core got core already cored by small barrel - tape measured to 49' (barrel was down to 62') - <u>got 1' of core from 52' - 62'</u> probably from very top.
		4:22 pm	Went in with large barrel and cable to try to retrieve core - 3 times - no luck.
		4:42 pm	Tried again with spring catcher on large barrel - stuck at 55' (no drilling). Total recovery?
4/16/85			Measured hole 54'.

M.A.S. & T.J.M.

DEPTH

TIME

Ran in large barrel to 63' - recovered core from approximately 53 to 63' (recovered approximately 80%) - 2 boxes marked 53' to 63' - Boxes 1 of 2 and 2 of 2 (4" core).

63.5

11:09

Started coring with small barrel at 63 1/2.

65.5

11:17

66.5

11:21

67.5

11:26

67.5-69

-

69-69 2/3

14 minutes

Stopped to clean plugged barrel - core recovery? Reamed to 70.5 with 6 3/4 roller. Started 4" barrel at 70.5.

70.5-72

-

72-73

14.5 minutes

73-74

14 minutes

74-75

18 minutes

75-76

-

73' - 77' took 45 minutes to drill.

76-77

-

77-77.5

Stopped drilling on big barrel at 4:38. Total of 7' - recovered?

4/17

P.A.M.

76.5-81.5

45

81.5-83.6

30

83-89.4

8:00 a.m. started coring with small barrel began at 76.5' - cored to 83.6 by 9:15 recovered \_\_\_\_\_ Reamed to 83.0 with Roller by 11:00 - began coring with big barrel from 83.0' - completed at 12:40 (no recovery) tried again and recovered some core - \_\_\_\_\_? Depth of hole 89.4' - used small barrel to start coring at 89.4' - finished coring at 4:10 p.m. (small barrel) - estimated depth 102' recovered \_\_\_\_\_?

4/18

P.K.C.

Started reaming at 9:22 with 6 3/4 roller bit- went to 93' at 9:38 continued reaming to 101' approximately 10 a.m. - stopped - put on small barrel.

Started coring approximately 10:42.

FOOT

DEPTH

TIME

3

102

10:42

4

103

10:55

5

104

11:12

6

105

11:40

7

106

12:00

7.7

106.7

12:17

Stopped

102'-103' mud press. 100 psi - color change in foam on mud pit (dark gray to black). Mud pressure 140 psi - black foam on pit-pressure dropped back to 100 psi - fine black film on pit - pull down chain loose - 106' mud press.

100 psi - small amount black scum on pit - pull down chain loose.

Recovered approximately 5' core (shale and mud). Core had to be removed from small barrel from the upper end except for the very bottom 3" of very hard (calc)? Shale

- pieces with bits of wood. - Quit at 1:45.

Started coring at 106.7

From Mel K's notes

<u>FOOT</u>	<u>DEPTH</u>	<u>TIME</u>	
4.2	106.7	1:56	
10		2:23	
10.5			
11		3:00	
11.5		3:28	
12		3:44	
12.5	115.0	4:13	Pulled barrel at 116' - full - drilled to approximately 116 - but did not pull all of core - Recovered approximately 9' - some Haskell Limestone in bottom.
7.7	116	11:13	Started coring at 116' approximately
8.7	117	11:25	11:13 a.m. with small barrel in Haskell Limestone.
9.0	117.3	11:32	- Drill quieter - bottom of Haskell
11.0	119	11:38	- Much chatter at 119
12.0	120	11:40	
13.0	121	11:43	121 top of sandstone? - smoother
14.0	122	11:45	drilling - no chatter - fast drilling.
15.0	123	11:47	
15.3	123.6	11:48	- stopped - pulled core - recovered 8'
		12:20	reamed from 116 to 122 from 12:20 to 2:10 p.m.
1.3	121	2:19	
2.0		2:20	
3.0		2:25	
4.0		2:31	
5.0		2:35	5.5' chattering slightly
6.0		2:43	5.8' chattering more
7.0		2:52	6.5' smoother (5.5-6.5 hard zone)
8.0		3:00	
9.0		3:09	9.0' Harder drilling.
9.3	129	3:14	Stopped drilling to pull core recovered _____?
6.5	127	3:48	Started coring with small barrel.
7			



7.5			Springleak just before 11 1/2 - stopped
8			at 4:20 (=11 3/4) to work on leak.
8.5			Began again after repair - small
9		3:56	leak again approximately 4:26 - <u>Big</u>
9.5			leak at 4:27 - pulled core -
10		4:00	<u>recovered approximately 4'</u> core from
10.5			small barrel approximately 2' still
11		4:07	stuck in barrel - quit for day - get
11.5	132	4:14	rest out tomorrow.
11.75		4:28	

4/23 Started coring with large barrel.

T.J.M.

<u>FOOT</u>	<u>DEPTH</u>	<u>TIME</u>
1.4	131	12:53
2	131.5	
3	132.5	
4	133.5	1:13
5	134.5	1:27
6	135.5	1:42
7	136.5	1:56
8	137.5	2:08
9	138.5	2:19
10	139.5	2:28
10.5	140	2:33

7.5 harderzone - sandstone coming up in cuttings.

10.0 harder - stopped drilling - pulled core recovered 6.8' lost approximately 2.2' - good coal at bottom of core.

1	138	3:13
2	139	3:14
3	140	3:15
4	141	3:18
5	142	3:23
6	143	3:26
7	144	3:30
8	145	3:33
9	146	3:38
10	147	3:44

- started coring at 138 (small barrel?)

- cored fast to 3' - probably 2' piece of big core left in hole from last try.

3:48 stopped drilling - pulled core recovered 8' of core - reamed to 147 - end of day.

4/24

T.J.M.

<u>FOOT</u>	<u>DEPTH</u>	<u>TIME</u>
2	147	10:48
3	148	10:55
4	149	11:01
5	150	11:07
6	151	11:14
7	152	11:22
8	153	
9	154	11:37
10	155	11:45
11	156	11:53
11.5	156.5	11:57

Started with big barrel - hard drilling - chattering - zones of 2 or 3 inches.

Started with big barrel - hard drilling - chattering - zones of 2 or 3 inches.

Stopped - pulled core - recovered approximately 9.3' - whole core!!

4/24  
M.A.S.

put on small barrel

FOOT	DEPTH	TIME
4	154	12:55
5	155	12:57
6	156	1:02
7	157	1:07
8	158	
9	159	
10	160	?
11	161	?
12	162	?
2	162	4:11
3	163	4:24
4	164	4:40
5	165	4:55
6	166	5:10
7	167	5:26
8	168	5:40

Much discussion about how deep is hole! Pulled barrel - recovered approximately 7' of core 156 + 7 = 162. Mel reamed to 162 +/- with roller. Started coring with big barrel @ 162'.

Stopped coring - 5:44 cable broke  
6:15 broken cable taken out of system - pulled barrel NO CORE 162-168.

4/25  
T.J.M.

3	168	1:13
4	169	1:25
5	170	1:36
6	171	1:48
7	172	2:02
8	173	2:14
9	174	2:30
10	175	2:48
11	176	3:06

Fixed cable - went in with small barrel to try to get yesterday's core - started at 162' cored to 166' and plugged bit - pulled barrel and cleaned it out - decided to ream to 168 and start fresh.  
11:14 - cored with big barrel - smooth to 3.5 - chatter and quiet after that (alternating) hard and soft zones coal pieces at 172-172.5 (lower sibley)? Stopped - pulled barrel - recovered 5.3' of core with lower sibley at bottom of core - lost lower part of coal and underclay.  
Put in small barrel - plugged it - quit for day.

4/26  
T.J.M.

7	174	8:50
8	175	8:51
9	176	8:54
10	177	9:00
11	178	9:06
12	179	9:11
13	180	9:18
14	181	9:24
15	182	9:28

Put on small barrel to 174' - went down fast to approximately 175.5 then slower.

Drill smooth and quiet.

Drills smooth and quiet; shale.

Drills smooth and quiet; shale.

Drills smooth and quiet; shale.

Drills smooth and quiet; shale.

Stopped at 182 - pulled barrel - upper 2 feet came out of top of barrel (174 - 176) - lower 6 feet (176 - 182) stuck in barrel - hooked up mud hose to top of barrel to force core out. Core blew out and got scrambled (176 - 181) - 181-182 probably in right order. Stopped drilling due to rain.

4/29			9:45 - 10:30 reamed hole with roller to 182.5 - put on large barrel.
James McCallister			
2.2	182.5	11:00	
3		11:23	
4		11:31	
5		11:35	
6		11:39	
7		11:43	
8		11:46	
9		11:48	
10			
11		11:50	
12	194.3	11:52	Stopped coring - pulled barrel Good core - approximately 8' - top 8" are shale and fine sand lenses. Lower part is sandstone (Tonganoxie).
0	192.3	12:51	Start coring with small barrel.
2		12:55	
3		12:57	
4		1:00	
5		1:02	
7		1:06	
8		1:09	
9		1:12	
9.2	201.5	1:13	Pulled barrel - retrieved approximately 5' core - all sandstone.
4.2	201.5	2:15	4.2' put small barrel back in - started coring
5		2:16	
7		2:22	
8		2:25	
9		2:28	Hard zone at 8.5 - (chatter).
10		2:30	
11		2:32	
12		2:35	
13.2	210.5	2:38	Pulled barrel - retrieved approximately 5' core - sandstone with minor organic streaks.
4/30			
P.A.M.			
0	205	10:37	Started coring at 10:37 approximately 205'.
1		10:41	
2		10:44	Chattering at 1.8'.
3		10:49	
4		10:53	Slight chattering then quiet.
5		10:58	Some chattering.
6		11:03	Some chattering.
7		11:09	Some chattering.
8		11:11	Some chattering.
9.5	215	11:13	Cored to 215' ? - pulled barrel retrieved _____" core.
7.0		12:25	Started coring again at 12:25
10		12:31	stopped temporarily at 11' to try to
11		12:46	clear bit - slow progress - bit

12 1:05 plugged stopped coring and pulled out at 219' samples in bags - core in pieces.

5/2 Reamed to 218 ( 6 3/4 roller) - put on  
T.J.M. big barrel - started coring at 10:21.

8 218 10:21  
9 219 10:24  
10 220 10:26

Drill chattering - no pulldown pressure - only weight of stem and barrel on bit. Easy smooth drilling.

11 221 10:27  
12 222 10:30  
13 223 10:32  
14 224 10:34  
15 225 10:36

Easy smooth drilling.

Easy smooth drilling.

Easy smooth drilling.

Easy smooth drilling.

Easy smooth drilling.

Stopped at 15 - recovered 2.8' of poorly cemented gray sandstone - at 1.2' of upper part of core already cored by small barrel - several thin (<1" zones with plant remains (carbonized). Bottom of core approximately 3" - 4" hanging out bottom of barrel when it was pulled up. Put on small barrel - ran down to 221' - barrel stopped on top of approximately 4' core of last run - cored thru that fast (<1 min) and started at 3' mark.

3 225 11:29  
4 226 11:32  
5 227 11:35  
6 228 11:39  
7 229 11:42  
8 230 11:48  
9 231 11:55  
9.5 231.5 11:59

Harder at 6.5

Stopped drilling at 9.5. Pulled barrel - recovered approximately 3' core - by 3:34 pm we succeeded in plugging small barrel and finding a bad throw out bearing in a clutch. No core on this run. Reamed to 234' so we can start fresh tomorrow.

5/3  
J. McCallister

-1 234 9:13  
0 235  
1 236  
2 237 9:16  
3 238 9:18  
4 239 9:25  
5 240 9:38  
6 241 9:41  
7 242 9:42  
8 243 9:43  
8.5 243.5 9:44

Coring with big barrel.

1.5 243.5 10:56  
4 246 10:58

Pulled barrel - retrieved 8'7" of core - put in 3 boxes - core is sandstone with shale bed in middle. Shale interclasts are present in sandstone - some coal stringers.

Put in small barrel.

5	247	11:00
6	248	11:05
7	249	11:09
8	250	11:12
9	251	11:16
10	252	11:24
10.5	252.5	11:29

Labelled #1 in box.

Pulled barrel (10.5' - 1.5' = 9.0') recovered approximately 2.8' core - all sandstone broken in 1" - 4" segments.

M.A.S.

5	252	12:45
6	253	12:49
7	254	12:58
8	255	1:04
8.5	255.5	1:09

Attempt to go from 252 to 256 (5-9 feet) to try to recover more core from the partial recovery from 243.5 to 252.5.

Stopped to try to retrieve core approximately 1:50 pm - recovered only approximately 1' of core. Most in small pieces. Largest is 2.5" long. Labelled the 5 - 8.5' run #2 in same box as 243.5 - 252.5. Broke the bit by drilling the last 6" with no water. (Attempt to plug bit and keep core in barrel). Core should have been 246 - 255.5 so return was 246 - 247??? Material is gray sandstone with few small streaks or very thin layers of organics. Cracked the econo shoe on bit so stopped coring or could have lost new bit. Reamed hole to 247' - began putting stem back in approximately 2:30 pm.

5/6

T.J.M.

7	247	10:14
8	248	10:15
9	249	10:17
10	250	10:18
11	251	10:19
12	252	10:21
13	253	10:24
14	254	10:26
15	255	10:27
15.5	255.5	10:28

Big barrel run down to 247' - started coring at 10:14 - new bit on big barrel.

Pulled up big barrel - lost most of core - approximately 2' of big pieces with small barrel cored out of them. Cleaned big barrel and went back into try to recover lost core. Did not ream.

TJM

5	255	11:35
6	256	11:37
7	257	11:44
8	258	11:56
9	259	12:00
10	260	12:05

No Pulldown Pressure on - only weight of stem & barrel - 5' - 8'  
Pulldown on 9' - 10'

Pulled up at 12:05 - forgot to put steel ball in top of barrel - core washed badly - recovered approximately 3.5' of core 3" diameter - did not ream. Put big barrel back on to core more.

TJM

5	260	1:10
---	-----	------

Pulldown on - drill quiet

6	261	1:12	Pulldown on - drill quiet
7	262	1:15	Pulldown on - drill quiet
8	263	1:18	263.25 chattering
9	264	1:21	Chattering continued
10	265	1:25	Chattering continued

Stopped at 265' - pulled barrel - no core!!\*? Made decision to core no more - finished hole with 4 3/4" roller. Take samples every foot.

265	SS	
266	SS	
267	SS & Coal	
268	LS	Chatter - Top of South Bend Limestone 268'
269	LS	
270	LS	End of stem
271	LS	New stem 3:37
272	LS	
273	LS	Chatter - all limestone 273-281 1/4
to		Quiet at 281 1/4 - top of Rocklake
281 1/4	LS	Shale - drilled about 4' of shale -
to	SH	stopped drilling for day at 4:41 pm
285		4:41 pm

5/7/85  
TJM

6	286	10:39	SH	Started drilling with 4 3/4" bit at
7	287	10:43	SH	286 - samples only no core - black and
8	288	10:49	SH	gray shale down to 291.5 not much
9	289	10:59	SH	pressure on pulldow very little cuttings.
10	290	11:07	SH	
11	291	11:13	SH	
	291.5		SH	

12            292            11:17  
13            293            11:29

291.5 harder - chatter - limestone chips  
Stoner limestone @ 291.5  
293 bottom of hole. Drilled about 2 feet into top of  
stoner limestone - stopped and pulled up stem a few feet  
- flushed hole with approximately \_\_\_\_\_ gallons of  
fresh water to clear mud. Pulled stem out and started  
logging. Ran Gamma and Caliper - looks good, quit for  
day.

5/1/85 - Afternoon - logged hole - ran SP-Re5, got decent  
logs - cleaned up site and made form for concrete pad.

5/9/85 - no logging - poured concrete pad around base.

5/10/85 - measured W.L. - 86.75' below top of 8" casing.

①

# Test Hole KU Fishponds #3

Test hole ~~cored~~ located approximately 50' N of Foley Hall on west campus, KU.

T135 - R19E - 02 OAB - E/ 922.

4-10-85

4-10-85 <sup>7pm</sup>

0-33' Drilled with 10" roller bit - samples collected - no cores. - upper ~~part~~ of hole weathered Lawrence shales - lower - gray shale calcareous - hard. Hole drilled to 33' and 8" pvc surface casing <sup>casing?</sup> installed and grouted in place from top to bottom. (0-33'). Allow to harden for 48 hrs. Cement came up in casing to 31.5'

4-12-85

start page ① here



4-12-85

0-1	0-31.5		Drilled with 10" bit - surface casing installed -
1-2	31.5-32.5		
2-3	32.5-33.5	4 min	
3-4	33.5-34.5	9 "	
4-5	34.5-36	13 "	
5-6	36-36.5	6 "	hard pan at 36.5
6-7	36.5-37	4 "	
7-8	37-38	8	
8-9	38-39	9	- mud turned very dark -
	39-40	9	
	40-41	8	
	41-42	10	

MAS  
↑

~~Reamed~~ core recovery  $\approx 3'$  - measured depth of Hole 35' - went back in + recovered ~3 more feet - meas. Depth = 38' - Reamed to 37 1/2' with 6 3/4" bit. Started casing @ 38' ~~stopped at 43.5'~~ with small bit - stopped at 43 1/2'

~~4-15-85~~ 38-43 1/2 30

4-15-85  
43-44 1/2 10  
44.5-47.5 21

started at ~10 AM - small barrel  
hard  
hard layer @ 47  
" " @ 48-48.4  
" " @ 49.5-49.7

P.A.M.  
47.5-50 42  
50-51 6  
51-52 6  
52-59 50

pulled barrel to retrieve core -  
reamed from 38 to 52 with 6 3/4"  
started casing with large barrel  
Pulled barrel - no core -

4-15 (cont)  
Rachael Miller

3:25pm - went in with large barrel to try & recover core from last run

3:27 began coring

61' 3:32 1' cored 6' on tower - smoother

62' 3:39 rattling - stopped - pulled core  
got core already cored by small barrel -  
Tape measured to 49' (barrel was down to 62') - got 1' of core from 52'-62'  
~~4:22~~ probably from very top

4:22 - went in with large barrel/cable to try to retrieve core - 3 times - no luck

4:42 Tried again with spring catcher on large barrel - stuck at 55' (no drilling)

4-16 -  
MAS &  
TJM

- measured Hole 54'

- Ran in large barrel to 63' - recovered core from 253 to 63' (recovered ~80%) - 2 boxes marked 53' to 63' - Boxes 1 & 2 & 292 -

11:09 started coring with small barrel @ 63 1/2

63.5-65.5	8
65.5-66.5	3 1/2
66.5-67.5	5
67.5-69	-
69-69 2/3	14

- stopped to change barrel -  
Core recovery?

Reamed to 70.5 with 6 3/4 Roller  
Started 4" barrel @ 70.5

70.5 - 72	-
72 - 73	14.5
73 - 74	14
74 - 75	18
75 - 76	-
76 - 77	-
77 - 77.5	-

73'-77' took 45' to drill

Stopped Drilling on big barrel @ 4:38  
Total of 7' - Recovered?

4-17  
PAM

8:00 am started coring with small barrel  
 76.5 - 81.5 45 began at 76.5' - cored to 83.6 (to) 9:15  
 81.5 - 83.6 30 Recovered \_\_\_\_\_?  
 Reamed to 83.0 with Roller by 11:00 -  
 83 - 89.4 began Coring with big barrel from 83.0' -  
 Completed at 12:40 (no recovery) Tried  
 again and recovered some core - \_\_\_\_\_?  
 Depth of Hole 89.4' - used small barrel  
 to start coring at 89.4' - finished coring  
 @ 4:10 pm (small barrel) - estimated Depth 102'  
 Recovered \_\_\_\_\_?

4-18  
P.K. Chaffee

9:22 - started reaming - went to 93' @ 9:38  
continued reaming to 101' ~ 10 am - stopped -  
Put on small barrel -

4-18 (cont)  
P.K.C.

Started Coring ~ 10:42

Foot	Depth	Time
3	102	10:42
4	103	10:55
5	104	11:12
6	105	11:40
7	106	12:00
7.7	106.7	12:17
Stopped		

← mud press. 100 psi - color change in foam on mud pit (dark gray to black) 102-103

← mud pressure 140 psi - black foam on pit  
 Pressure dropped back to 100 psi - Fine black film on pit - Pull down chain loose -  
 106' - mud press. 100 psi - small amt black scum on pit - pull down chain loose

Recovered ~ 5' core (shale + mud). Core had to be removed from small barrel from the upper end except for the very bottom 3" of very hard (calc) shale - so explains the shape of the mud/shale pieces w/ bits of wood. -  
 Quit at 1:45

4-19  
~~From~~  
From M. O. K.'s  
Notes

Started coring @ 106.7

Foot	Depth	Time
4.2	106.7	1:56
10	<del>106</del>	2:23
10 1/2		
11		3:00
11 1/2		3:28
12		3:44
12 1/2	115.0	4:13

- pulled barrel - Full - Drilled to ~ 116 - but did not pull all of core - Recovered ~ 9' - some Haskell ls in Bottom -

4-22

Started Coring ~ 11:13 am w/ small  
barrrel in Haskell ls

Time	Foot	Depth	Time	
	7.7	116	11:13	
	8.7	117	11:25	
	9.0	117.3	11:32	quarter - Drill <u>quieter</u> bottom of Haskell
	<del>11.0</del> 10.8	~119	11:38	- much chatter @ 119
	12.0	120	11:40	
	12.0	121	11:43	sandstone 121 Top of sandstone? - smoother
	13.0	122	11:45	drilling - no chatter - <u>fast</u> drilling foot
	15.0	123	11:47	
	15.3	<del>123.6</del> 123.6	11:48	- stopped - pulled Core - recovered 8'
	<del>18.5</del>	<del>124.5</del>		

12:20 Reamed from 116 to 122 @ 2:10 pm

Big barrel - smooth Drilling

Foot	Depth	Time	
1.3	121	2:17	
2.0		2:20	
3.0		2:25	
4.0		2:31	
5.0		2:35	5.5 chattering slightly
6.0		2:43	5.8 " more
7.0		2:52	6.5 smoother 5.5-6.5 hardens
8.0		3:00	
9.0		3:09	9.0 Harder Drilling
<del>9.3</del> 9.3	129	3:14	Stopped Drilling to pull Core recovered —?

JED  
+  
P.A.M.

Foot	Depth	Time
6 1/2	127	3:48
7		
7 1/2		
8		
8 1/2		
9		3:56
9 1/2		
10		4:00
10 1/2		
11		4:07
11 1/2	132	4:14
11 3/4		4:28

3:45 started coring w/ small barrel

sprung leak (dent) before 11 1/2 - stopped at 4:20 (= 11 3/4) to work on leak. Began again after repair - small leak again ~ 4:26 - Big leak @ 4:27 - pulled core - recovered ~ 4' core from small barrel ~ 2' still stuck in barrel - quit for day - get rest out tomorrow -

4-23

Tfm

Foot	Depth	Time
1.4	131	12:53
2	~131.5	
3	132.5	
4	133.5	1:13
5	134.5	1:27
6	135.5	1:42
7	136.5	1:56

started coring w/ large Barrel

4-23  
(cont)  
Tfm

Foot	Depth	Time
8	137.5	2:08
9	138.5	2:19
10	139.5	2:28
10.5	140	2:33

7.5 hard zone - sandstone coming up in cuttings  
 10.0 harder -  
 stopped drilling - pulled core  
recovered 6.5' lost - 2.2'  
 good coal at bottom of core  
 coal?

Foot	Depth	Time
1	138	3:13
2	139	3:14
3	140	3:15
4	141	3:18
5	142	3:23
6	143	3:26
7	144	3:30
8	145	3:33
9	146	3:38
10	147	3:44

- started carry @ 138 (small barrel?)  
 Foot?  
 - cored foot to 3' - probably 2' piece of big core left in hole from last try.

3:48 stopped drilling - pulled core recovered 8' of core -  
 Reached to 147 - End of Day

4-24  
Tfm

Foot	Depth	Time
2	147	10:48
3	148	10:55
4	149	11:01
5	150	11:07

started with Big Barrel - Hand drilling - chattering - zones of 2 or 3 inches -

4-24 (cont)

TJM

Foot	Depth	Time
6	151	11:14
7	152	11:22
8	153	-
9	154	11:37
10	155	11:45
11	156	11:53
11 1/2	156 1/2	11:57

Stopped - pulled core - Recovered ~ 9.3' - Whole Core - !!

put on small barrel

4-24 (cont)

MAS

Foot	Depth	Time
4	154	12:53
5	155	12:57
6	156	1:02
7	157	1:07
8	158	
9	159	
10	160 ?	
11	161 ?	
12	162 ?	

Much discussion about how deep is hole!  
Pulled Barrel - recovered ~ 7' of Core  
156 + 7 = 162  
Mel Reached to 162 ± with Roller

2	162	4:11
3	163	4:24
4	164	4:40
5	165	4:55
6	166	5:10

Corey with big Barrel



4-24  
(Cont)  
MAS

Foot	Depth	Time
7	167	5:26
8	168	5:40

- 5 Topped Coring -  
 5:44 Cable Broke - 6:15 broken cable  
 Taken out of system - Pulled Barrel  
NO CORE 162-168

4-25  
TJM

3	168	1:13
4	169	1:25
5	170	1:36
6	171	1:48
7	172	2:02
8	173	2:14
9	174	2:30
10	175	2:48
11	176	3:06

Fixed Cable - went in with small barrel to try to  
 get yesterday's core - started @ 162' cored  
 to 166' + plugged bit - Pulled barrel and  
 cleaned it out - Decided to ream to 168 and  
 start fresh. 11:14 -  
 Cored with big barrel - smooth to 3 1/2' - chatter  
~~and~~ and quiet after that (alternating)  
 hard & soft zones  
 hard and soft zones  
 coal pieces @ 172-172 1/2' (lower Sibloy)?  
 - stopped - pulled barrel - recovered 5.3'  
 of core with lower Sibloy at bottom of  
 core - <sup>lost</sup> lost lower part of Coal and underclay  
 put in small barrel - plugged it - quit for day.

4-26  
TJM

7	174	8:50
8	175	8:51
9	176	8:54
10	177	9:00
11	178	9:06

put on small barrel to 174' - went down  
 foot to ~175 1/2' then slower  
 Drill smooth & quiet

4-26 (cont)

Tfm

Foot	Depth	Time
12	179	9:11
13	180	9:18
14	181	9:24
15	182	9:28

Drills smooth + quiet - still in shale  
 " " "  
 " " "  
 " " "

stopped at 182 - pulled Barrel - ~~core stuck in Barrel~~ - hooked mud hose to upper end of barrel to force core out - upper 2 feet came out of Top of Barrel (174-176) - lower 6 feet (176-182) stuck in Barrel - Hooked up mud hose to top of Barrel to force core out. Core Blew out and got scrambled (176-181) - 181-182 Probably in right order. -  
 Stopped Drilling due to rain

4-29

James McCallister

2.2	182.5	11:
3.0		:23
4.0		:31
5		:35
6		:39
7		:43
8		:46
9		:48
10		:50
11		:50
12	194.3	11:52

9:45 - 10:30 reamed hole with Roller To 182.5'  
 put on large Gauge

- stopped coring - pulled barrel -

4-29 (cont)  
James  
McCallister

good core - approx 8' - Top 8" are shale  
and fine sand lenses. lower part is sandstone  
(Tonganoxie) ← Tonganoxie?  
start coring with small barrel

Foot	Depth	Time
0	192.3	12:51
2		12:55
3		12:57
4		1:00
5		1:02
7		1:06
8		1:09
9		1:12
9.2	201.5	1:13
4.2	201.5	2:15
5		2:16
7		2:22
8		2:25
9		2:28
10		2:30
11		2:32
12		2:35
13.2	210.5	2:38

pulled barrel - retrieved ~5' core - all sandstone

put small barrel back in - started coring

hard zone @ 8.5 - (chatter)

- pulled barrel - retrieved ~5' core -  
sandstone w/ minor organic streaks

End of Day

4-30  
PAM.

started coring @ 10:37  $\approx$  ~~210'~~ <sup>205'</sup> (cor. by PAM)

Foot	Depth	Time
1		10:41
2		10:44
3		10:49
4		10:53
5		10:58
6		11:03
7		11:07
8		11:11
9.5		11:13

chattering @ 1.8'  
 slight " then quiet  
 quiet  
 some chattering  
 " "  
 " "

Cored to 215' ? - pulled barrel  
retrieved \_\_\_\_\_' core

7.0		12:25
10.		12:31
11		12:46
12		1:05

started coring again @ 12:25

stopped temporarily @ 11 to try to clear bit -  
 slow progress - bit plugged  
 stopped coring and pulled out @ 219'  
 samples in bags - core in pieces -  
bags?

5-2

7m

Reamed to 218<sub>1</sub> - put on big barrel - started  
~~6 3/4 roller~~ convey @ 10:21

Foot	Depth	Time
8	218	10:21
9	219	10:24
10	220	:26
11	221	:27
12	222	:30
13	223	:32
14	224	:34
15	225	:36

Drill chattering - no pull-down pressure - only weight of stem and barrel on bit.

Easy smooth Drilling.

stopped @ 15 - recovered 2.8' of poorly cemented gray sandstone - @ 1.2' of upper part of core already cored by small barrel - several thin < 1" zones with plant remains (carbonized). Bottom of core ~ 3"-4" hanging out bottom of barrel when it was pulled up.

Put on small barrel - ran down to 221' - barrel stopped on top of ~ 4' cone of last run. - cored thru that foot (< 1 min) and started at 3' mark

3	225	11:29
4	226	11:32
5	227	:35
6	228	:39
7	229	:42
8	230	:48
9	231	:55
9.5	231.5	:59

harder @ 6 1/2

stopped drilling @ 9.5

pulled barrel - recovered ~ 3' core -  
by 3:34pm we succeeded in plugging small  
barrel and finding a good throwout bearing in  
a clutch. No core on this run. - Reamed  
to 234' so we can start fresh tomorrow.

5-4

J. McCallister Foot depth Time Core up with big barrel -

-1	234	9:13
0	235	
1	236	
2	237	9:16
3	238	9:18
4	239	:25
5	240	:38
6	241	:41
7	242	:42
8	243	:43
8.5	243.5	:44
9		<del>9:44</del>

pulled barrel - retrieved 8'7" of core -  
Put in 3 boxes - Core is sandstone w/  
shale bed in middle. shale interclasts are  
present in s.s. - some coal stringers.

1.5	243.5	10:56	Put in small barrel -
4	246	:58	
5	247	11:00	
6	248	:05	
7	249	:09	

5-4 (cont)  
J. M. Callister

Foot	Depth	Time
8	250	11:12
9	251	:16
10	252	:24
10.5	252.5	:29

} labelled #1 in Box

pulled barrel -  $\frac{10.5}{1.5} = 9.0$  intervals -  
recovered ~ 2.8' core - all ss. broken in  
1-4" segments

MAS

5	252	12:45
6	253	:49
7	254	:58
8	255	1:04
8.5	255.5	:09

Attempt to go from 252 to 256  
(5-9 feet) To try to recover more core  
from the partial recovery from 243.5 to  
252.5.

- stopped to try to retrieve core.  
~ 1:50 recovered only ~ 1' of core. most  
in small pieces. largest is 2.5" long.  
labelled the 5-8.5' run # 2 in  
same box as 243.5-252.5.

Broke the Bit by drilling the last 6" with no  
water. (Attempt to plug bit and keep core in  
barrel). Core should have been 246-~~255.5~~<sup>255.5</sup>  
so return was 246-247 ??? material  
is gray ss with few small streaks or very thin  
layers of organics. Cracked the Econo shoe  
on Bit so stopped coring ~~or~~ could have lost  
new bit.

Reamed hole to 247' - began ~~being~~ putting  
stem back in ~ 2:30 pm.

5-6  
Jm

Big barrel run down to 247' - started coring  
to @ 10:14 - new bit on big barrel. -

Foot	Depth	Time
7	247	10:14
8	248	:15
9	249	:17
10	250	:18
11	251	:19
12	252	:21
13	253	:24
14	254	:26
15	255	:27
15.5	255.5	:28

pulled up big barrel (- lost part of  
core - ~ 2' of big pieces w/ small  
barrel cored out of them. cleaned big  
barrel and went back in to try to recover  
lost core. Did not Ream.

5	255	11:35
6	256	:37
7	257	:44
8	258	:56
9	259	12:00
10	260	12:05

} no pull down pressure - only (cut) of  
stem & barrel  
} pull down on

pulled up @ 12:05 - forgot to put  
steel Ball in Top of Barrel - core  
washed Body - recovered ~ 3.5' of  
core 3" diameter. - Did not Ream.



put big barrel back in to ~~7~~ <sup>core</sup> more

Foot	Depth	Time	
5	260	1:10	Pulldown on - Drill quiet
6	261	:12	" "
7	262	:15	" "
8	263	:18	263.25 chattering
9	264	:21	" cont.
10	265	:25	" "

stopped at 265' - NO core !!  
 made decision to core no more - finish hole  
 with 4 1/2" roller. - Take samples every foot.

265	SS
266	SS
267	SS + coal
268	LS
269	LS
270	LS
271	LS
272	LS
273	LS
<hr/>	
↓	all LS
281 1/4	sh
285	sh

chatter  
 |  
 End of stem  
 new stem 3:37  
 ↓  
 chatter  
 ↓

quiet at 281 1/4 - Top of Rocklake shale  
 stopped Drilling for day - shale 4:41

5-7-85	Foot	Depth	Time	Started Drilling with 4 3/4" bit @ 286
	6	286	10:39	Samples only no core - Black and gray
	7	287	:43	shale down to 29 1/2
	8	288	:49	Not much pressure on pull down Very little Cuttings
	9	289	:59	
	10	290	11:07	
	11	291	:13	29 1/2 harder - chatter - limestone stones chips -
	12	292	:17	
	13	293	:29	
		293		Bottom of Hole -

Drilled about 2 feet into top of Stoner limestone -  
 stopped and pulled up stem a few feet - flushed hole  
 with ~ gallons of Fresh water to clear mud.  
 pulled stem out and started logging. Ran Gamma  
and Coliper - looks good quit for day.

5-8-85 Afternoon - logged hole - Ran SP-Res, got decent  
 logs - cleaned up site and made form for concrete  
 pad.

5-9 No logging - poured concrete ~~and~~ pad around base -

5-10-85 Meas w.l. - 86.75' below top of 8" casing (casing?)

June 03, 85

# PERMEABILITY TEST

SITE 13-19-2 OAB  
Fishponds #3

SS. sample  
SAMPLE # \_\_\_\_\_

DEPTH INTERVAL 201.5 To 210.5

Sample diameter (D) = ~~5.290~~  $\frac{4.4 + 4.45 + 4.5 + 4.45}{4} = 4.45$  cm.  
 Sample length (L) = 2.90 cm.  
 Sample X-sectional Area (A) =  $\frac{\pi}{4} D^2 = \frac{\pi}{4} (4.45)^2 = 15.55 \text{ cm}^2$   
 Sample volume (V) =  $\sum D^3 * L = 66.169 \text{ cm}^3$ .  
 Hydraulic Head (H) = 20.1 cm.  
 Permeability Data


Run #	Time (min)	Volume of Water collected (ml or cm <sup>3</sup> )	$Q = \frac{\text{Vol. of water}}{\text{Time}}$	$K = \frac{Q}{A} * \frac{L}{H}$ (cm/min)
1	3'-01"	10	3.33	3.09276 $\times 10^{-4}$
2	3'-00"	10	3.33	
3	3'-00"	10	3.33	
4	3'-00"	10	3.33	
5	3'-00"	10	3.33	
6	3'-00"	10	3.33	
7	3'-00"	10	3.33	


Avg K =  $\frac{K_1 + K_2 + \dots + K_n}{n}$

Water Temp = 24°C.


Avg K =  $3.09276 \times 10^{-4}$  cm/min  
 =  $5.1546 \times 10^{-4}$  cm/sec  
 = 1.85 cm/hr

$1 \text{ cm/day} = .2454 \frac{\text{ft}^2 \text{ day}}{\text{ft}^2}$   
 $44 \text{ cm/day} = 10.89 \frac{\text{ft}^2 \text{ day}}{\text{ft}^2}$   
 $44.5557 \text{ cm/day} = 1.46 \text{ ft/day}$

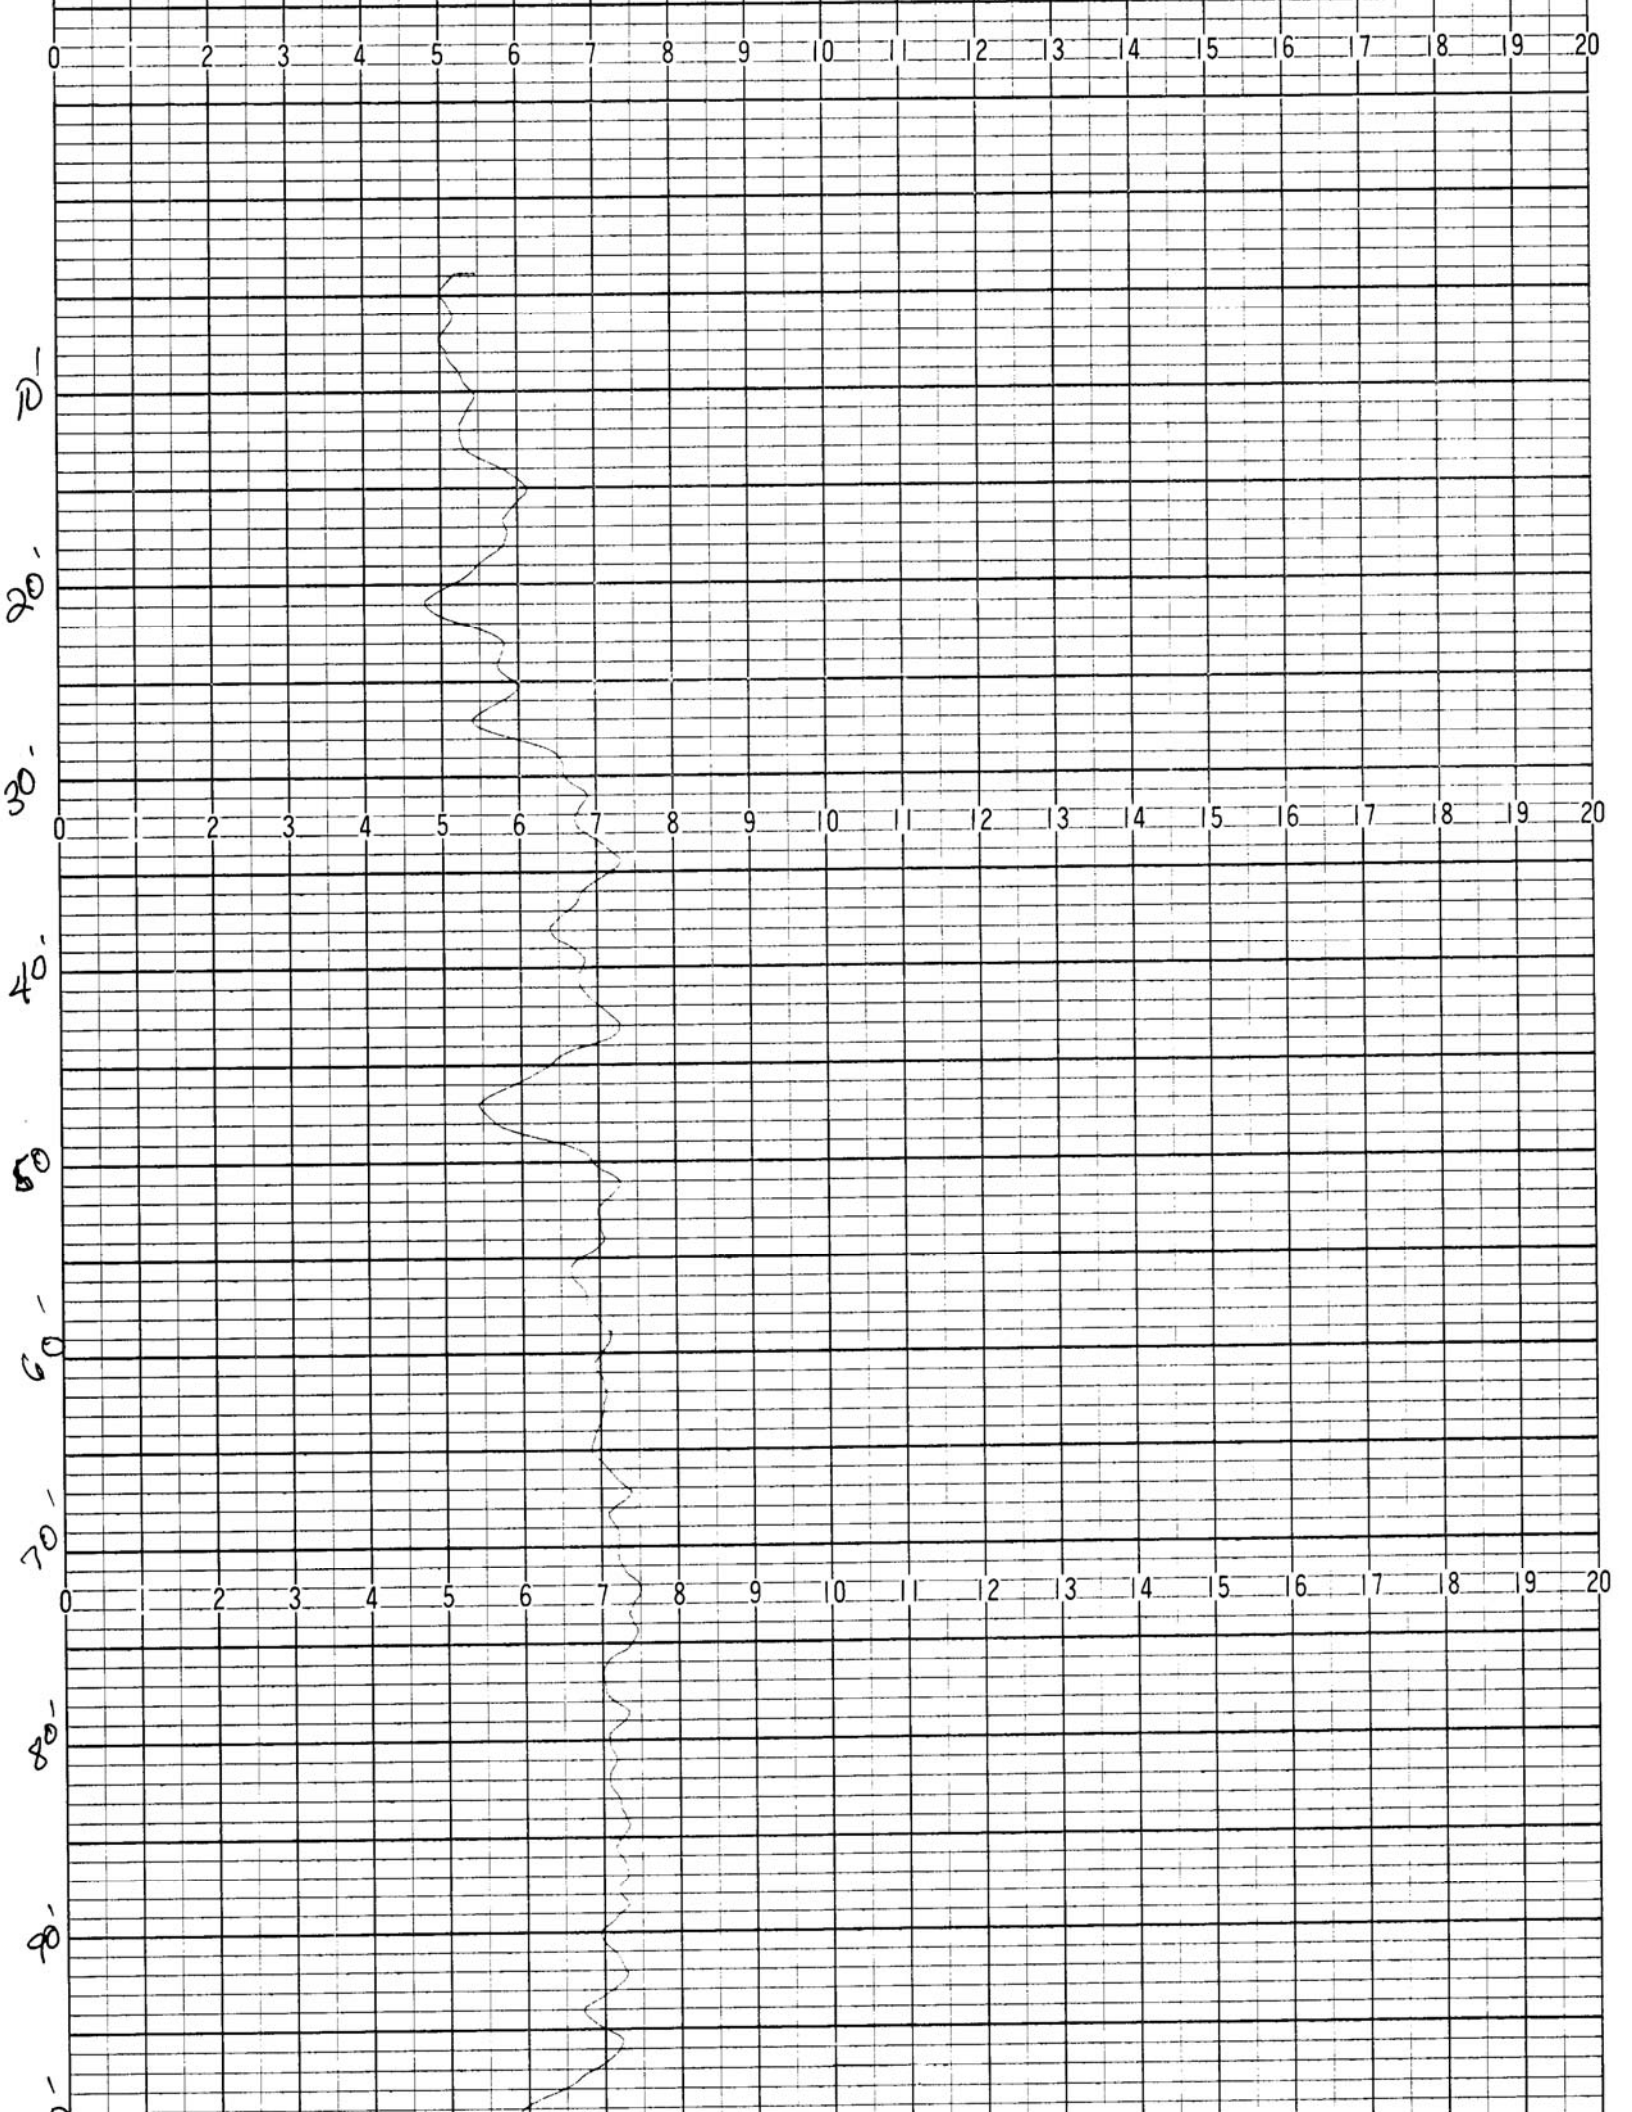

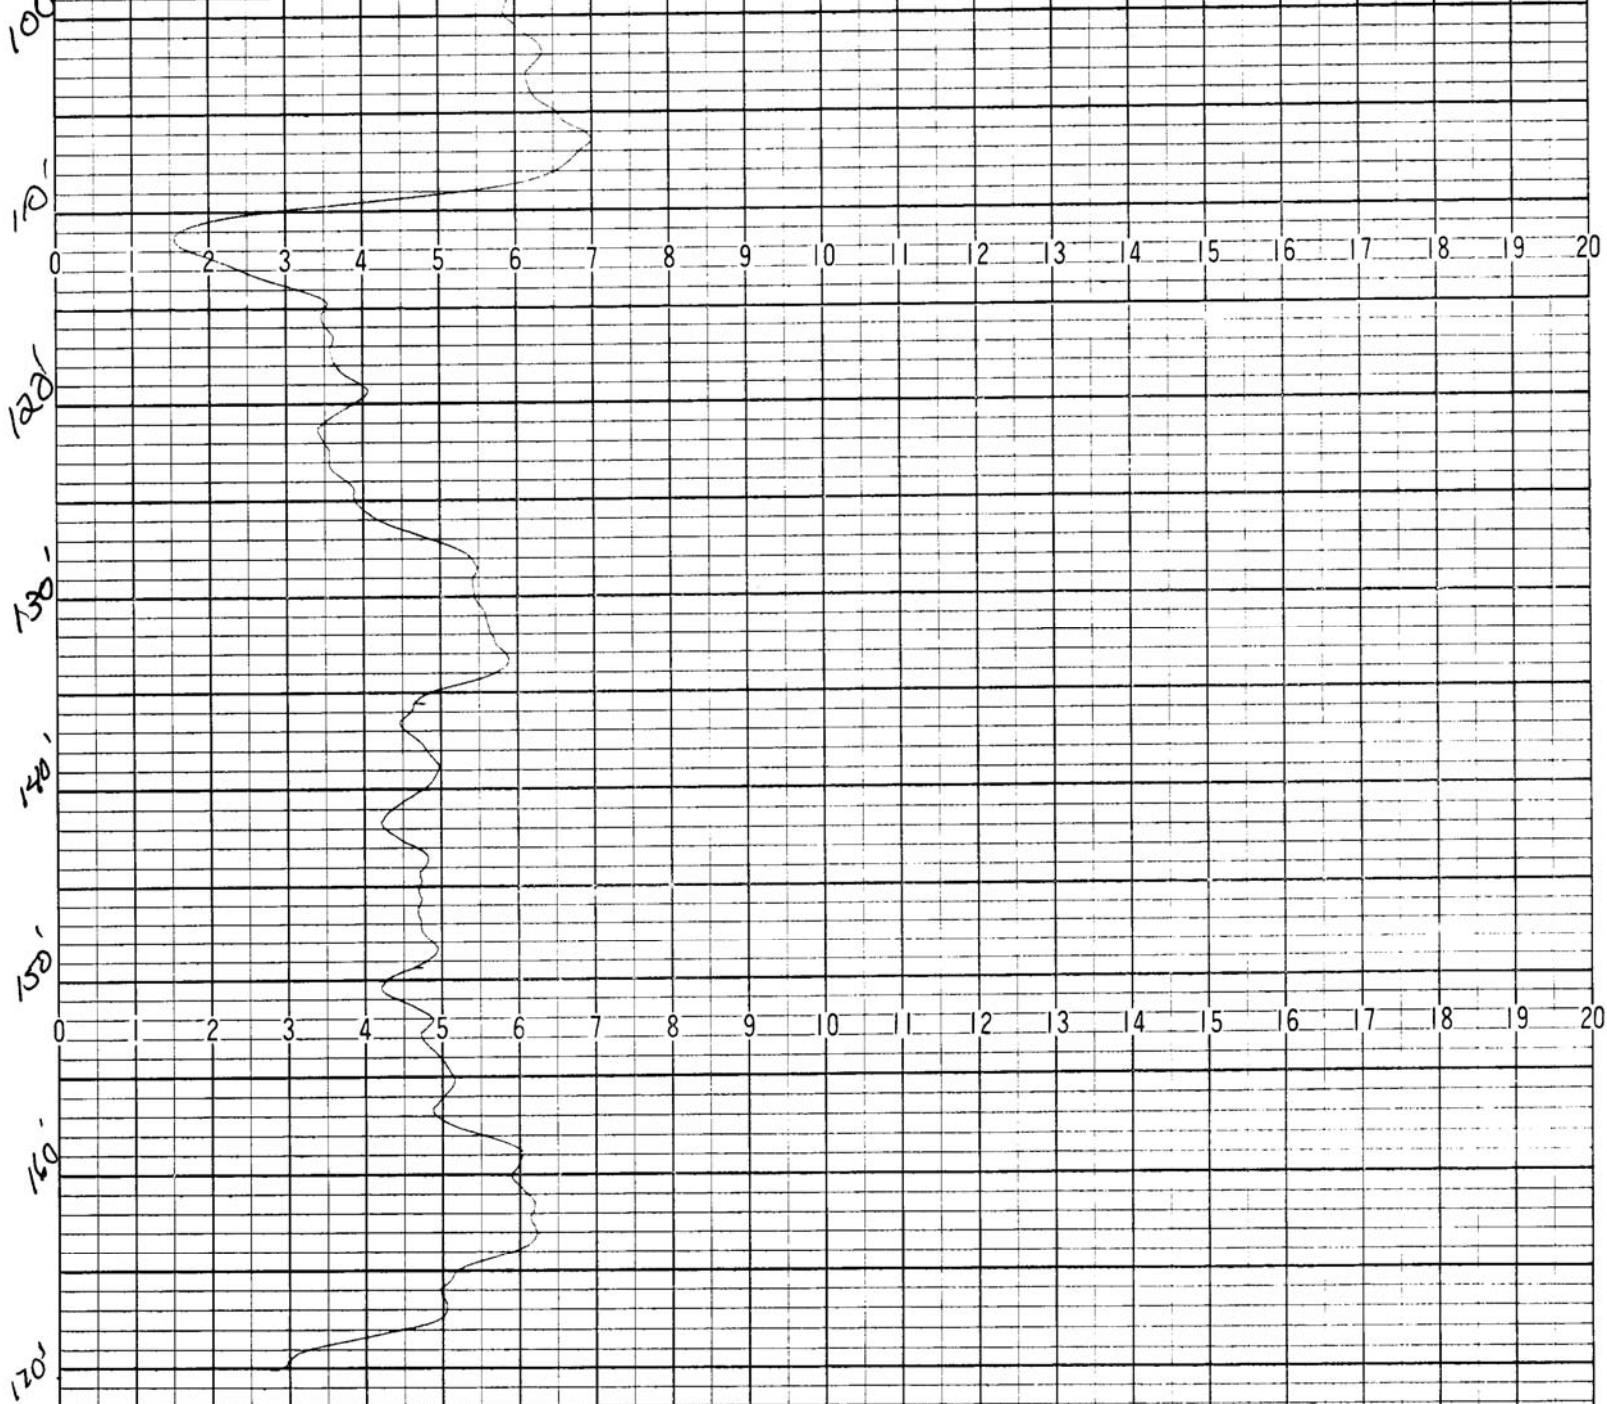

TEST  
 WBL  
 G-20X40mm  
 1-13-97  
 20 sec  
 20 CPS  
 0-DIS PLAGE  
 0-DIFF  
 CALIB: 587  
 0+SPAN

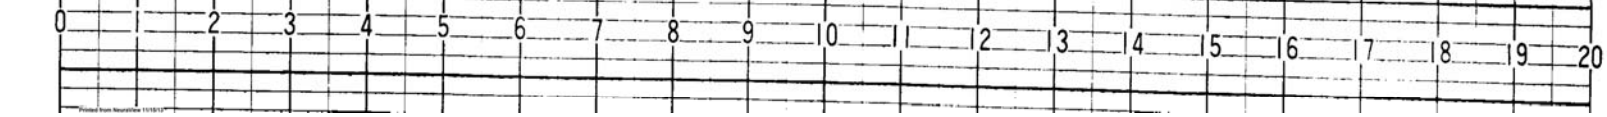





0 1 2 3 4 5 6 7 8 9 10 11 12 13 14 15 16 17 18 19 20

0 1 2 3 4 5 6 7 8 9 10 11 12 13 14 15 16 17 18 19 20

0 1 2 3 4 5 6 7 8 9 10 11 12 13 14 15 16 17 18 19 20

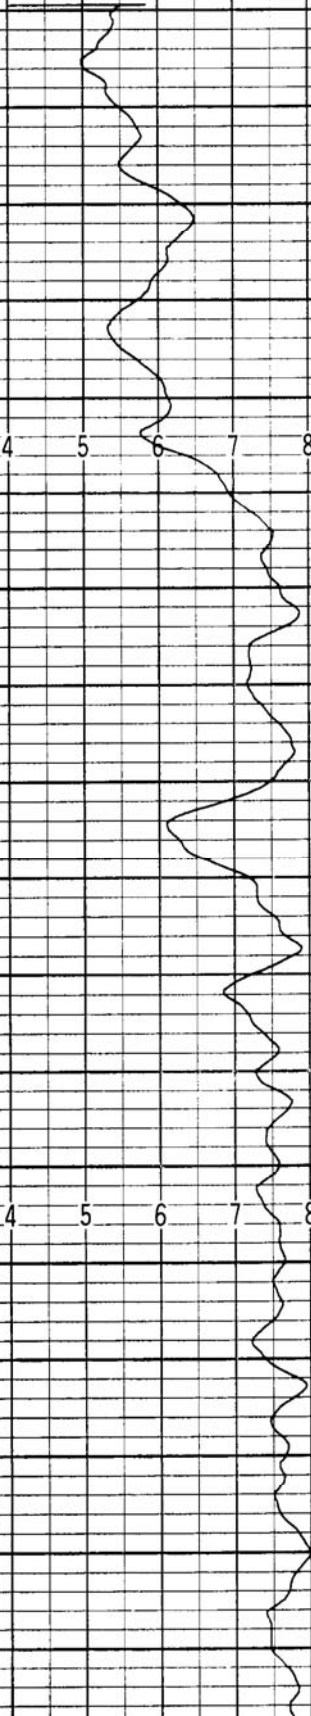

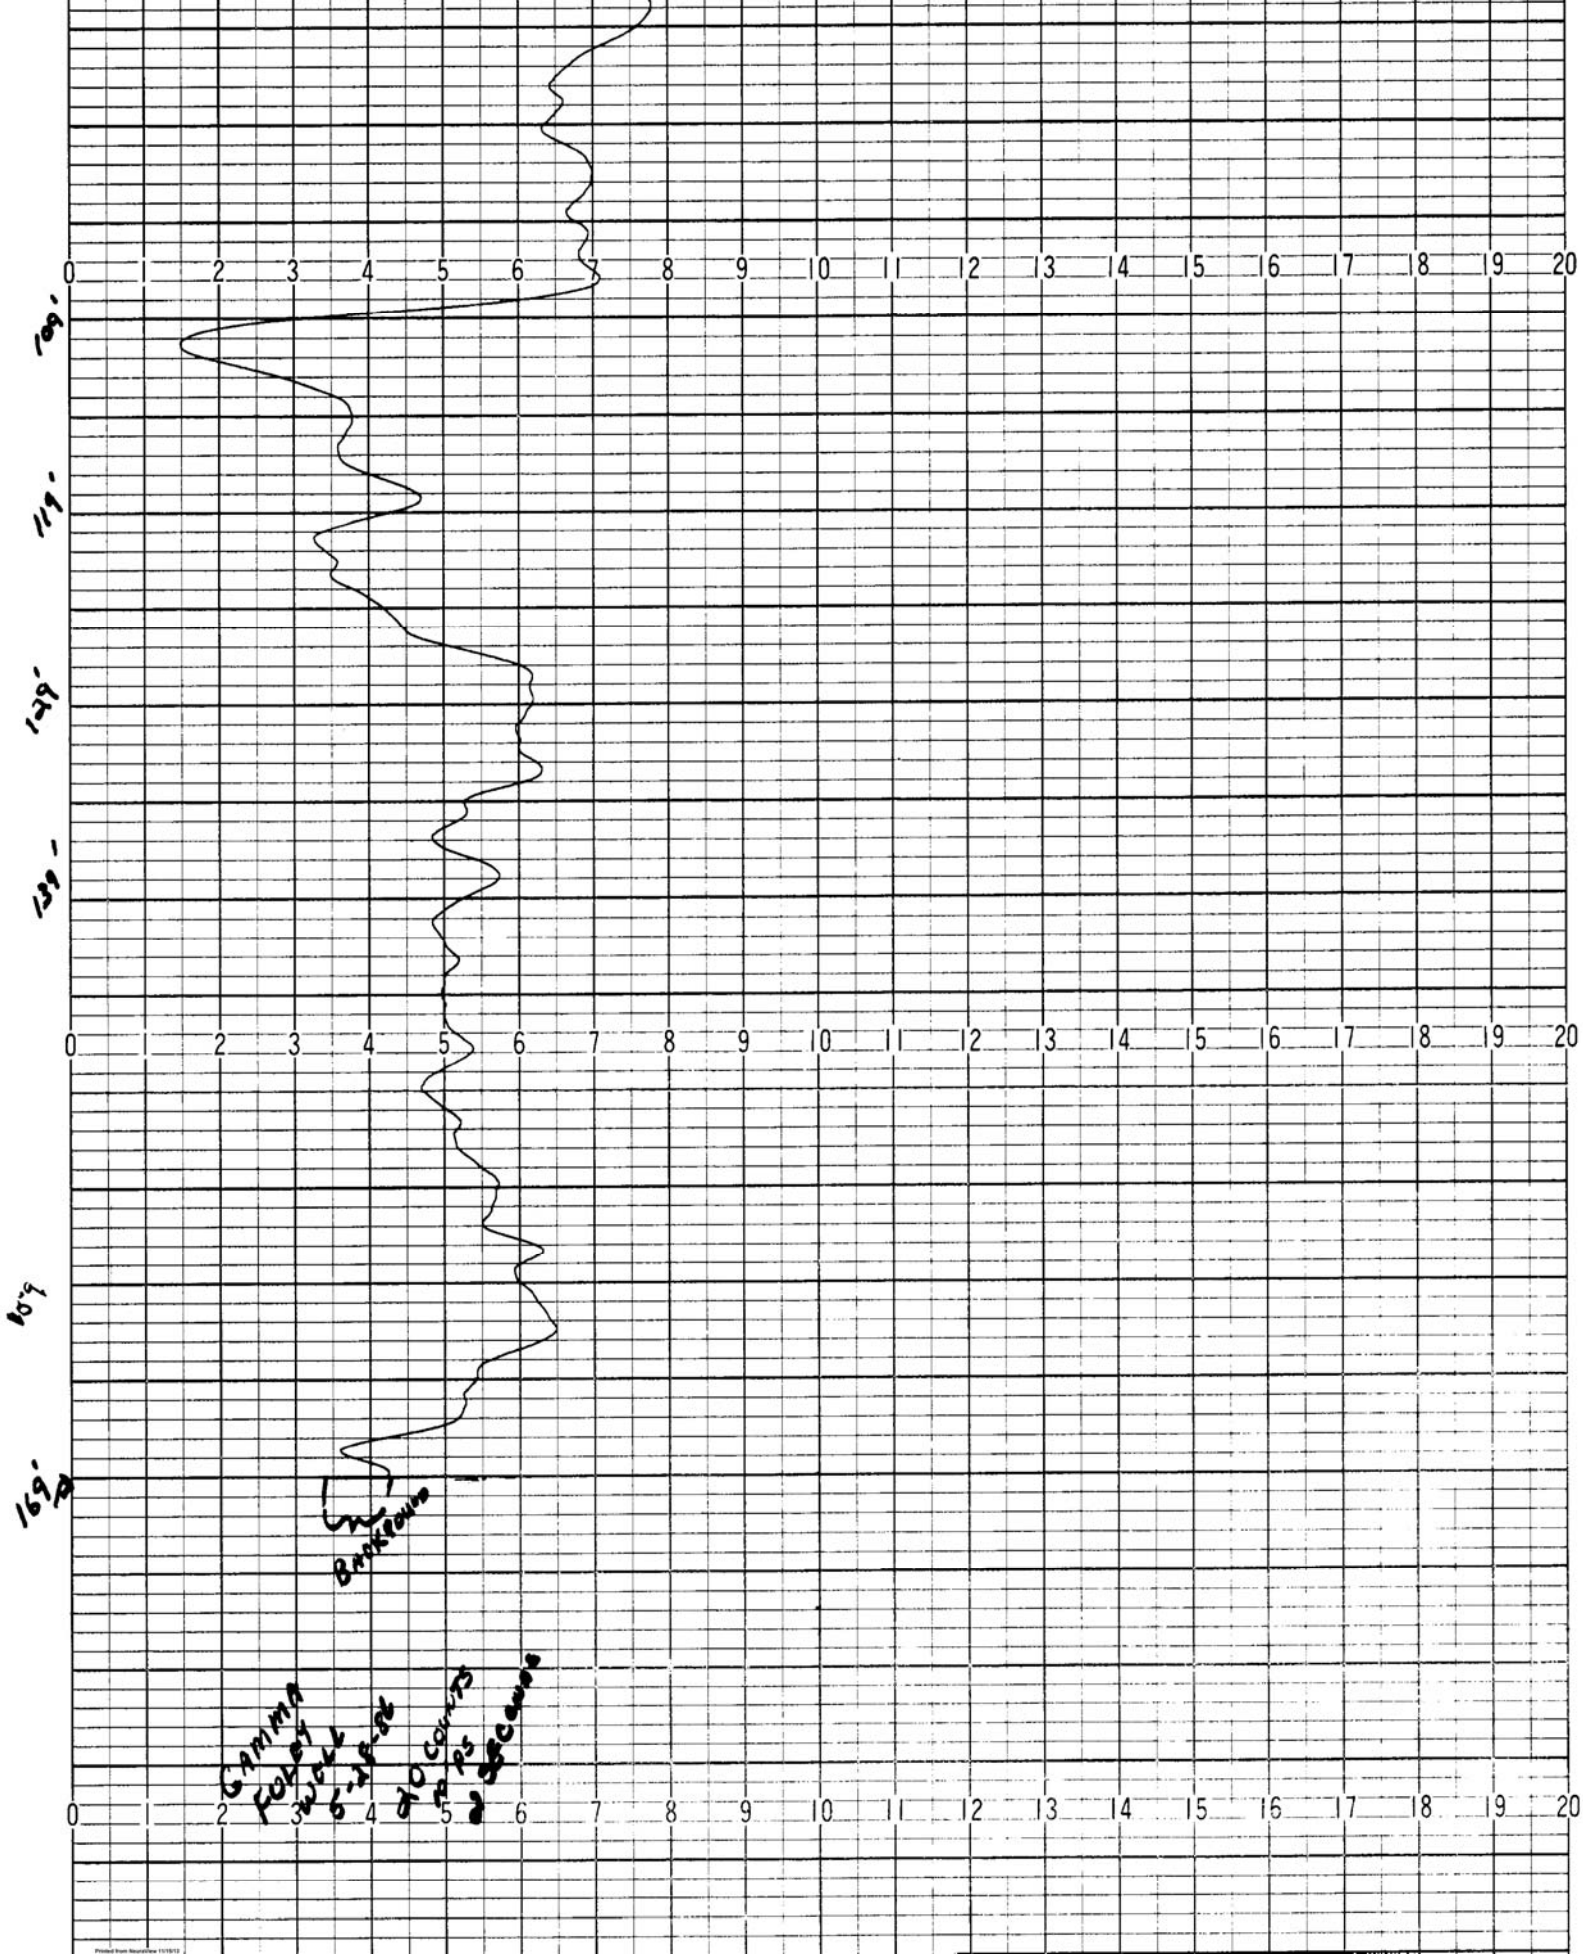

GAMMA  

BACKGROUN

# KU Fish Ponds Hole

logging down ↓

"North Hole"

Fish Ponds Hole  
5" casing with PVC

Top of Tool (Spring) at hand surface  
4.9'

Resistance

5.0'

5m52.1

2020

10'

20'

50'

75'

82.6'

338 S

W.T.

2490

whos

logging up ↑

17-19-2 DAC

casing inside

4-25-84

M. Haber

T. M. Chown

M. Sophocles

Resistance

5.0'



50'






75'


W.T.

200 Ω



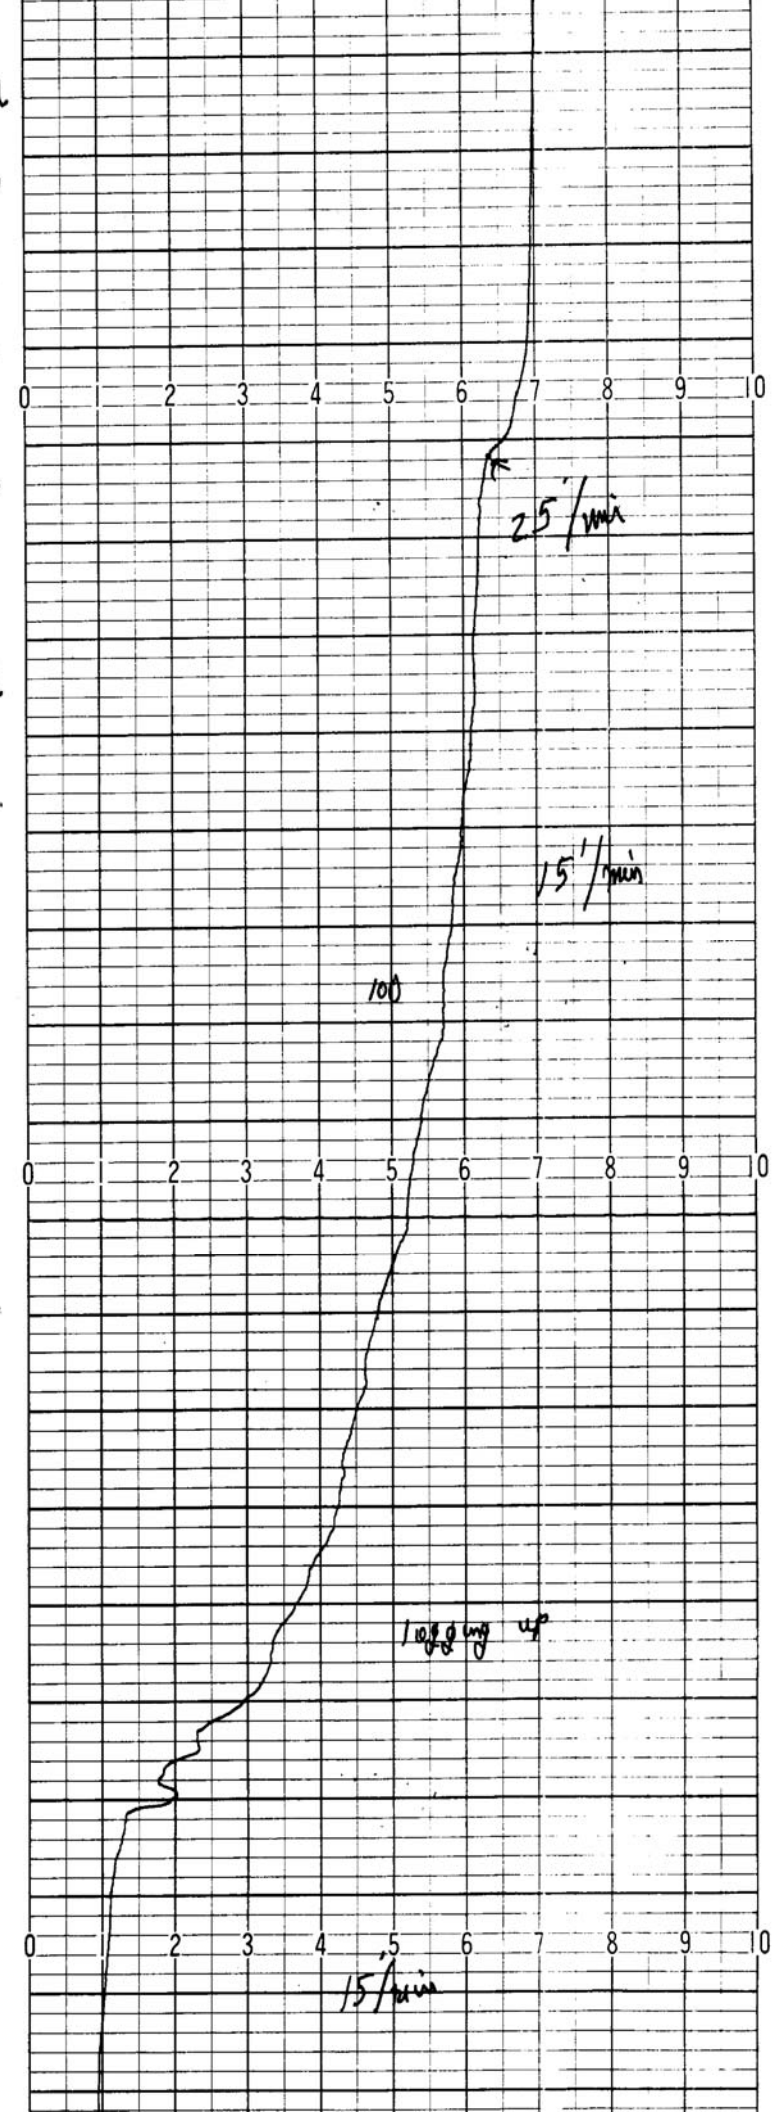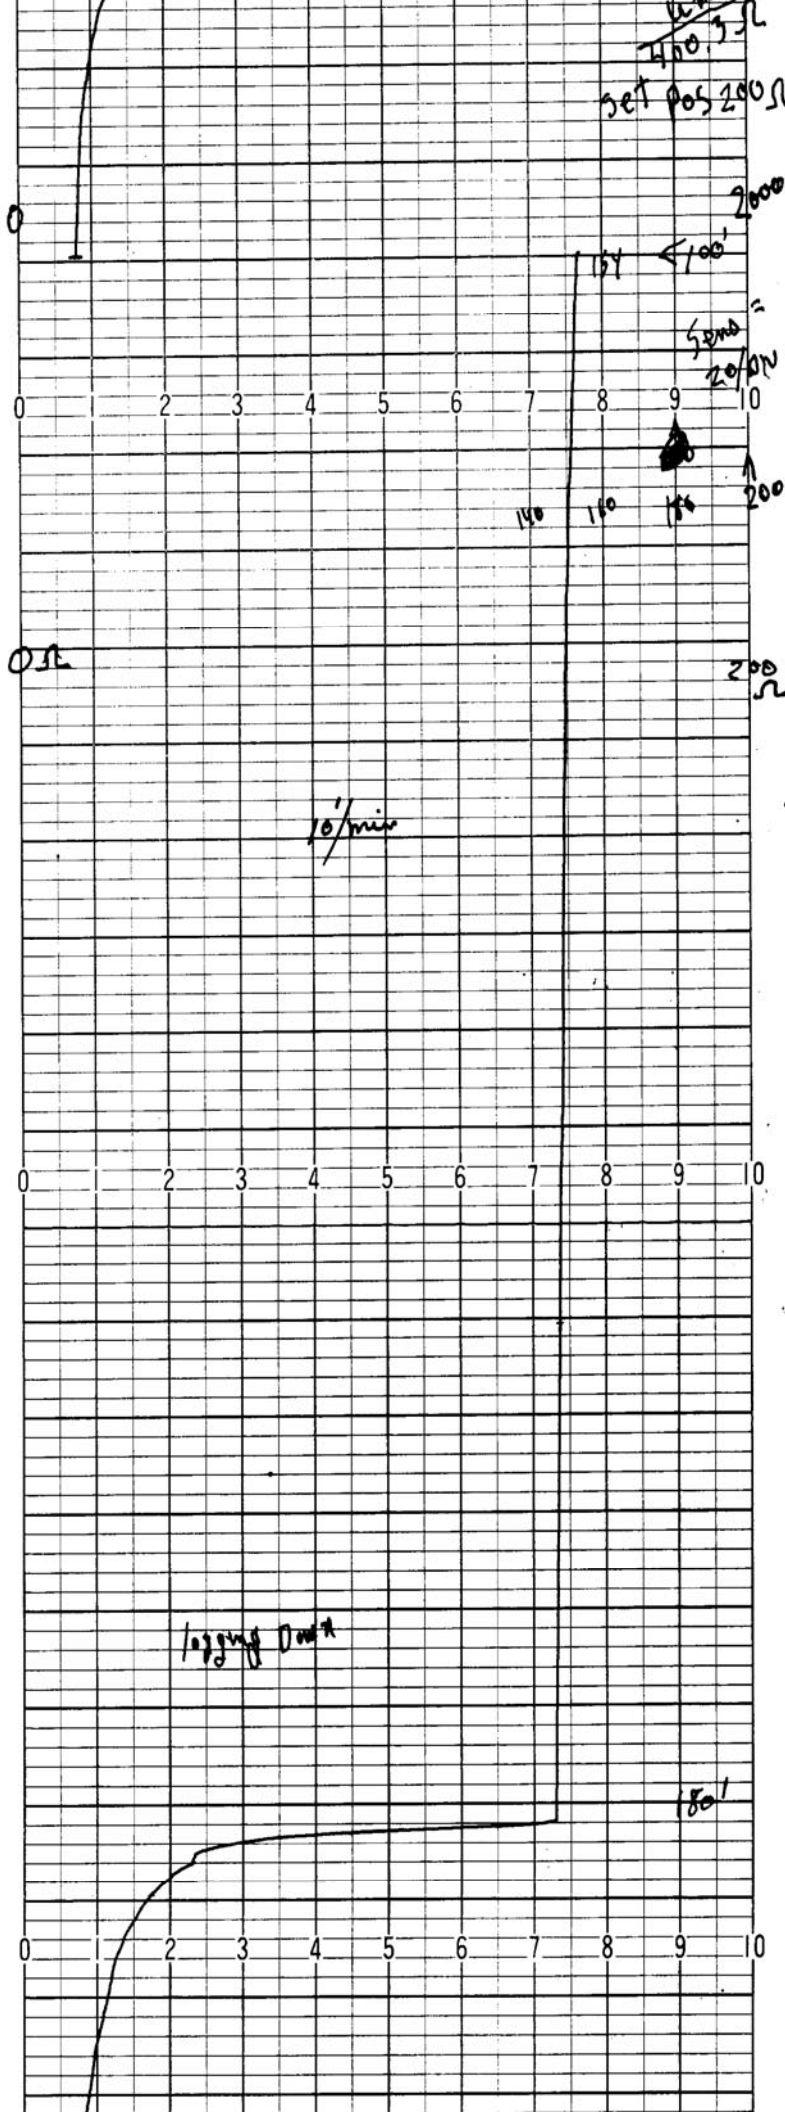


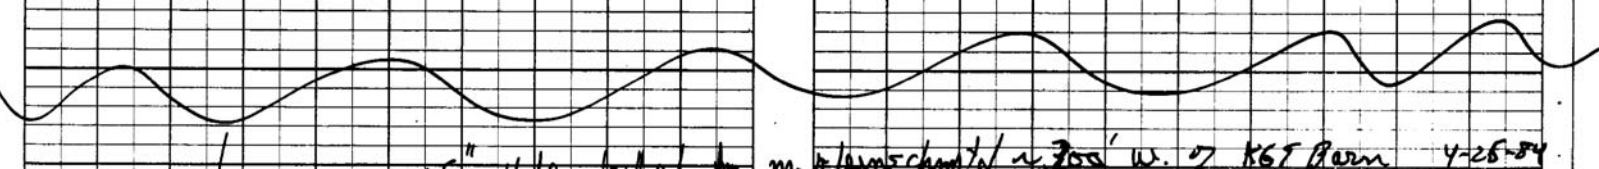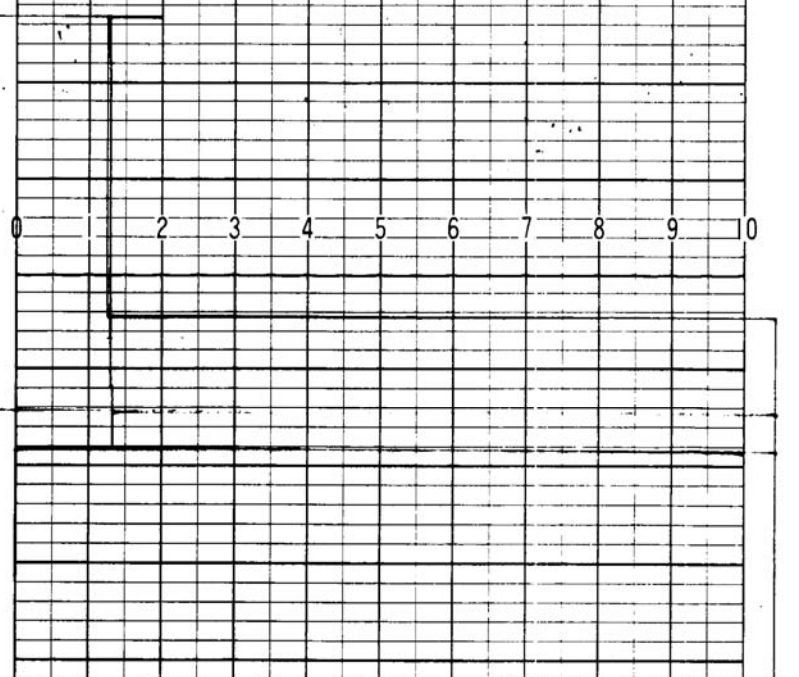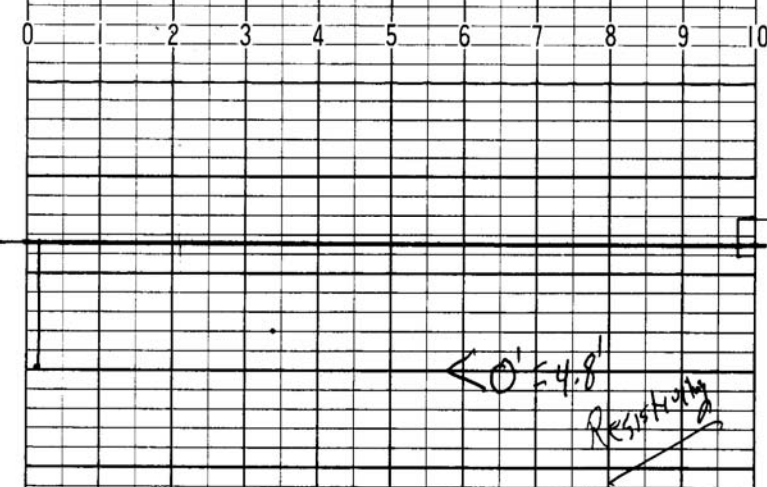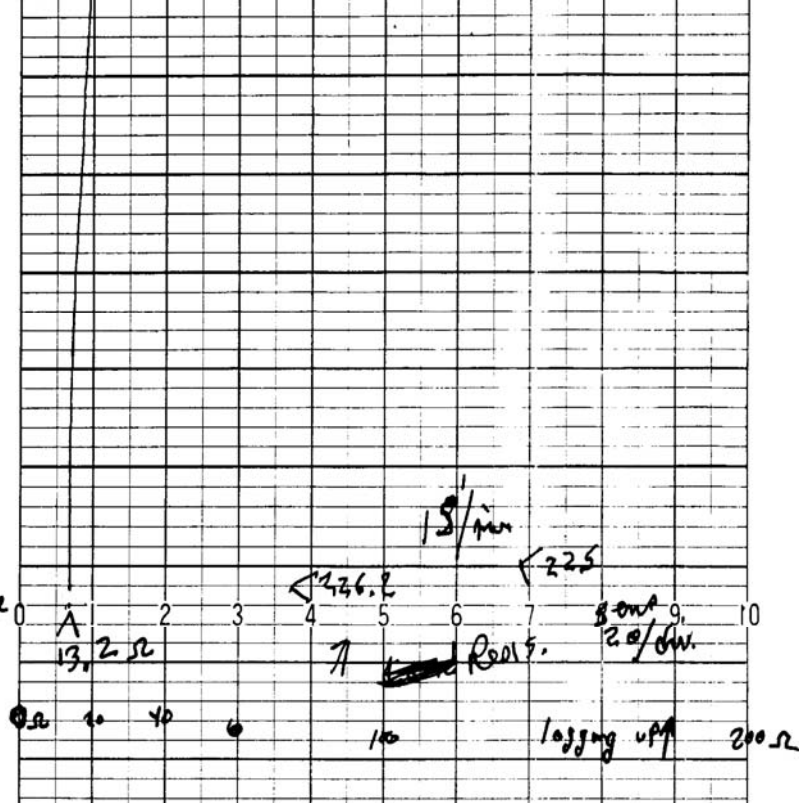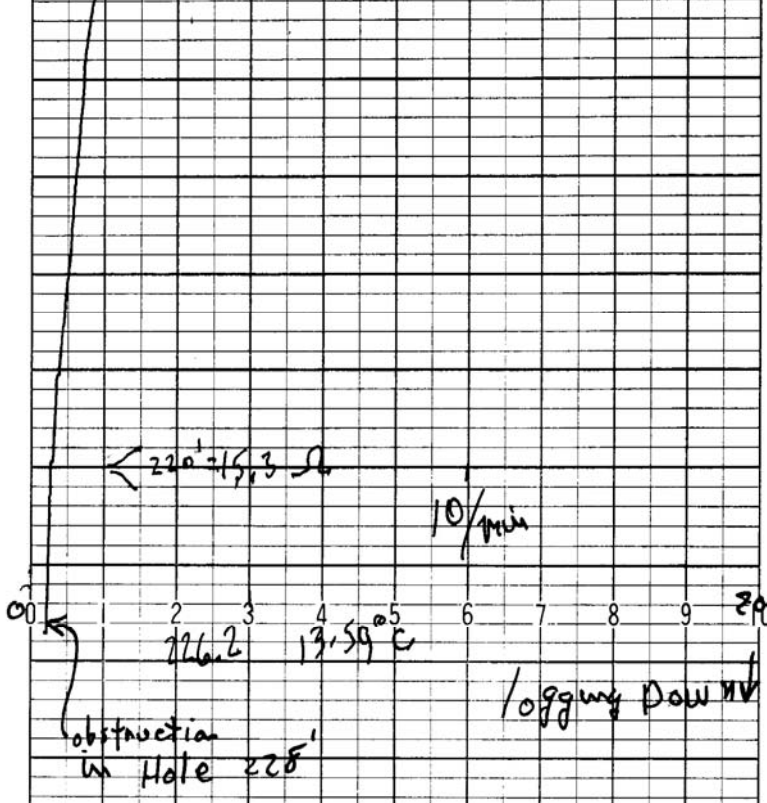

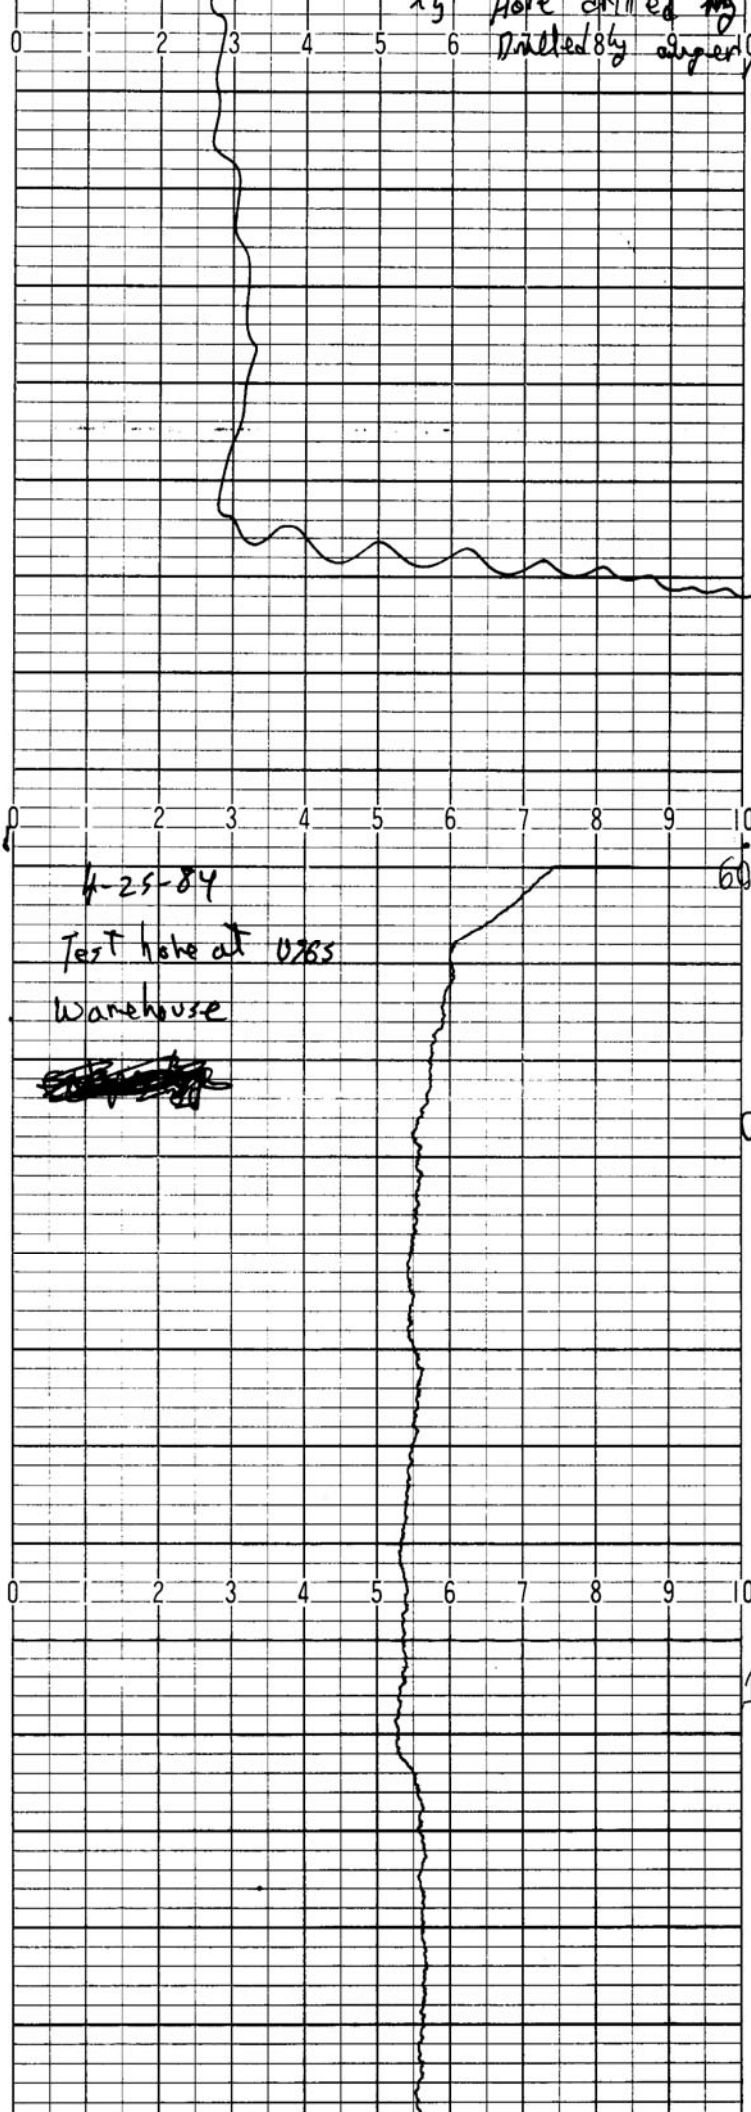

Hole drilled by ~~my~~ ~~method~~ ~~system~~ in 55' deep

4-25-84  
 Warehouse  
~~Warehouse~~

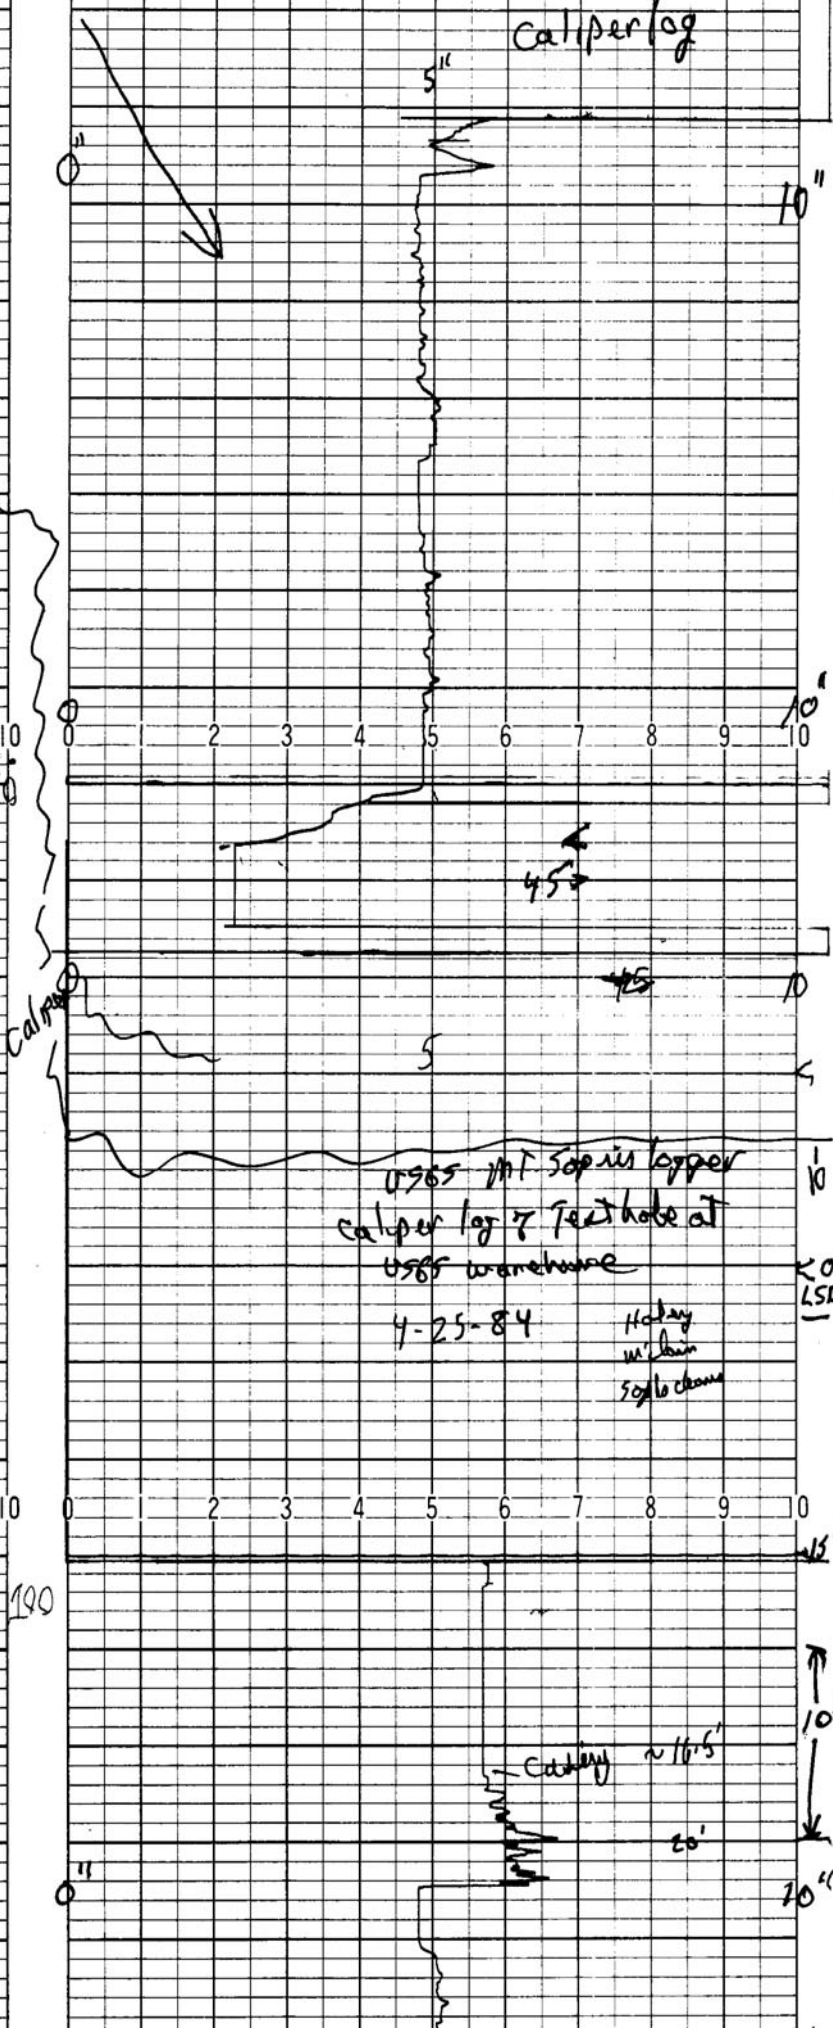

Caliper log


4-25-84  
 Hobart  
 within  
 50' to change

Caliper ~ 16.5'  
 20'

Caliper

100

10"

10"

10"










20'  
 LSD





15'

10'


20"



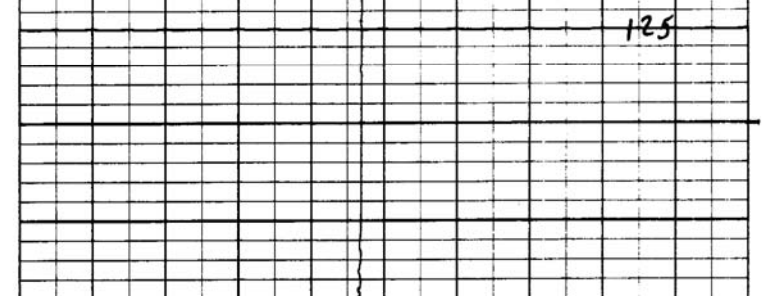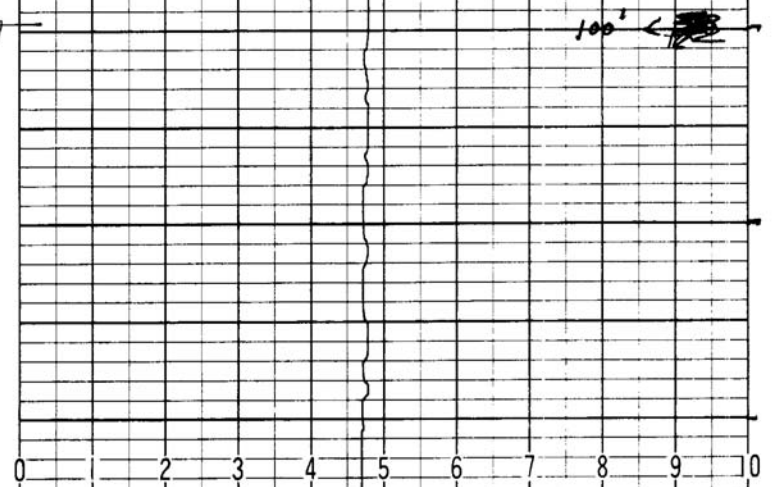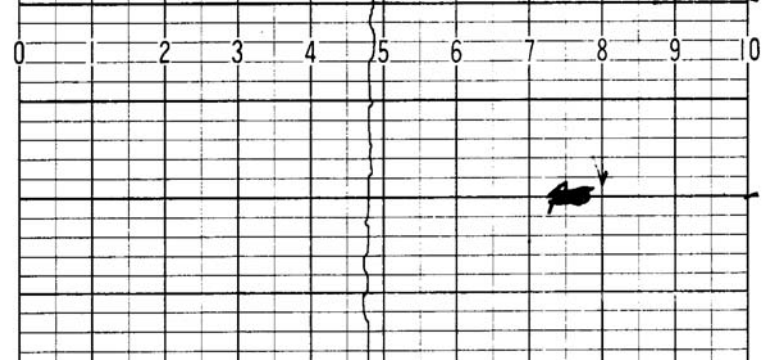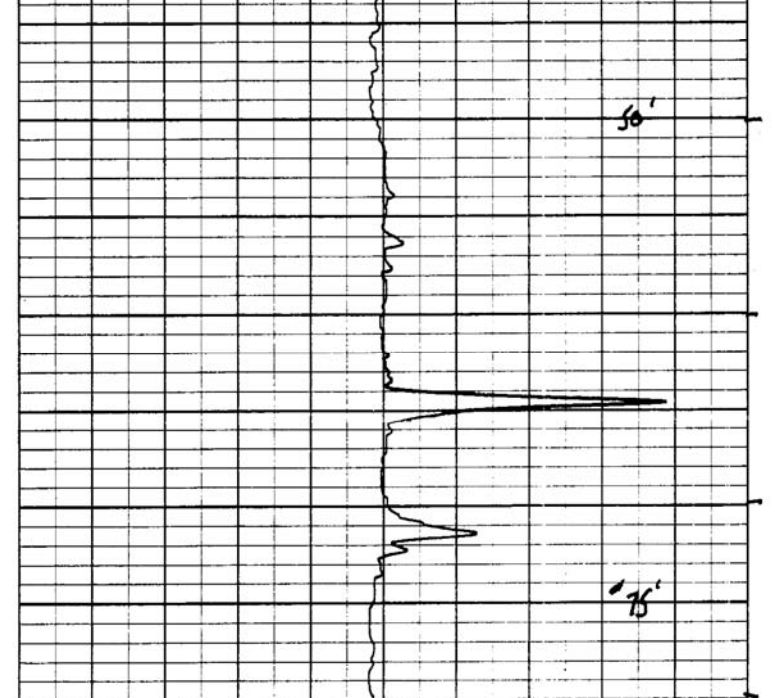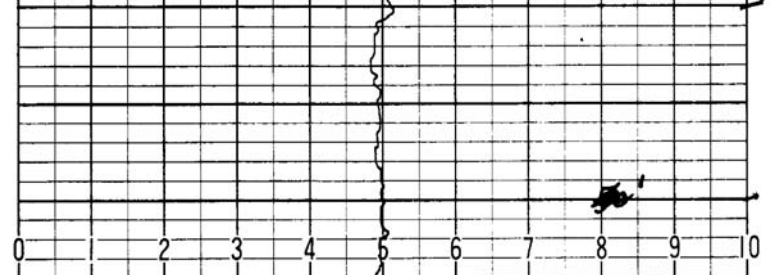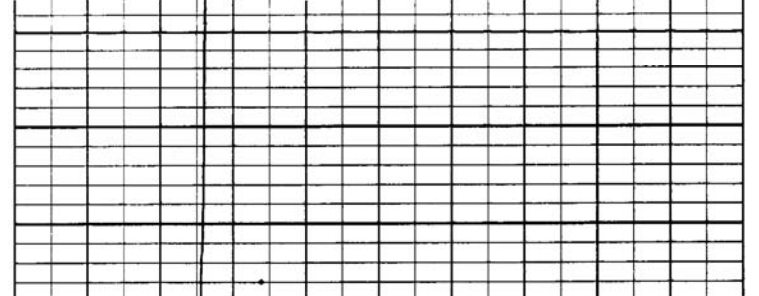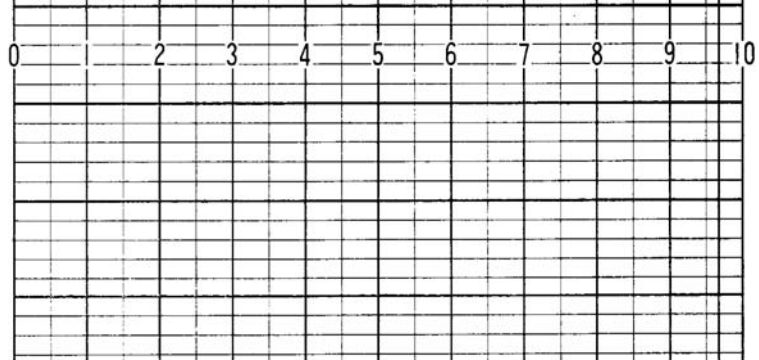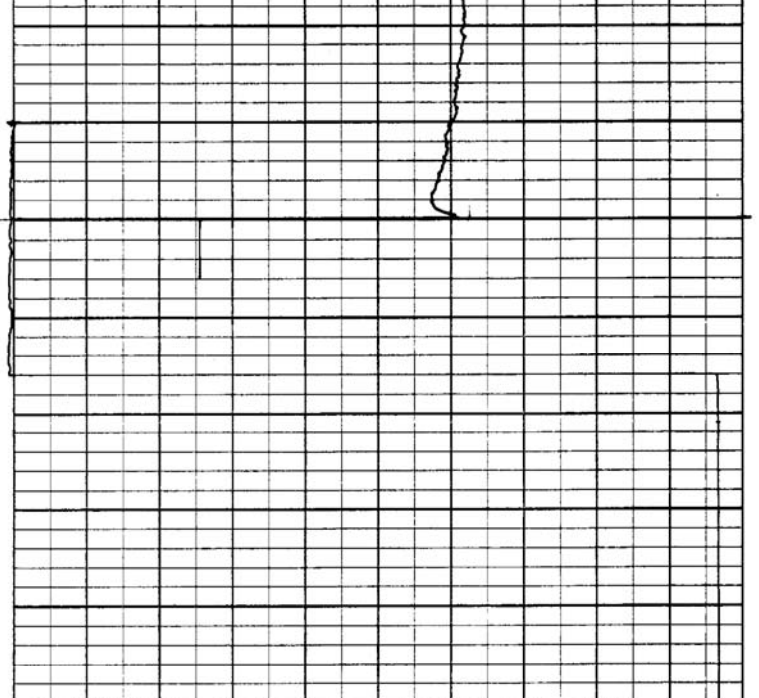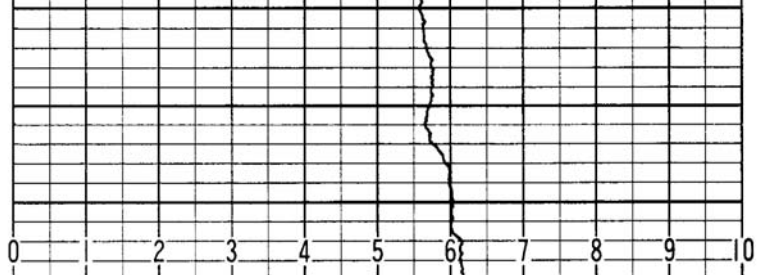


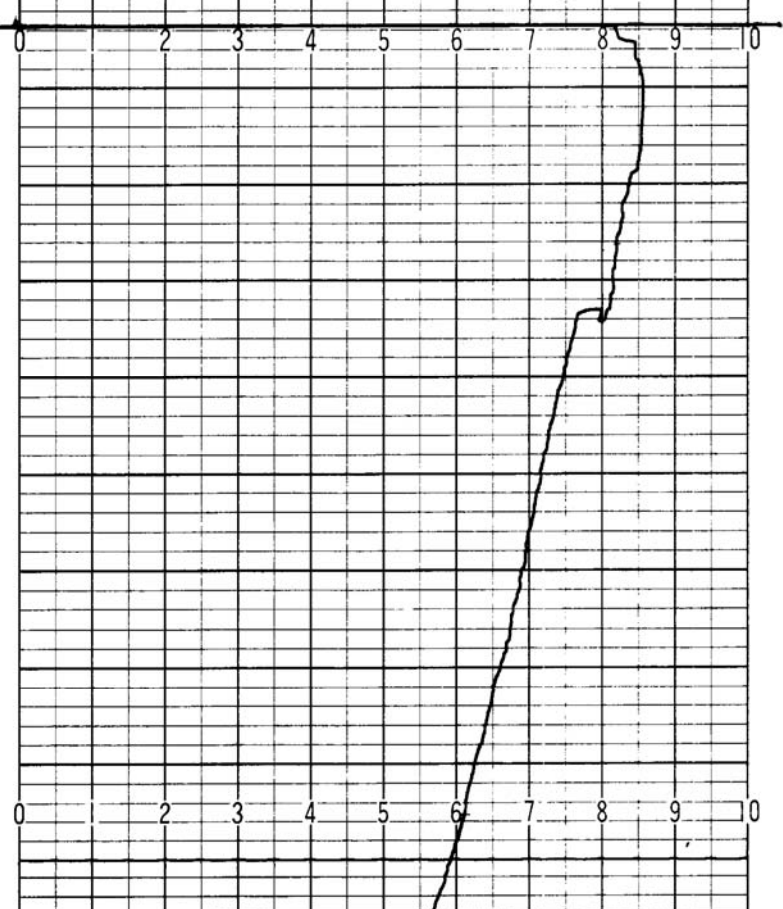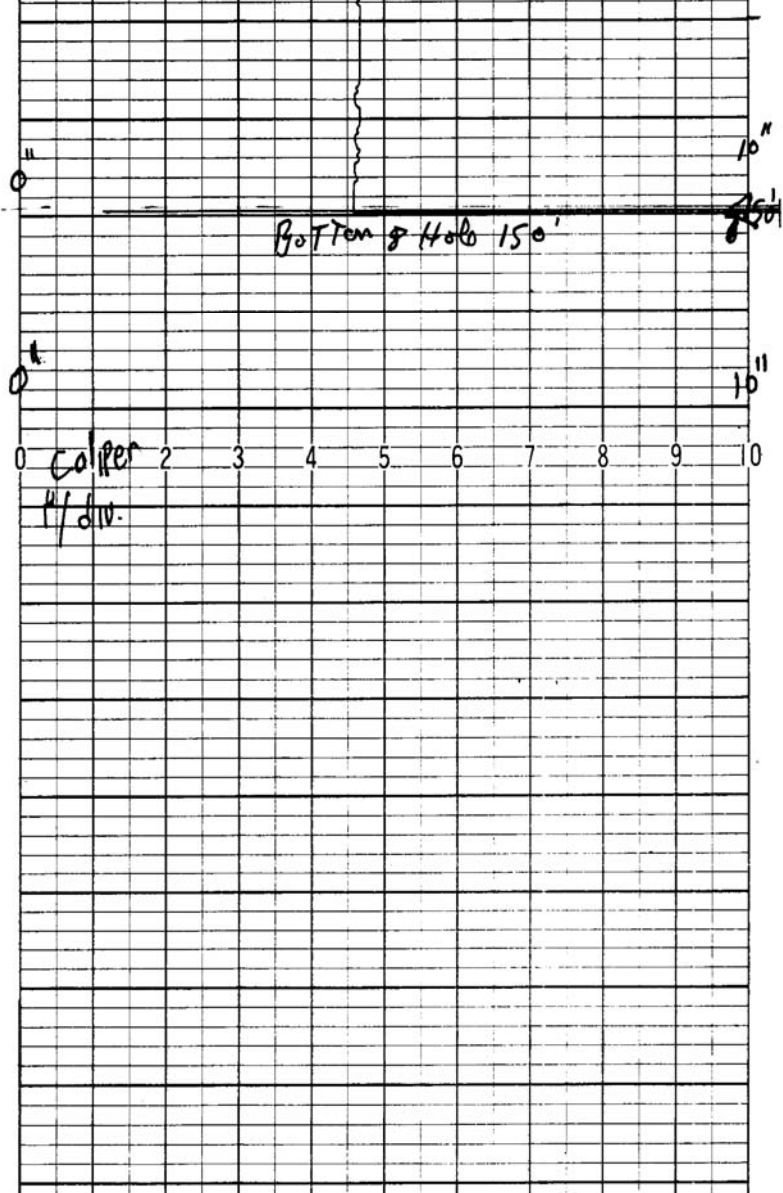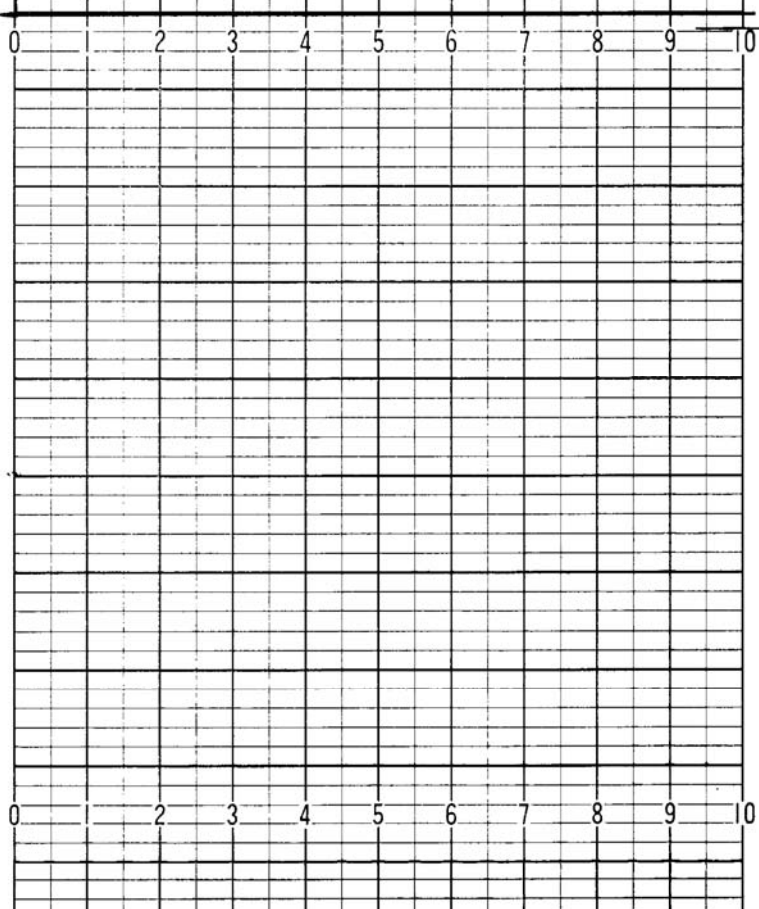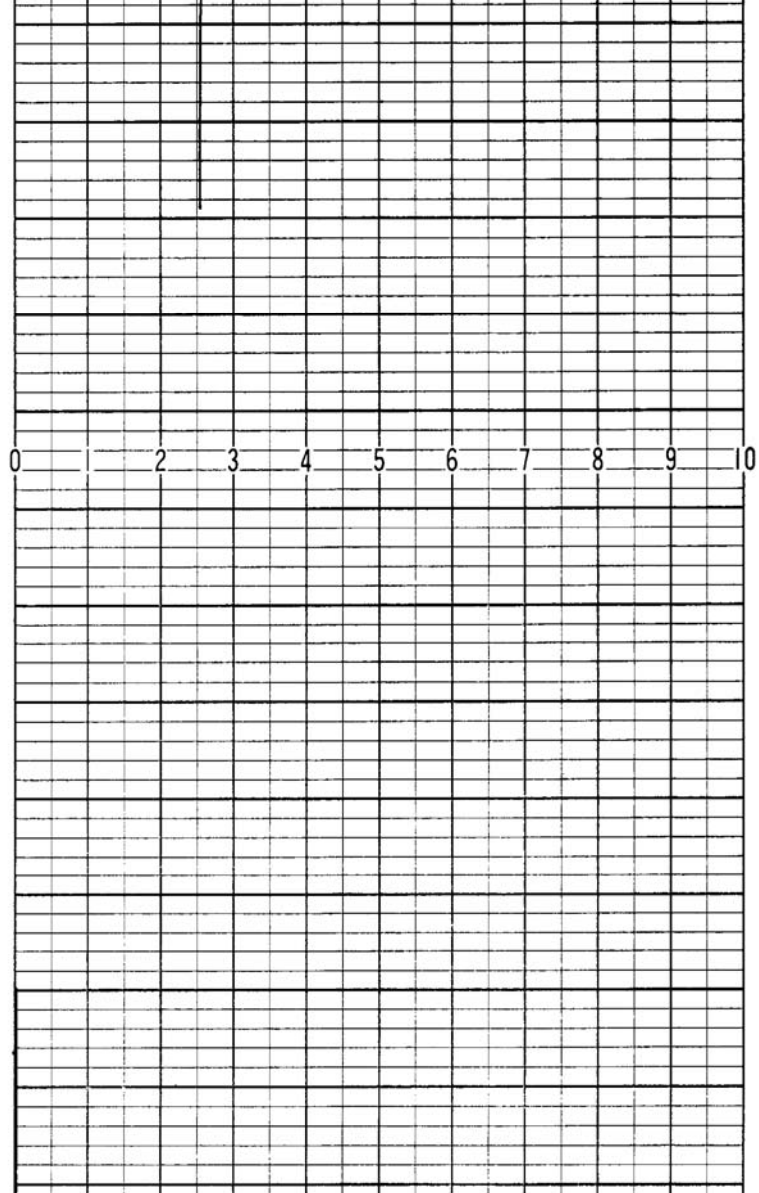

Caliper  
1/ div.

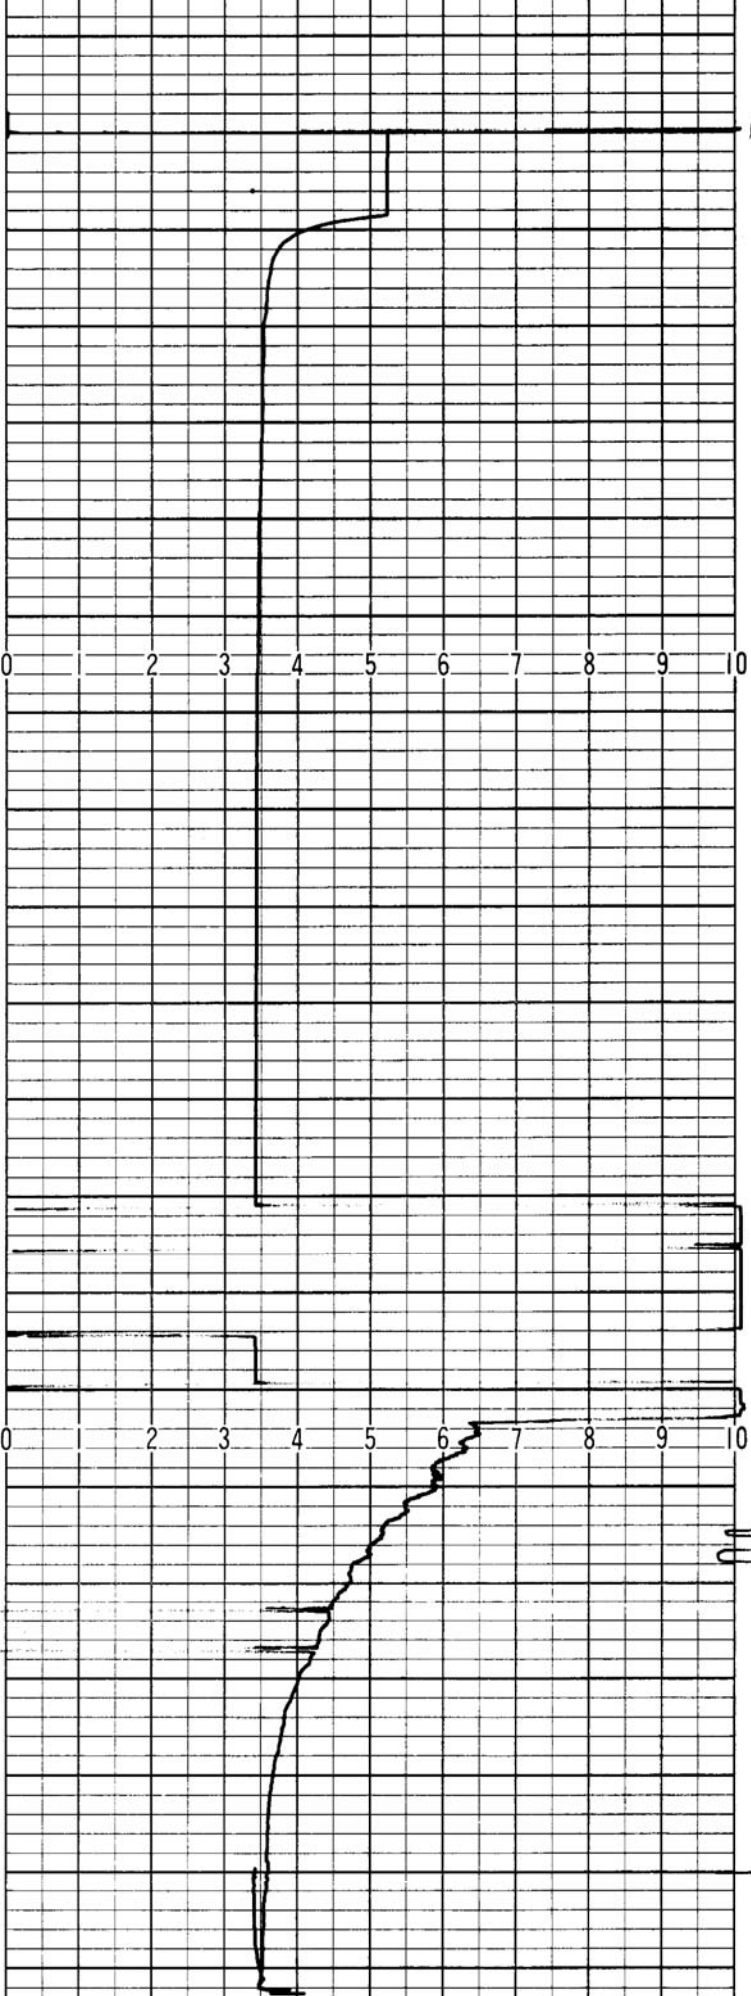

60

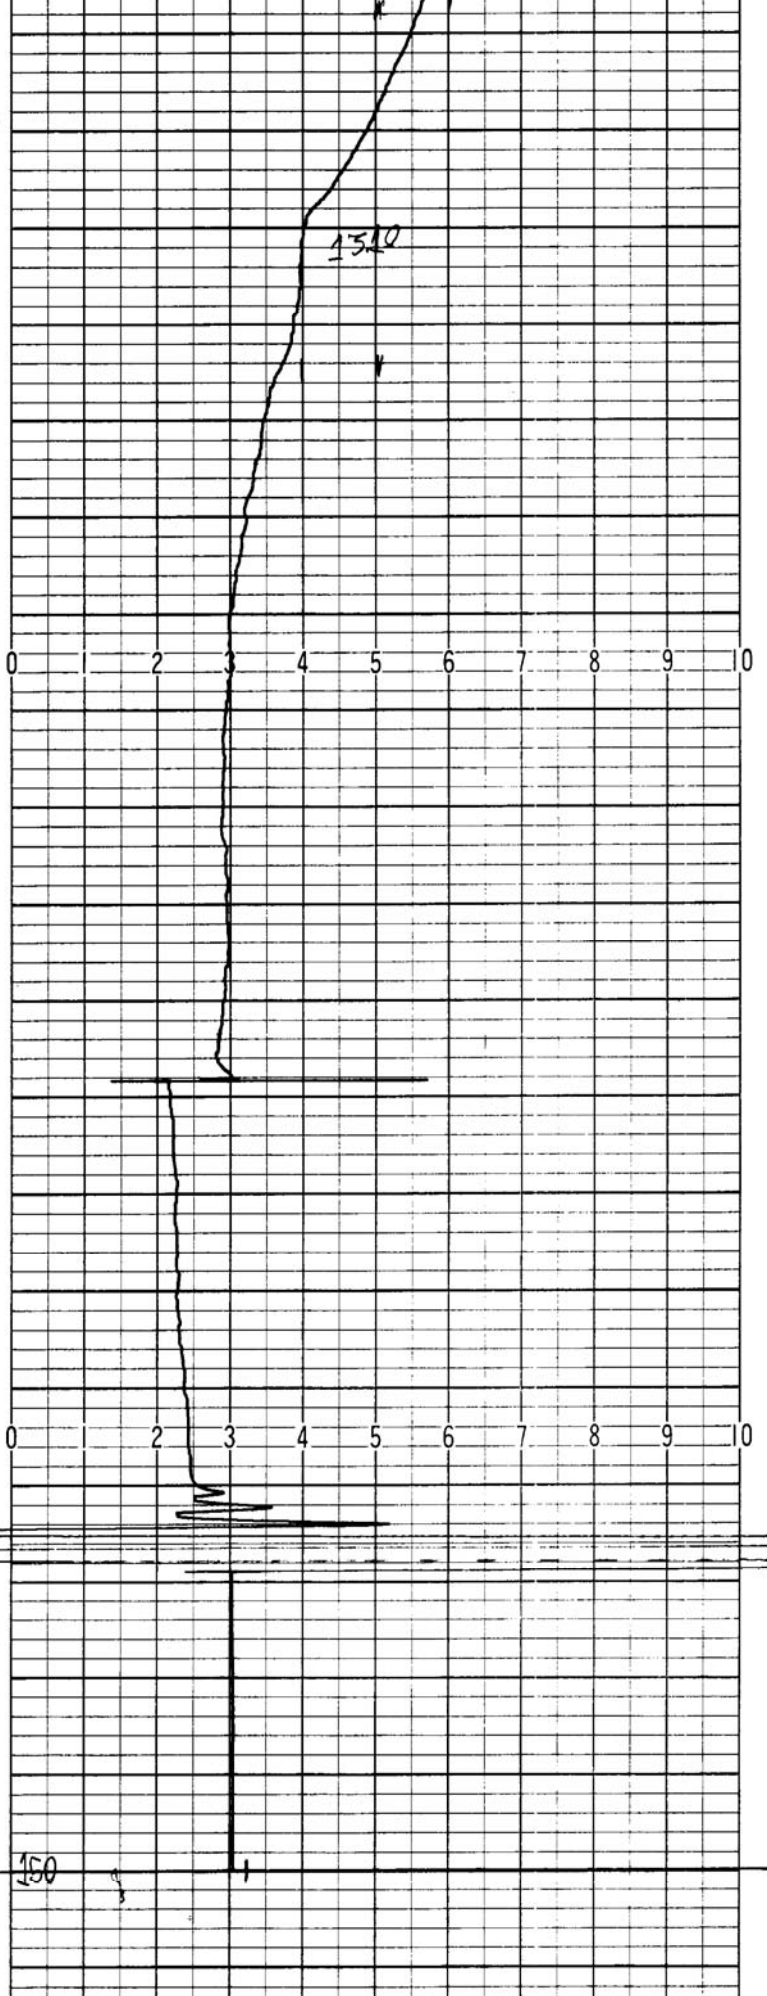

1510

150



0 2 3 4 5 6 7 8 9 10

0 2 3 4 5 6 7 8 9 10

0 2 3 4 5 6 7 8 9 10

0 2 3 4 5 6 7 8 9 10

0 2 3 4 5 6 7 8 9 10



0 2 3 4 5 6 7 8 9 10

calypso log - 4-25-84







USSF T-126 at their warehouse




422

Run by M. Hakey

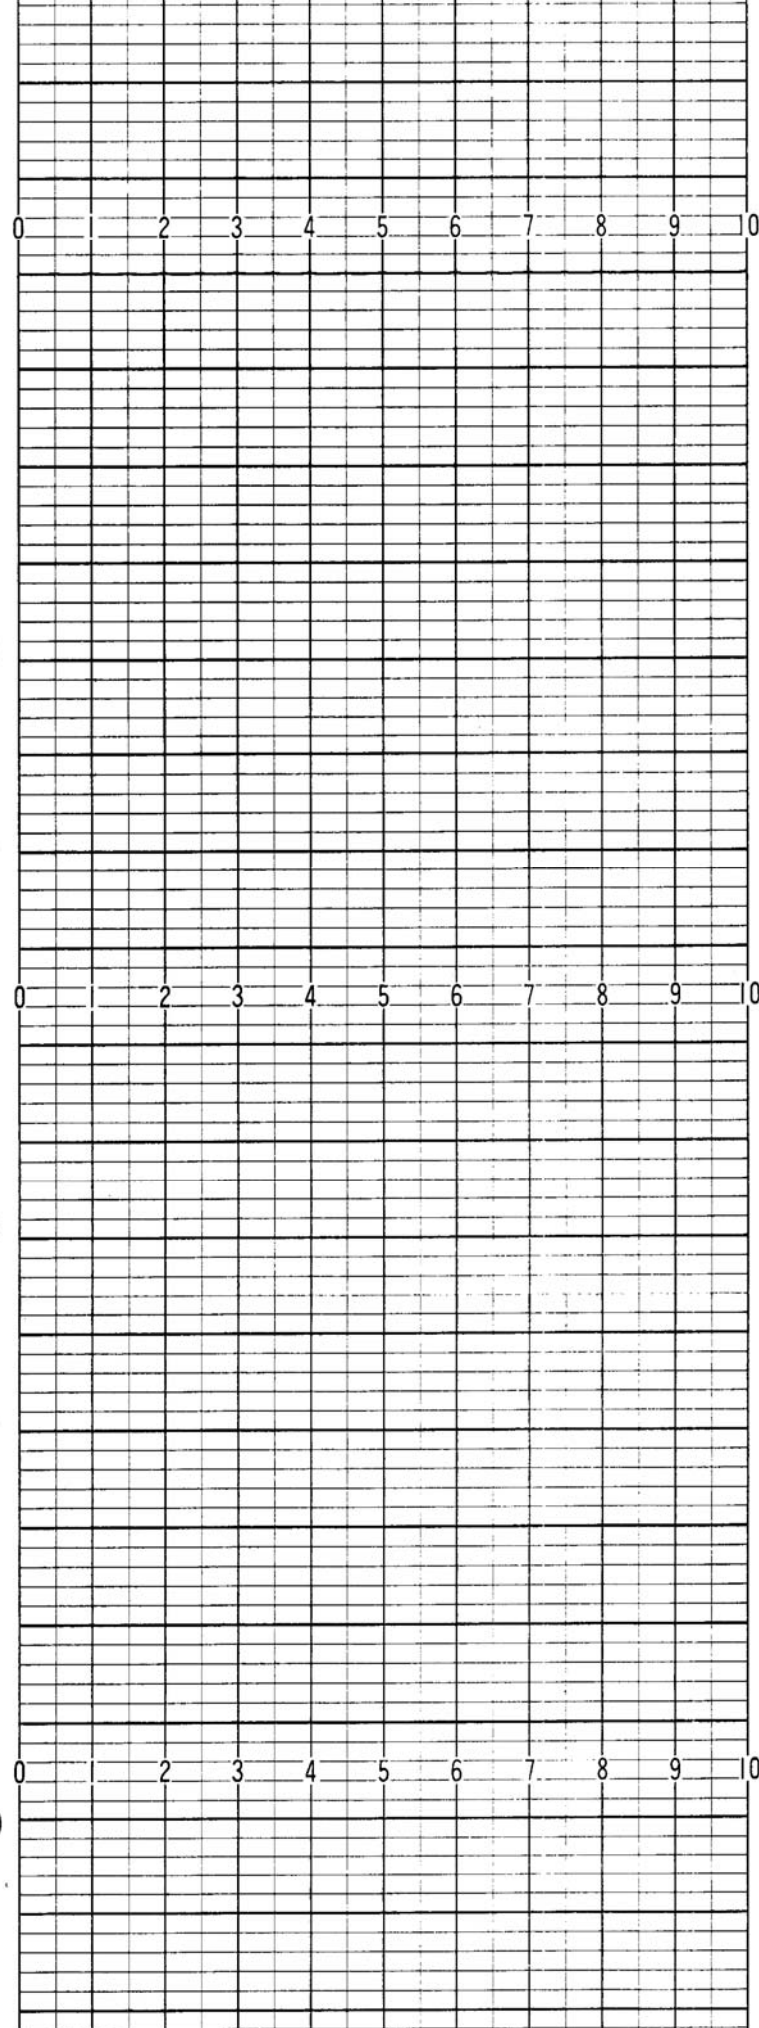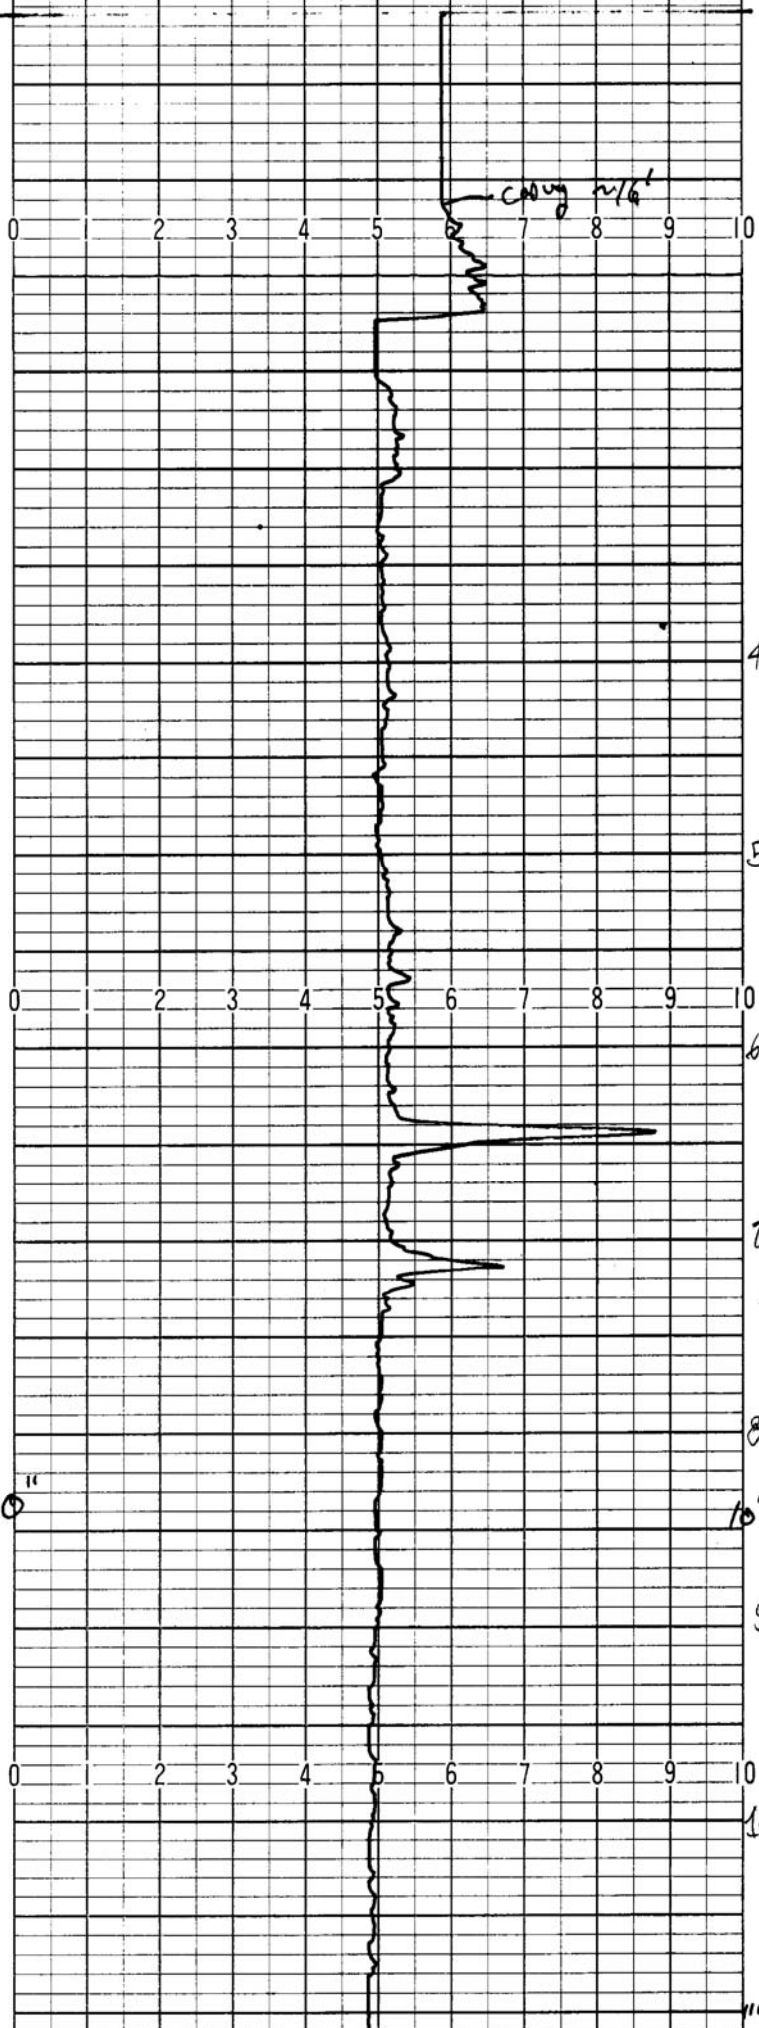




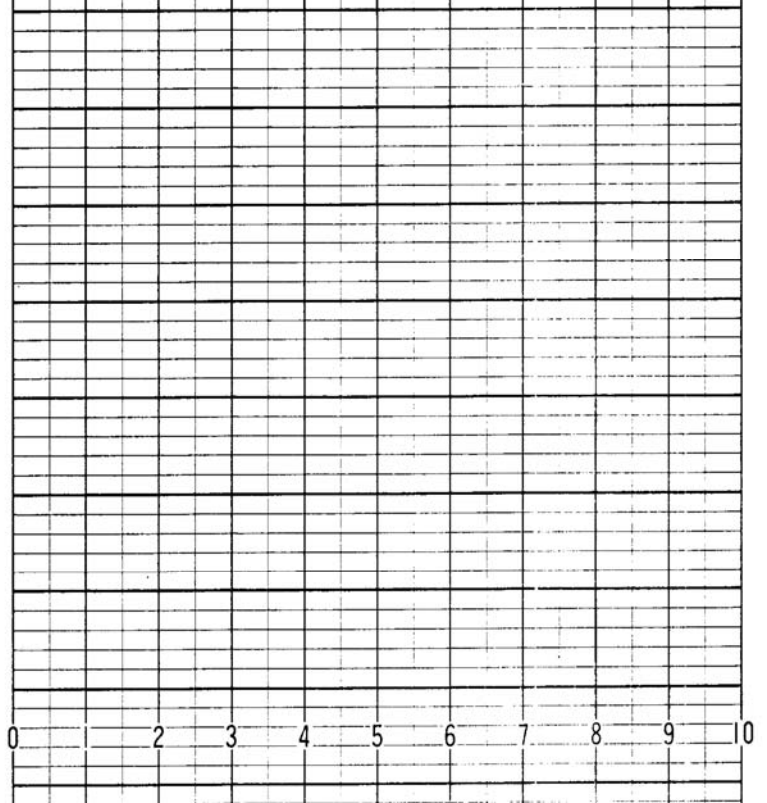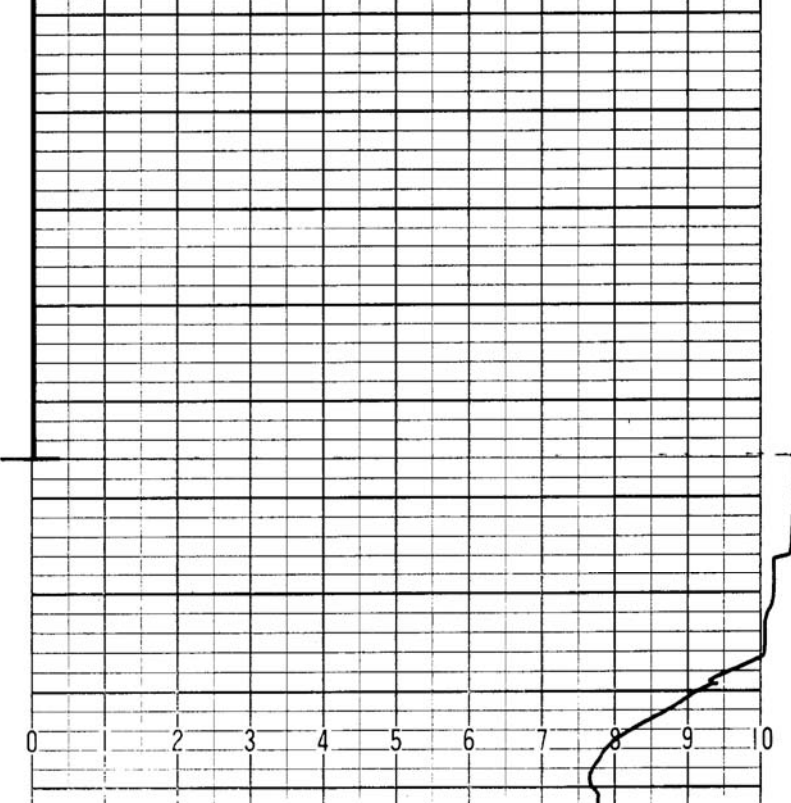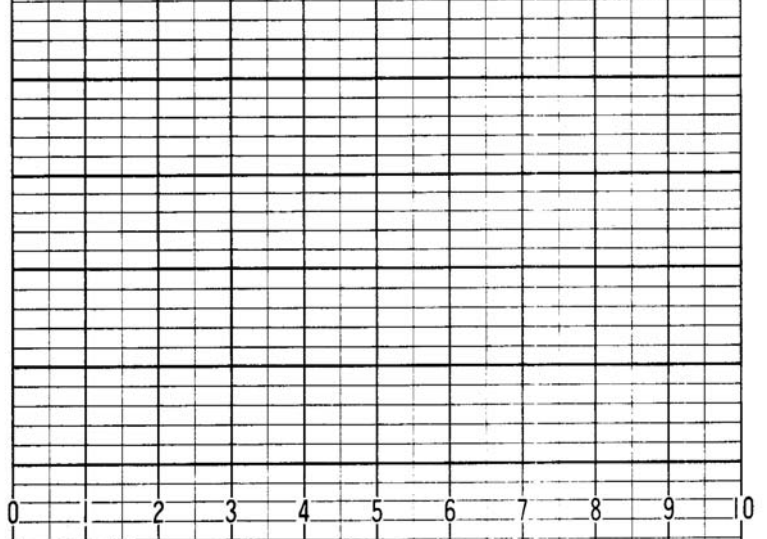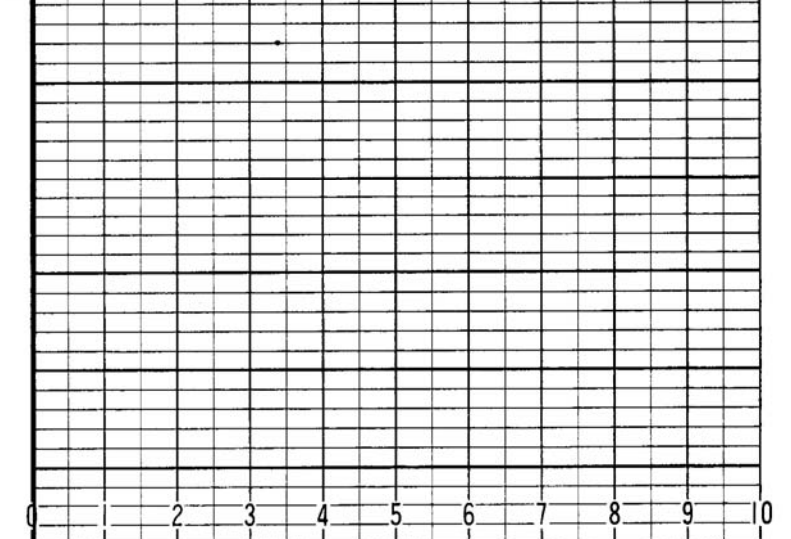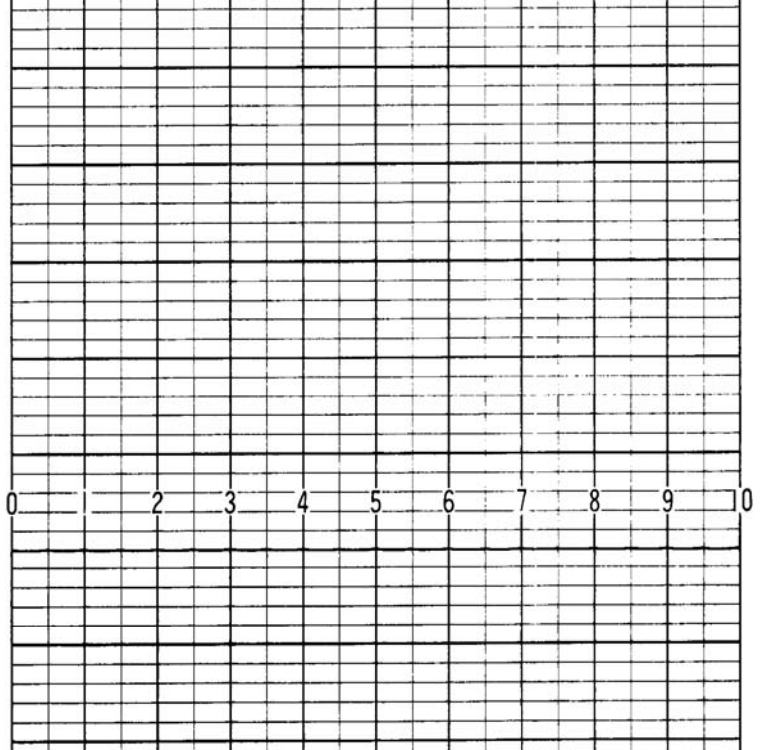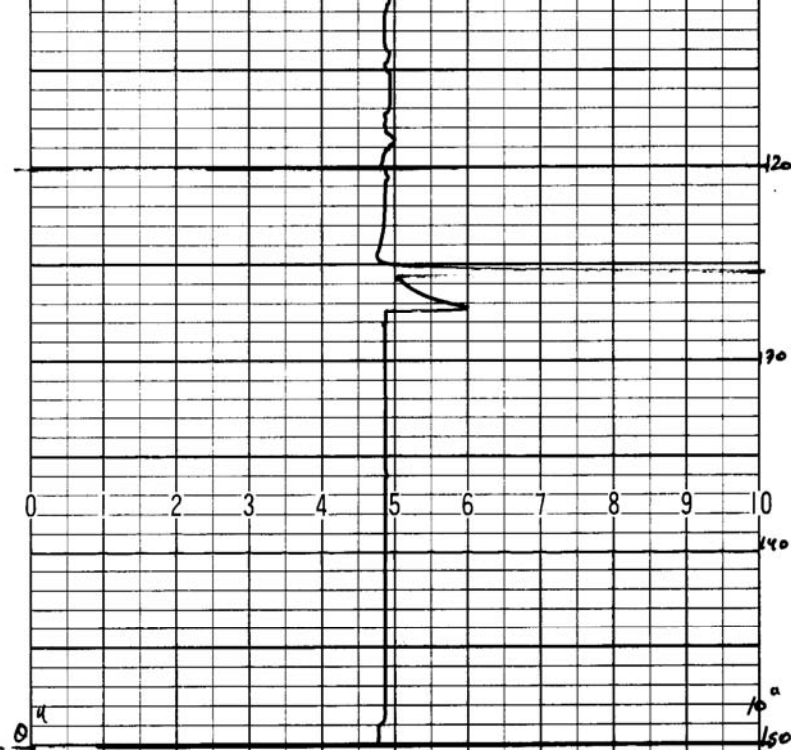

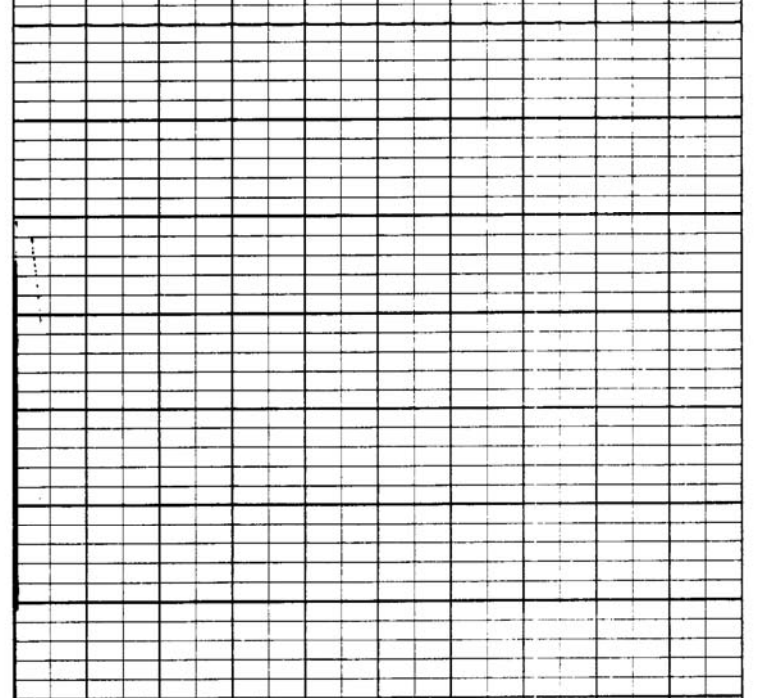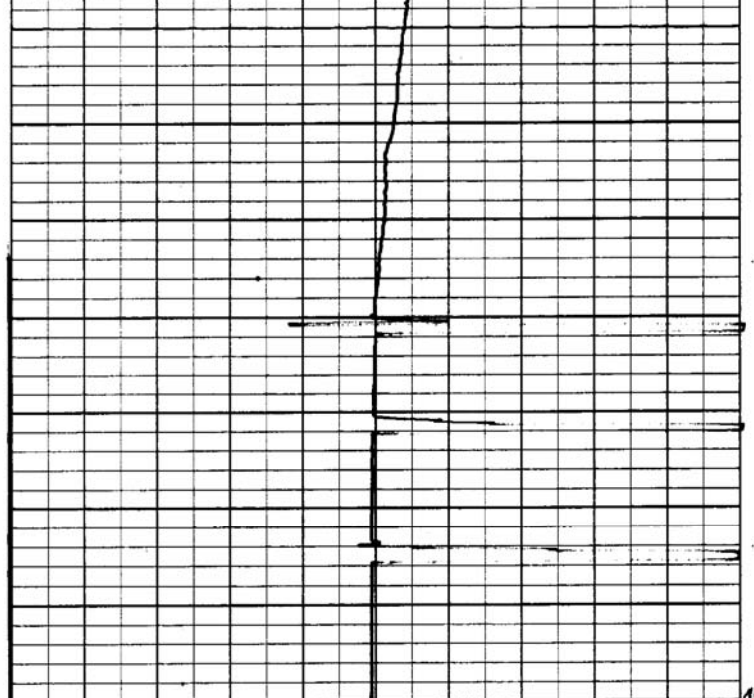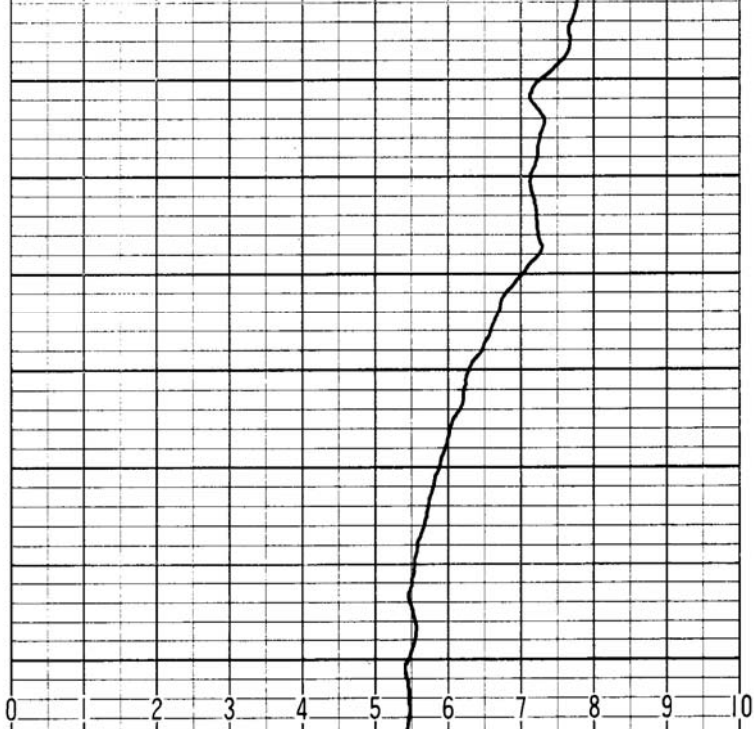




80 DIV  
DISPLACEMENT

150

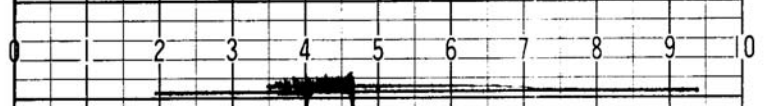

20

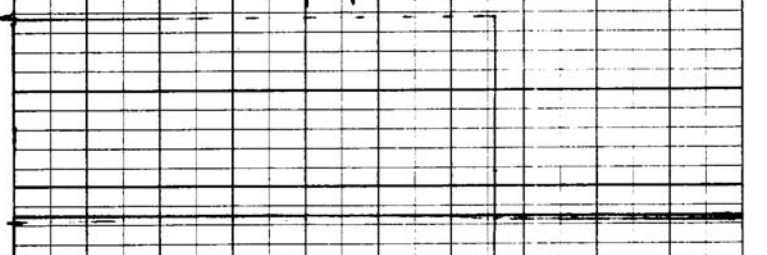

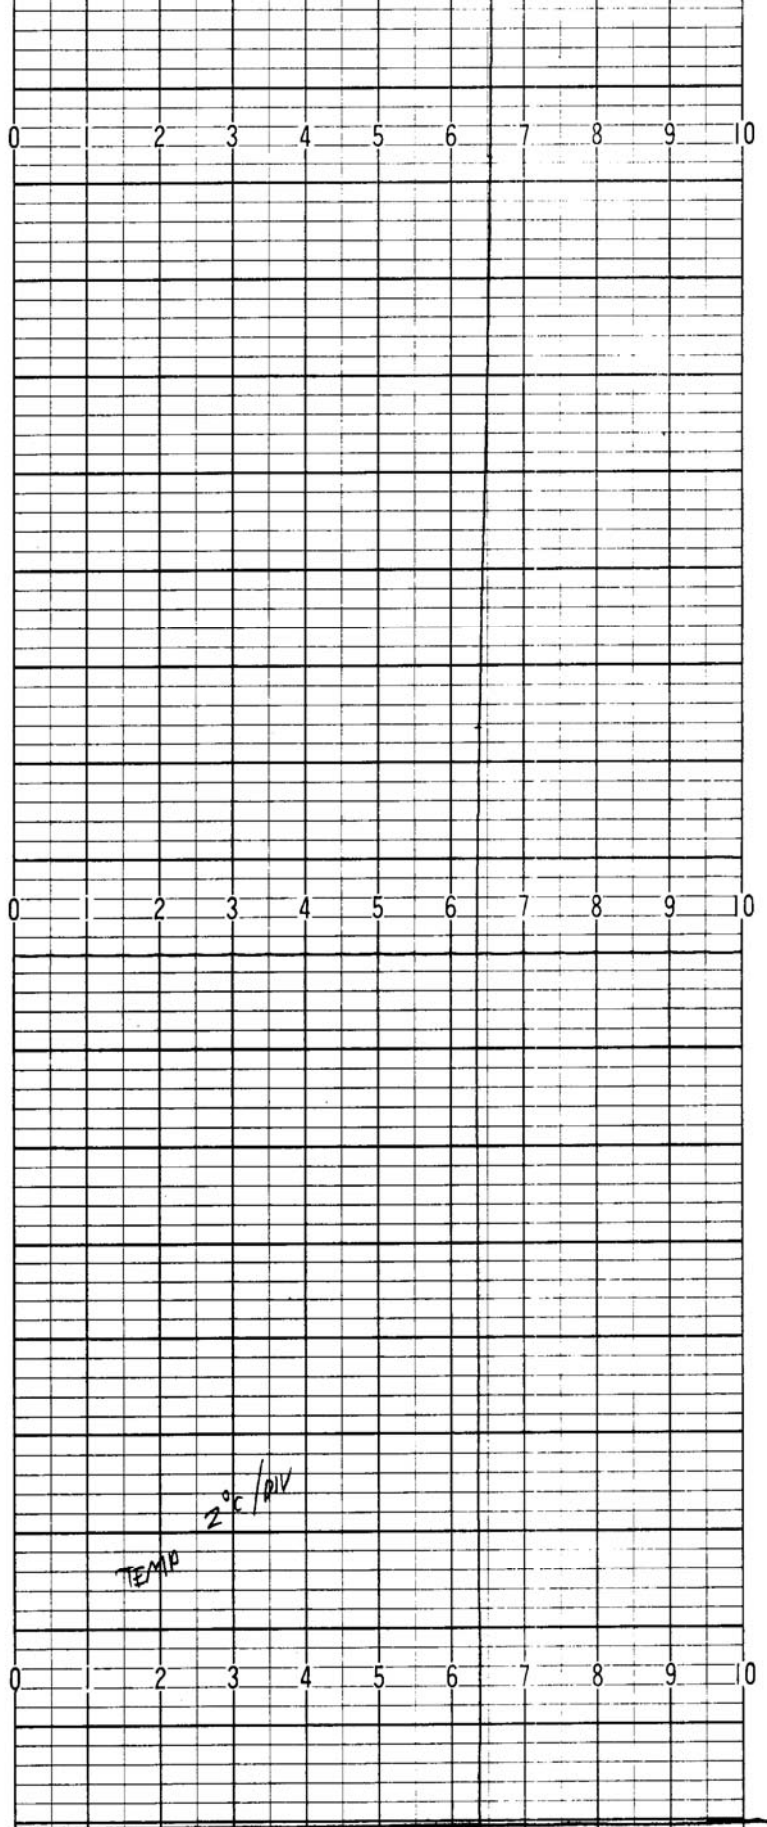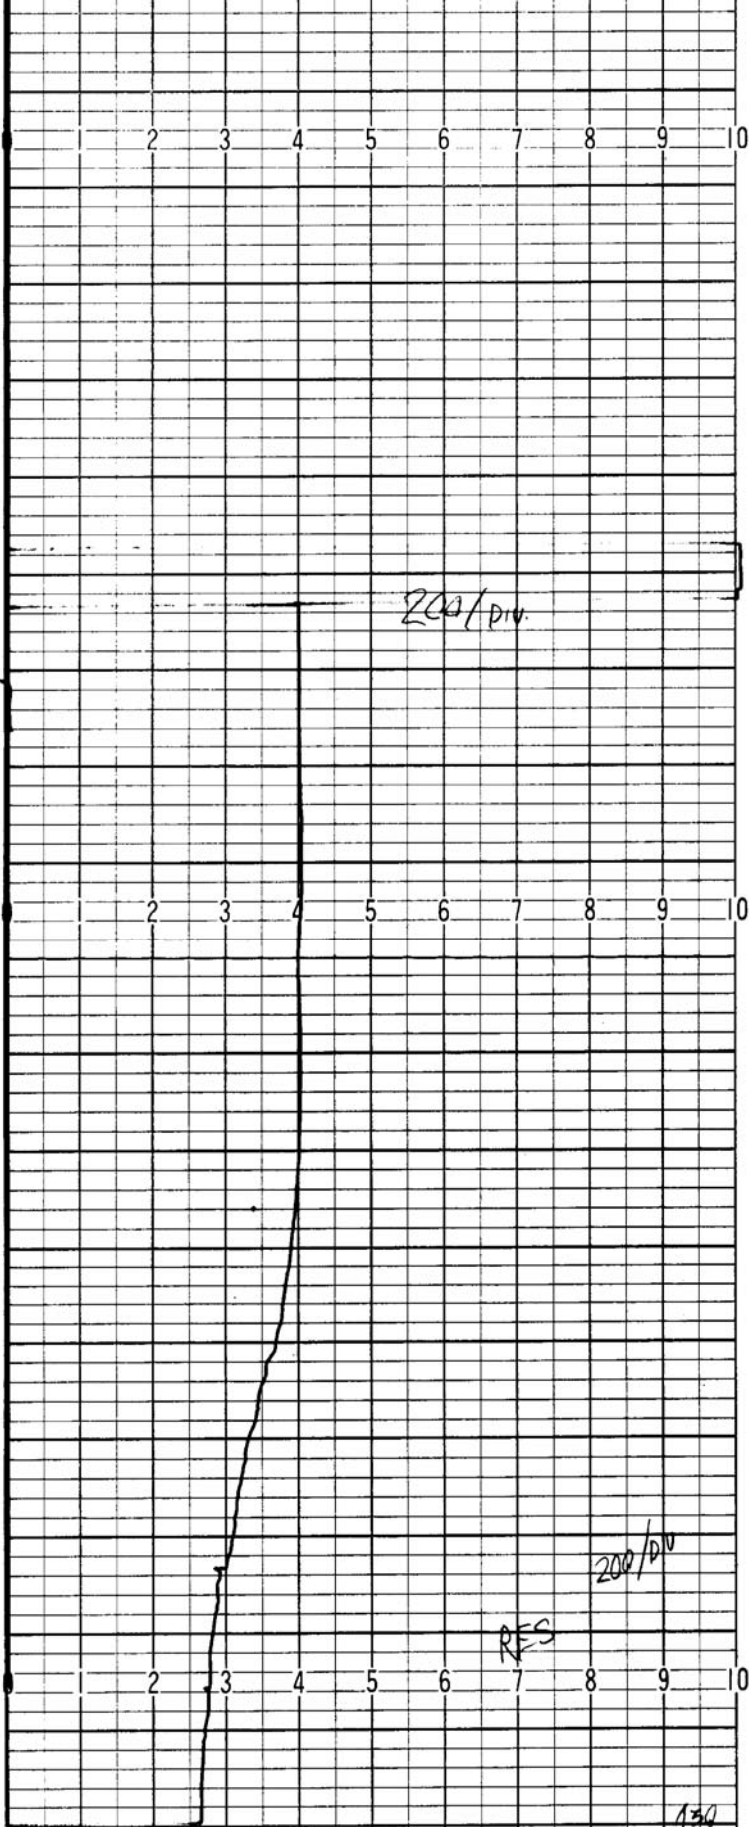

**Charts-Inc**

P.O. BOX 10

P.O. BOX 49

SUN VALLEY, CA 91352

(213) 767-0068


**CHART NO. ENG-2**



Conductivity

- Fishponds #3

2-27-86

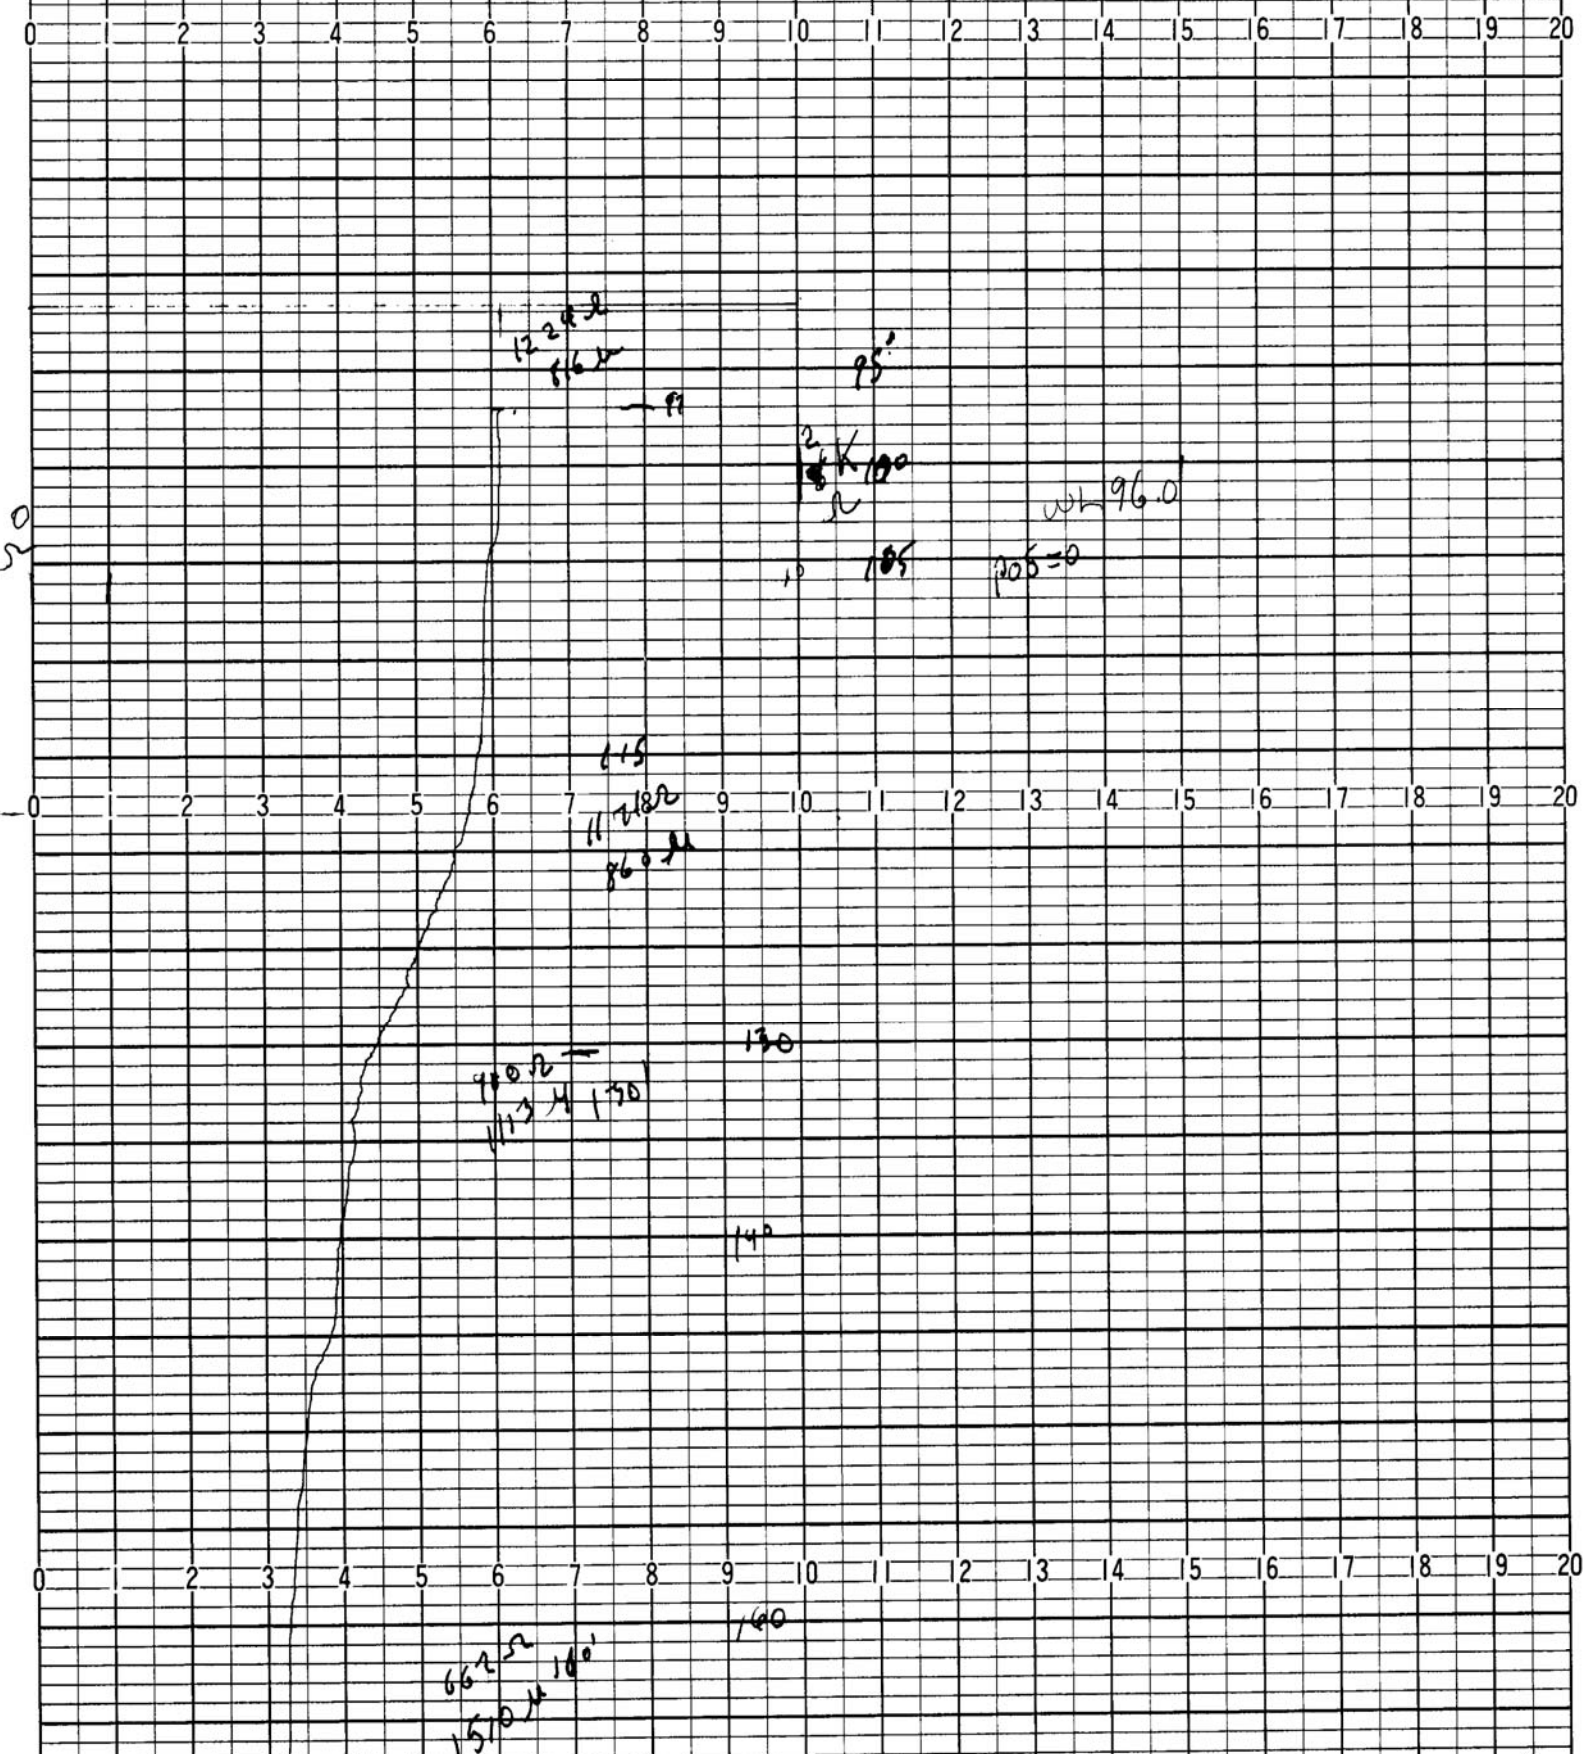

← well plugged at 170' - couldn't

9.2.1986

no aspect


~~64~~  
~~15~~  
180

0 2 3 4 5 6 7 8 9 10 11 12 13 14 15 16 17 18 19 20


0 1 2 3 4 5 6 7 8 9 10 11 12 13 14 15 16 17 18 19 20

0 1 2 3 4 5 6 7 8 9 10 11 12 13 14 15 16 17 18 19 20

0 1 2 3 4 5 6 7 8 9 10 11 12 13 14 15 16 17 18 19 20

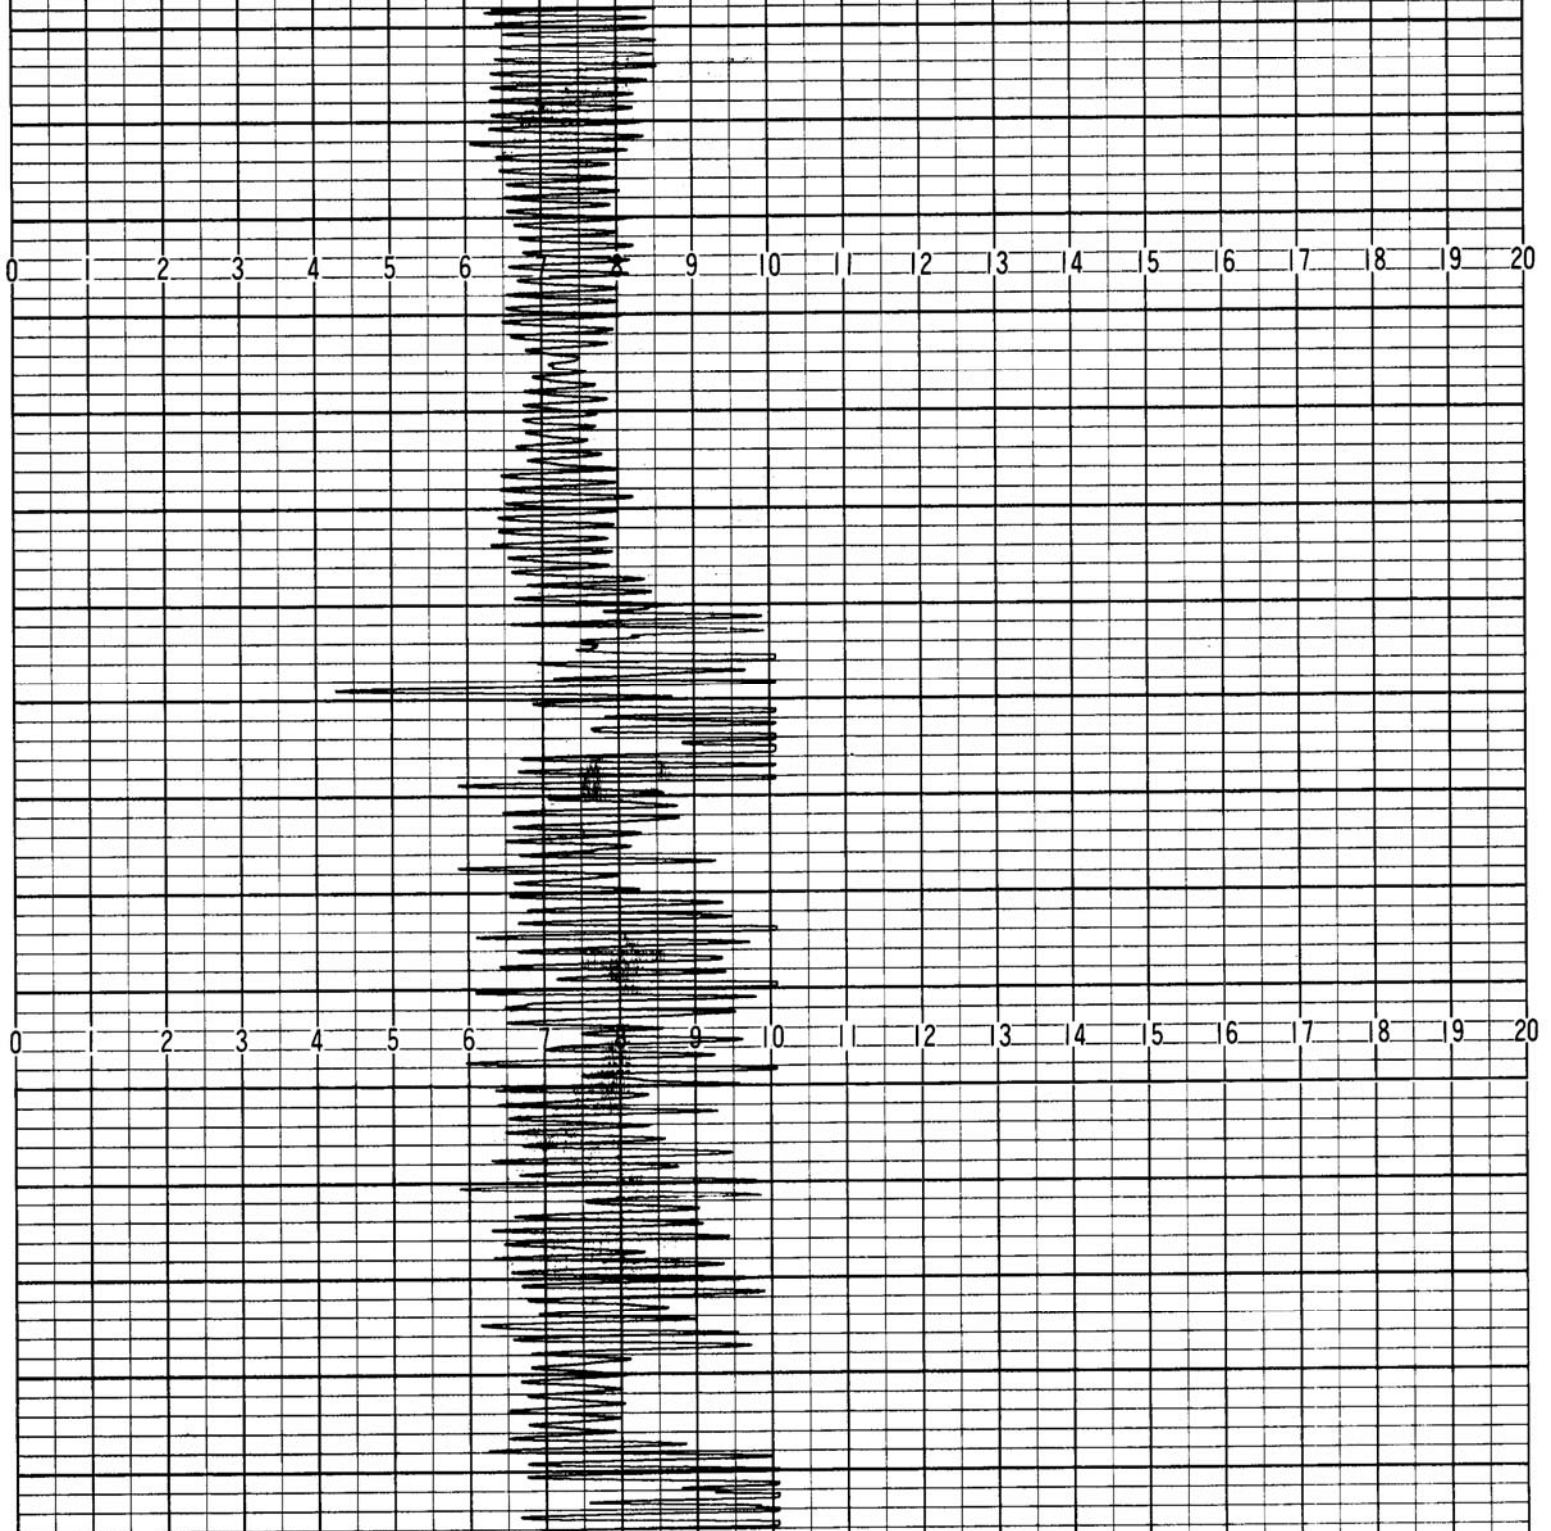



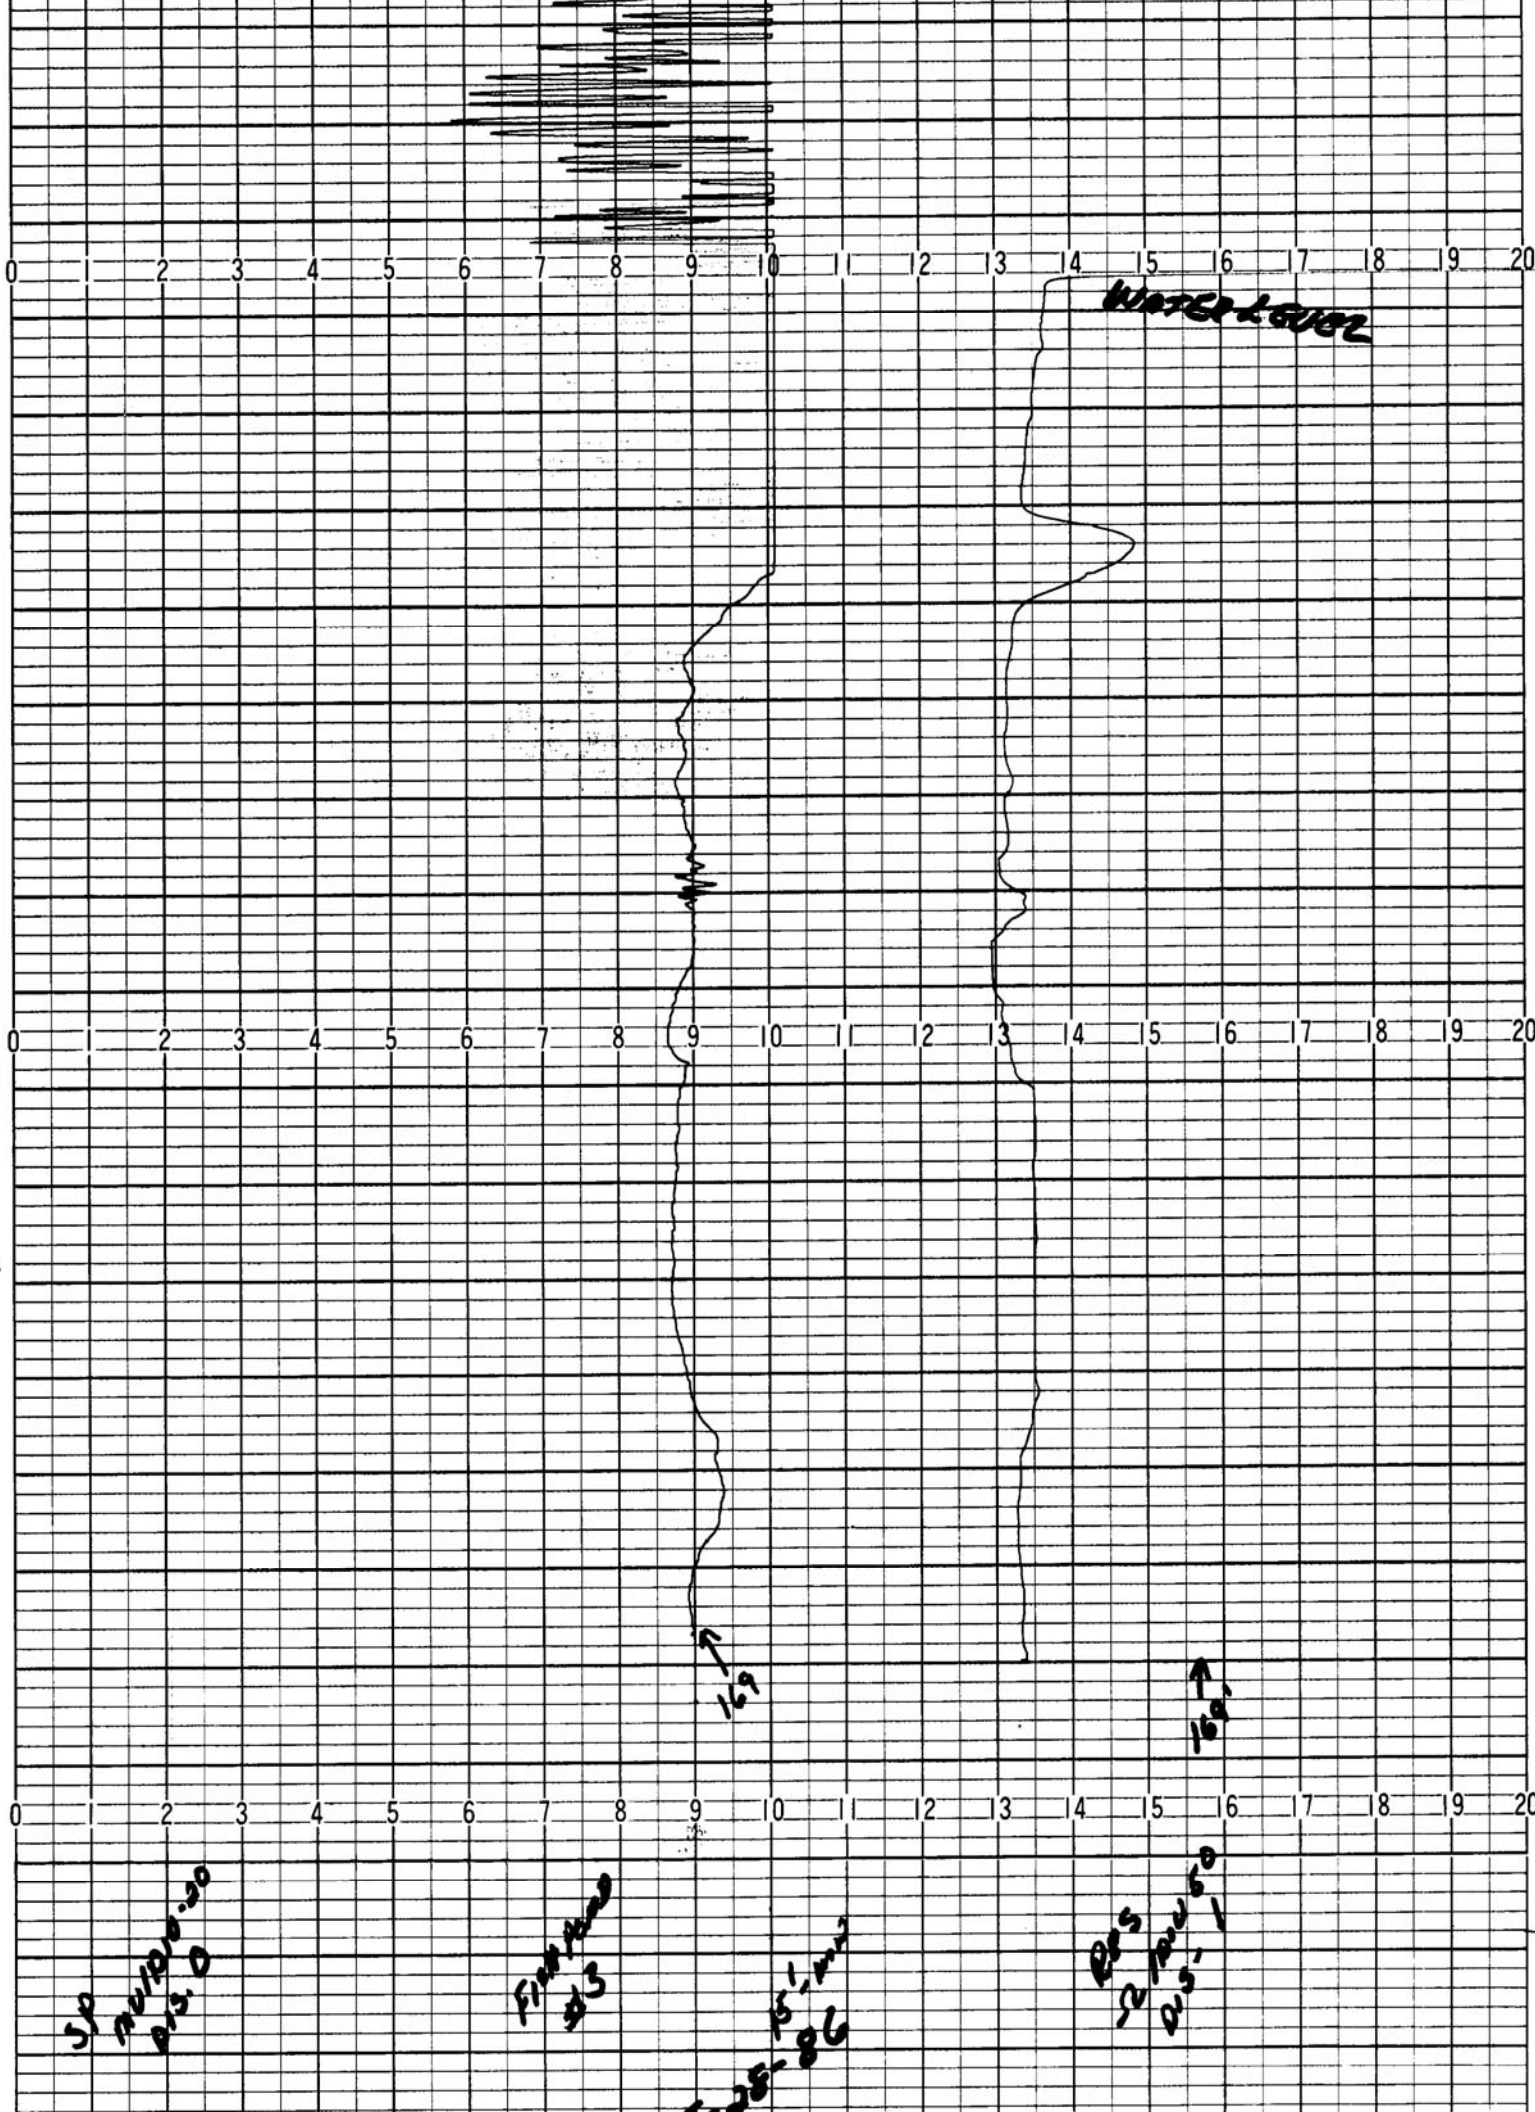

WATER LEVEL

169

169


SP  
17/10/80  
P.S. D

FISH  
#3

15-1-86

P.S.  
2/11/80  
P.S. 1



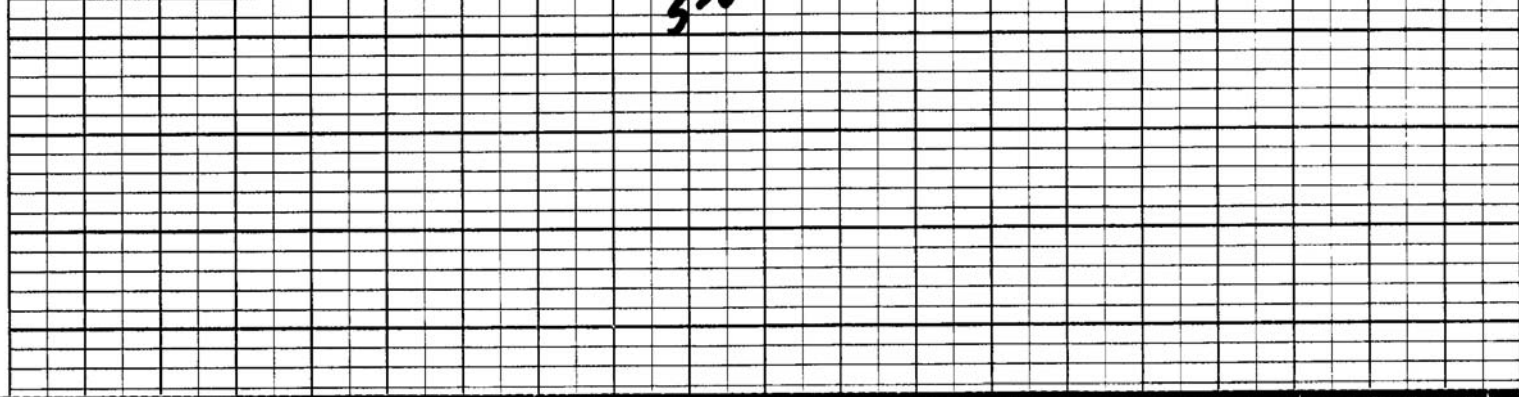



Fish ponds # 3  
7-29-85 New Probe

TV Mr R/M

SP



RES

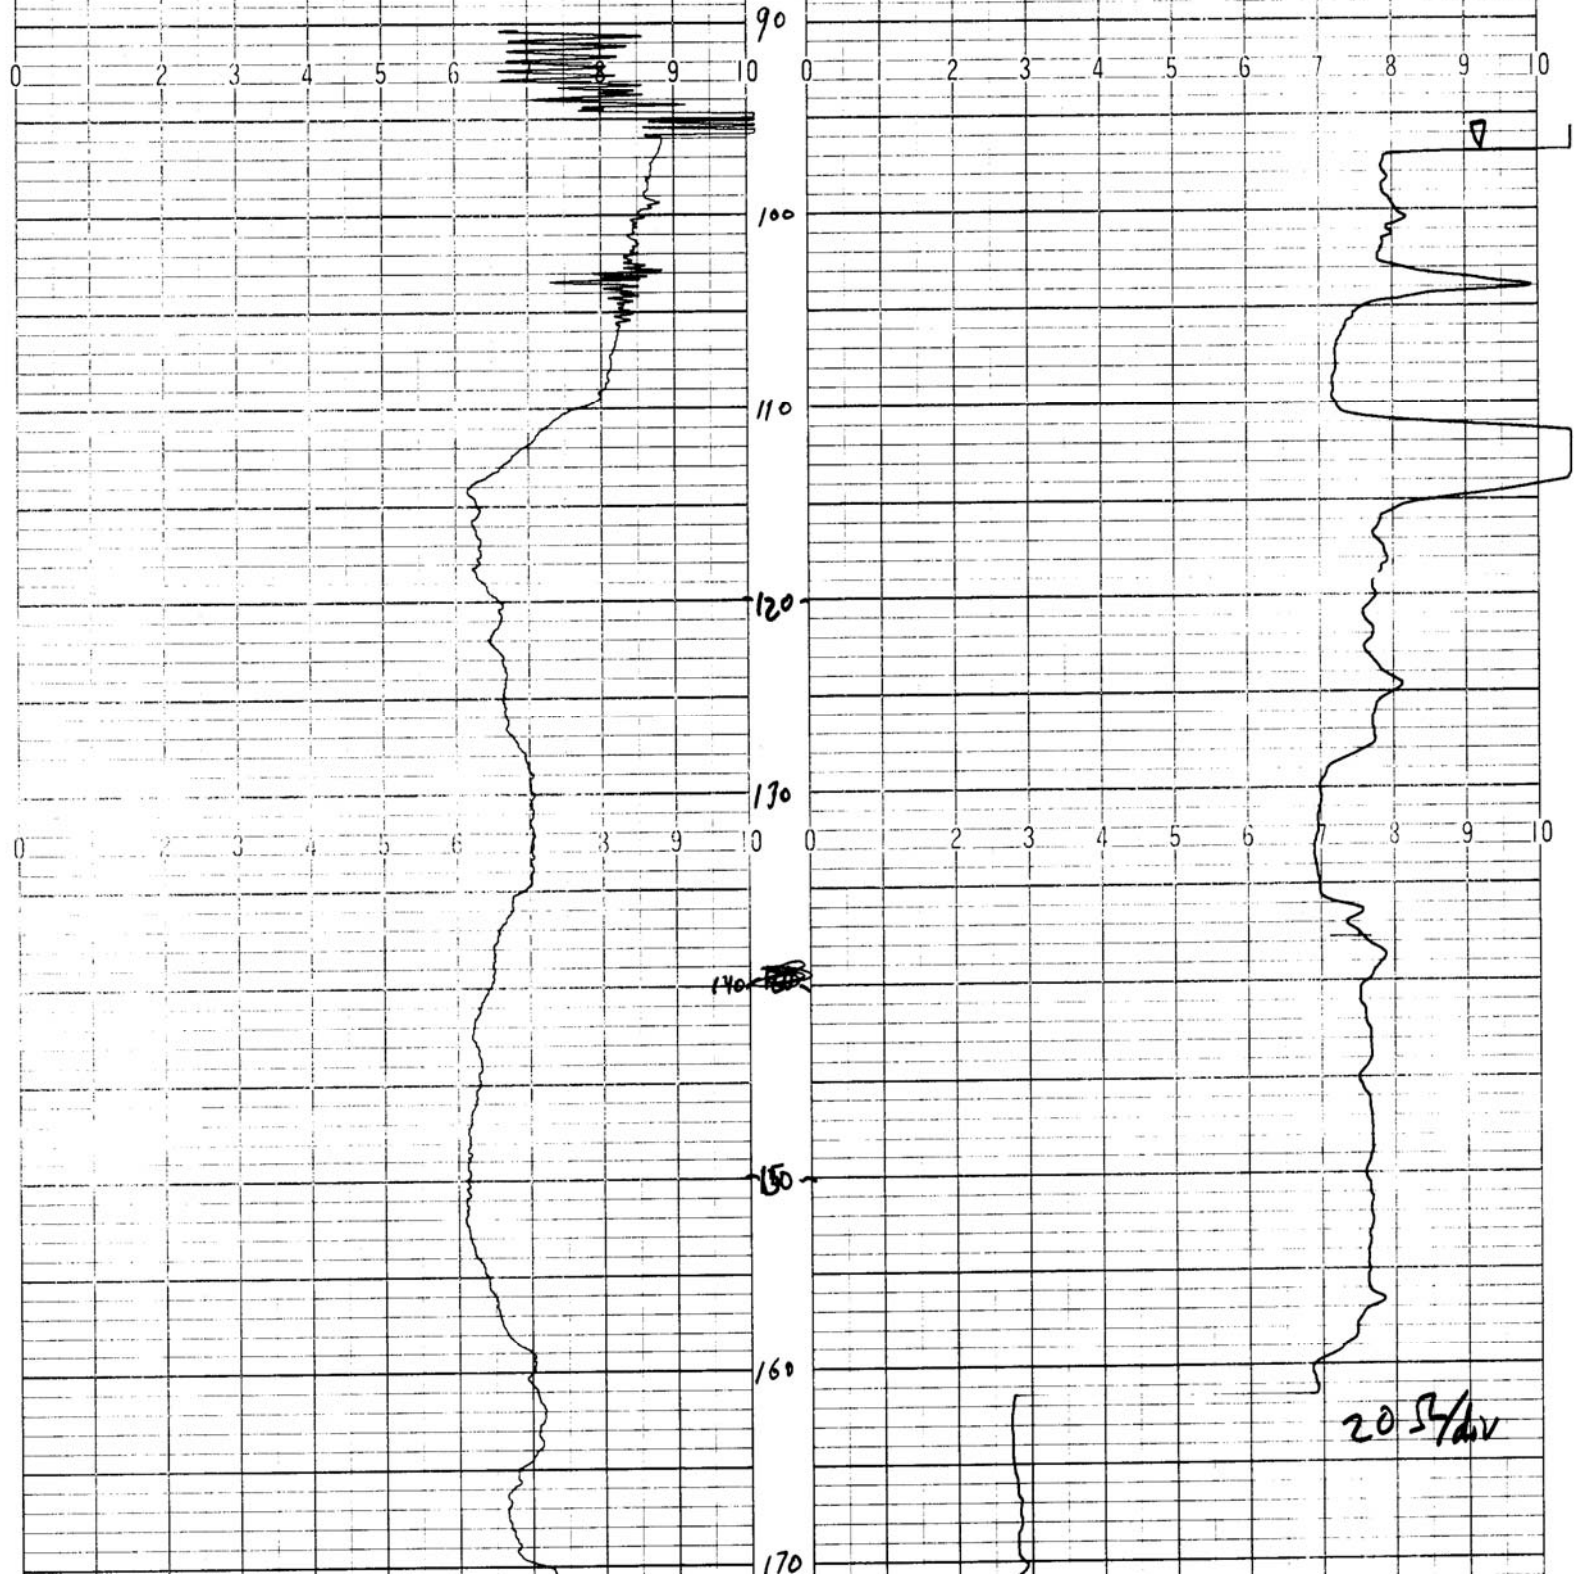

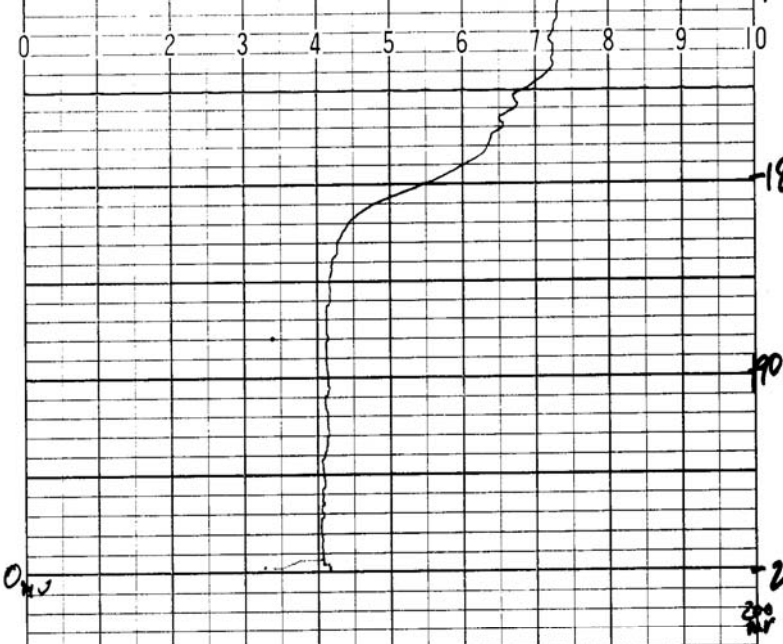




SP3    20  $\mu\text{V/div}$     200  $\mu\text{SP}$     10  $\text{ft}/10 \text{min}$

Gamma

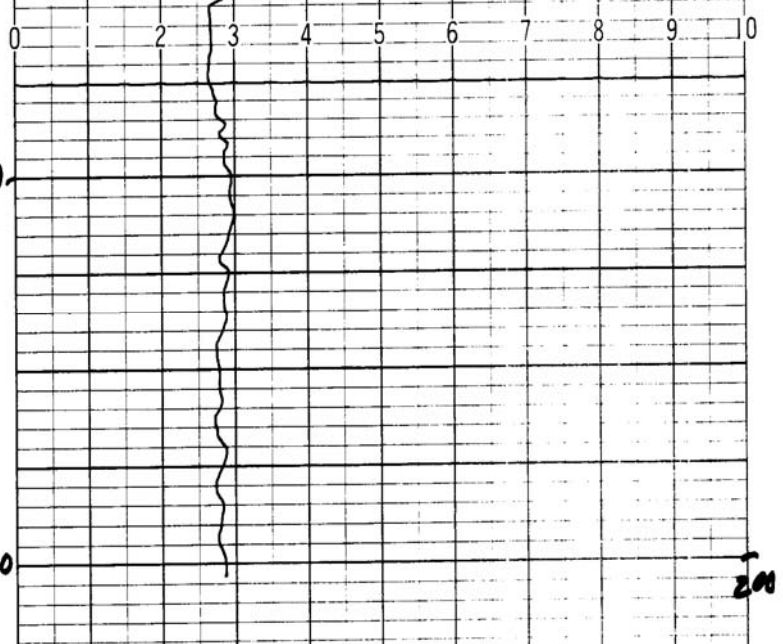
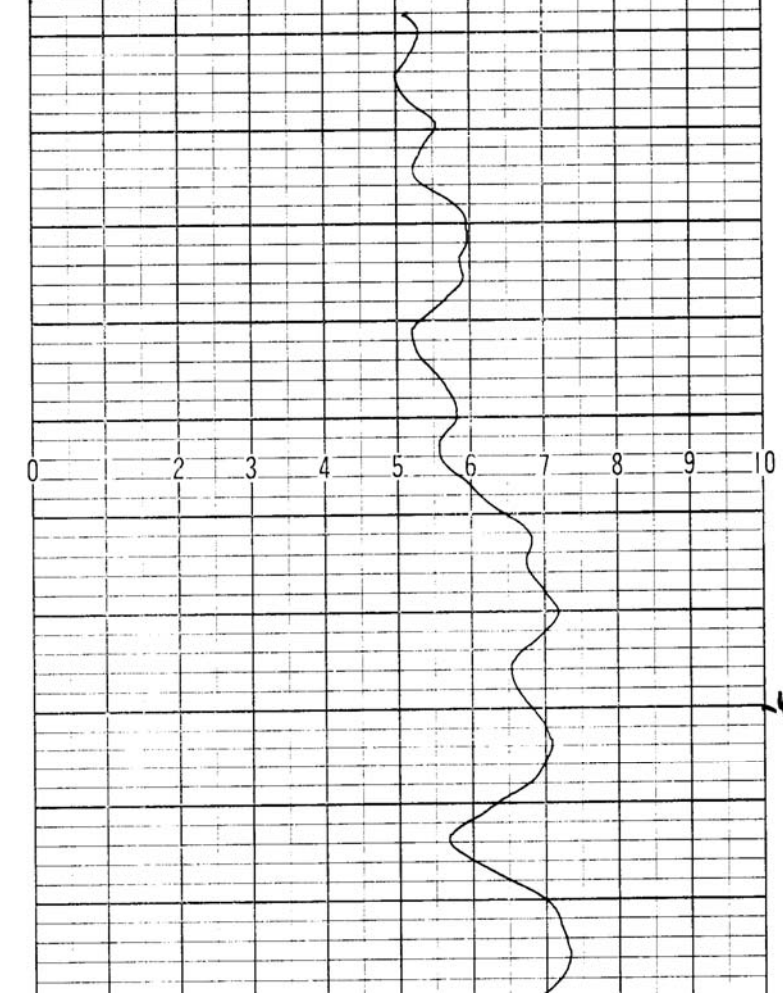


RES.    50  $\mu\text{V/div}$     2  $\mu\text{SP}$

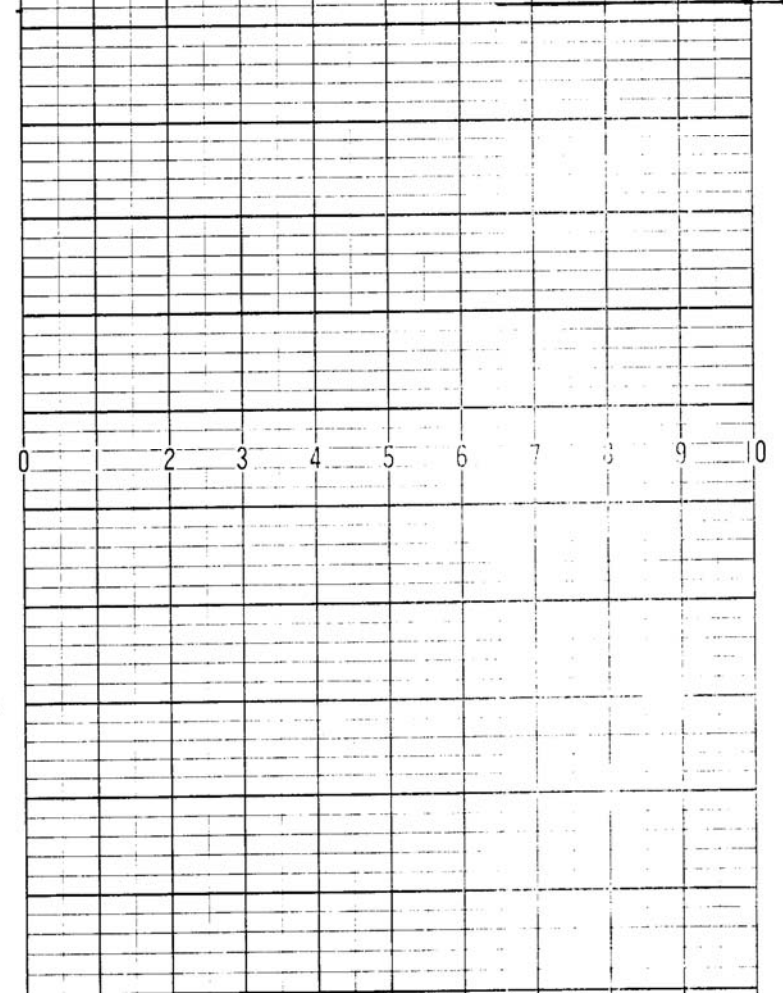

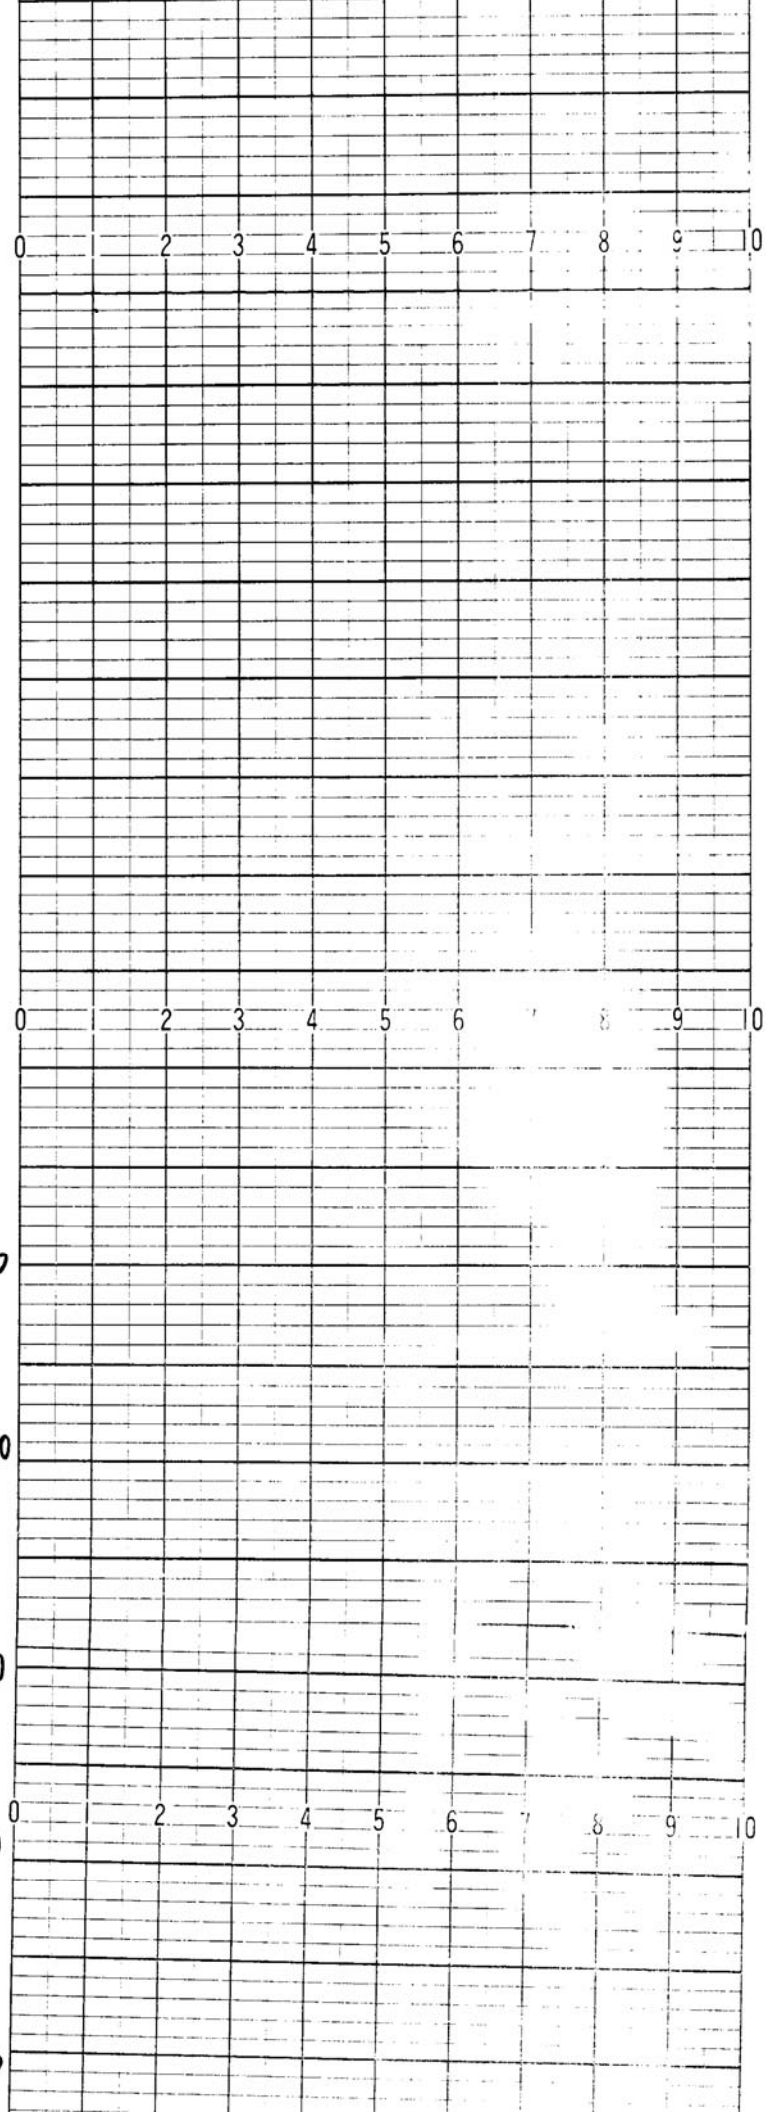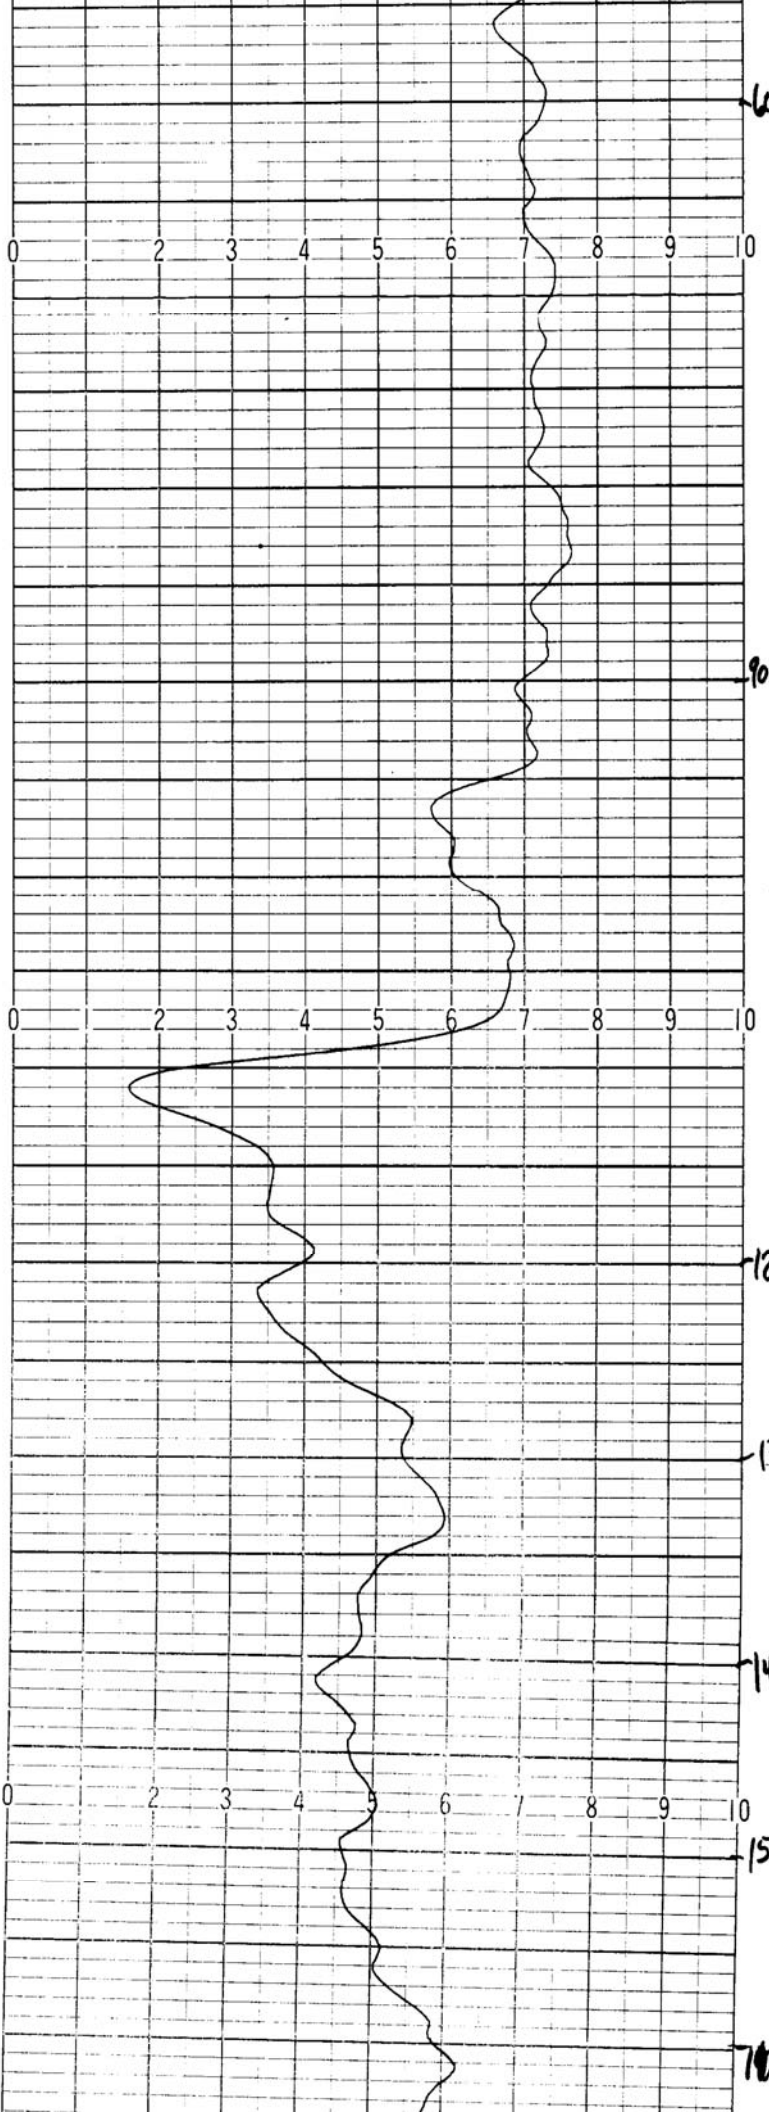



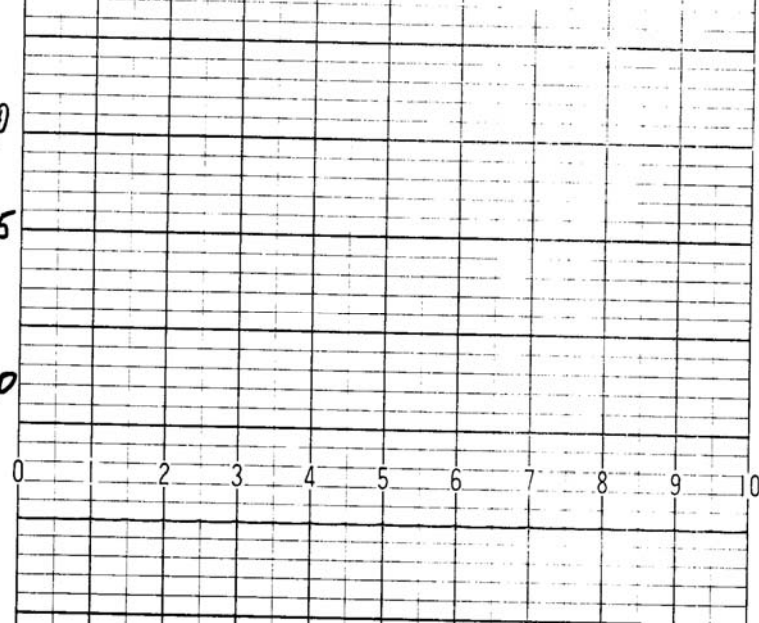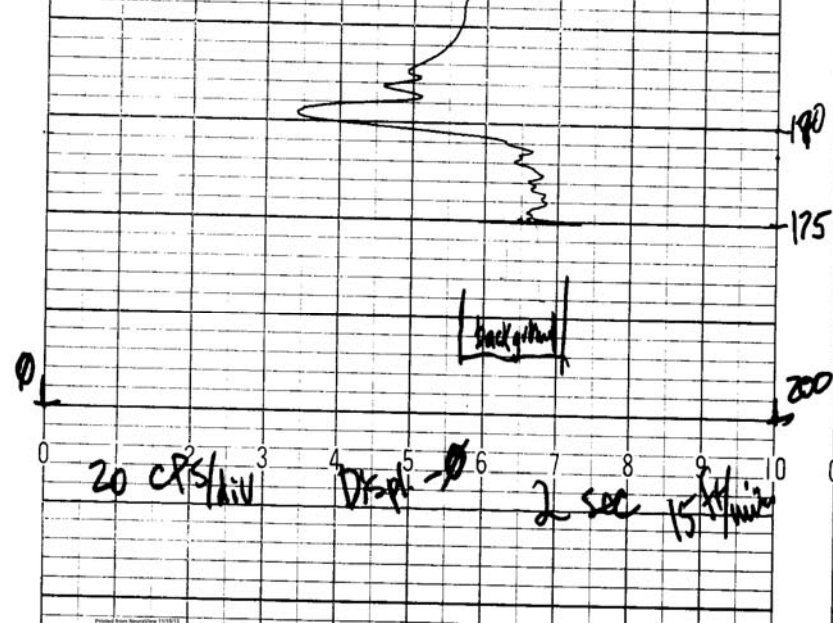

Res.

64"



Fish Ponds #3


7-26-85


1000  $\Omega$ /div

TVM

19000

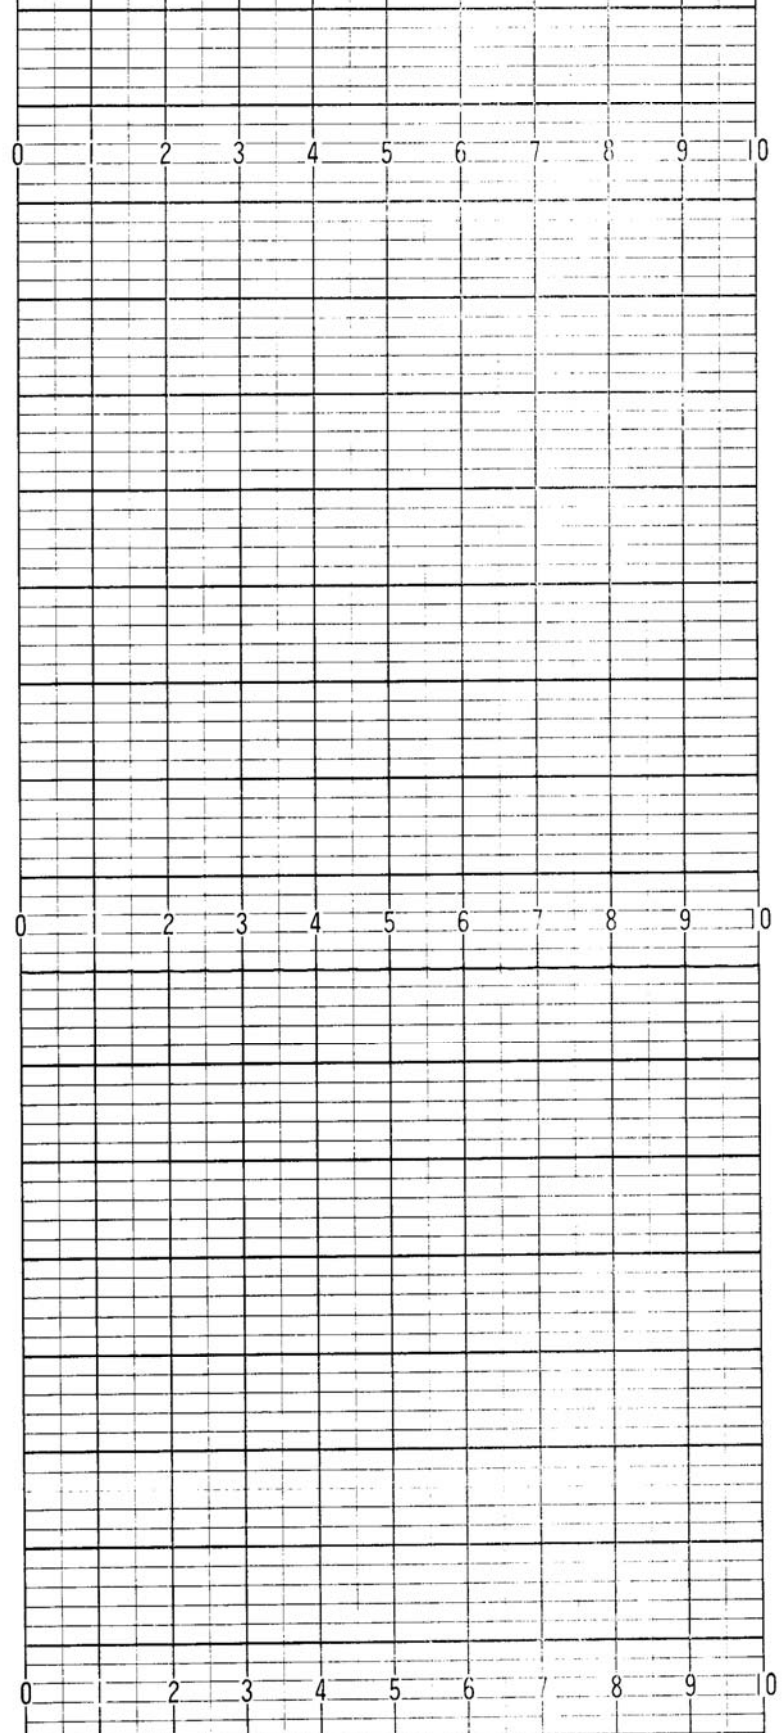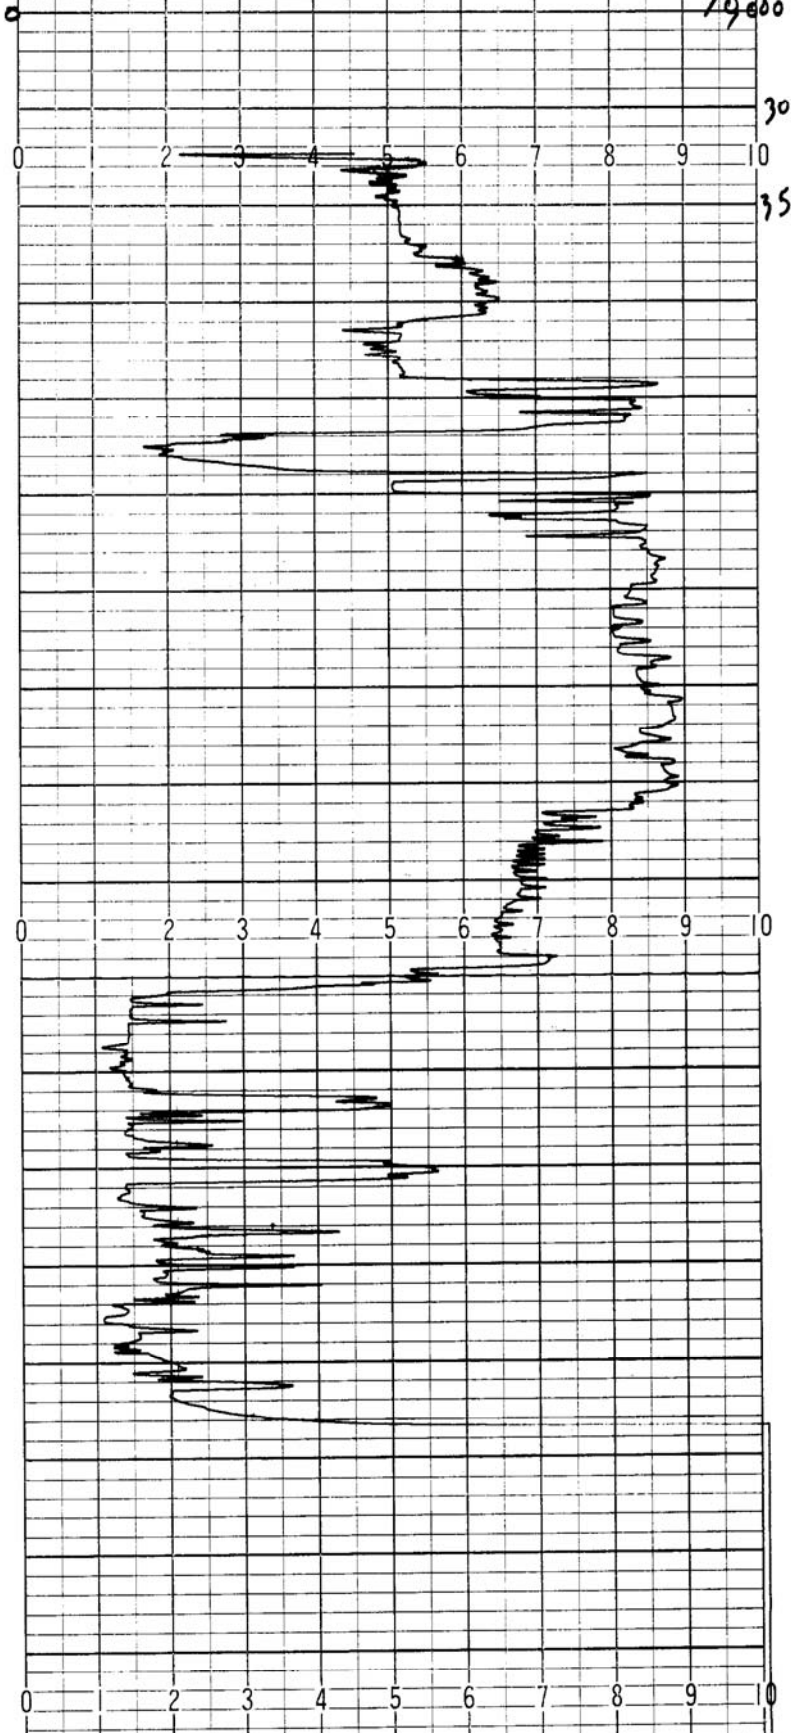

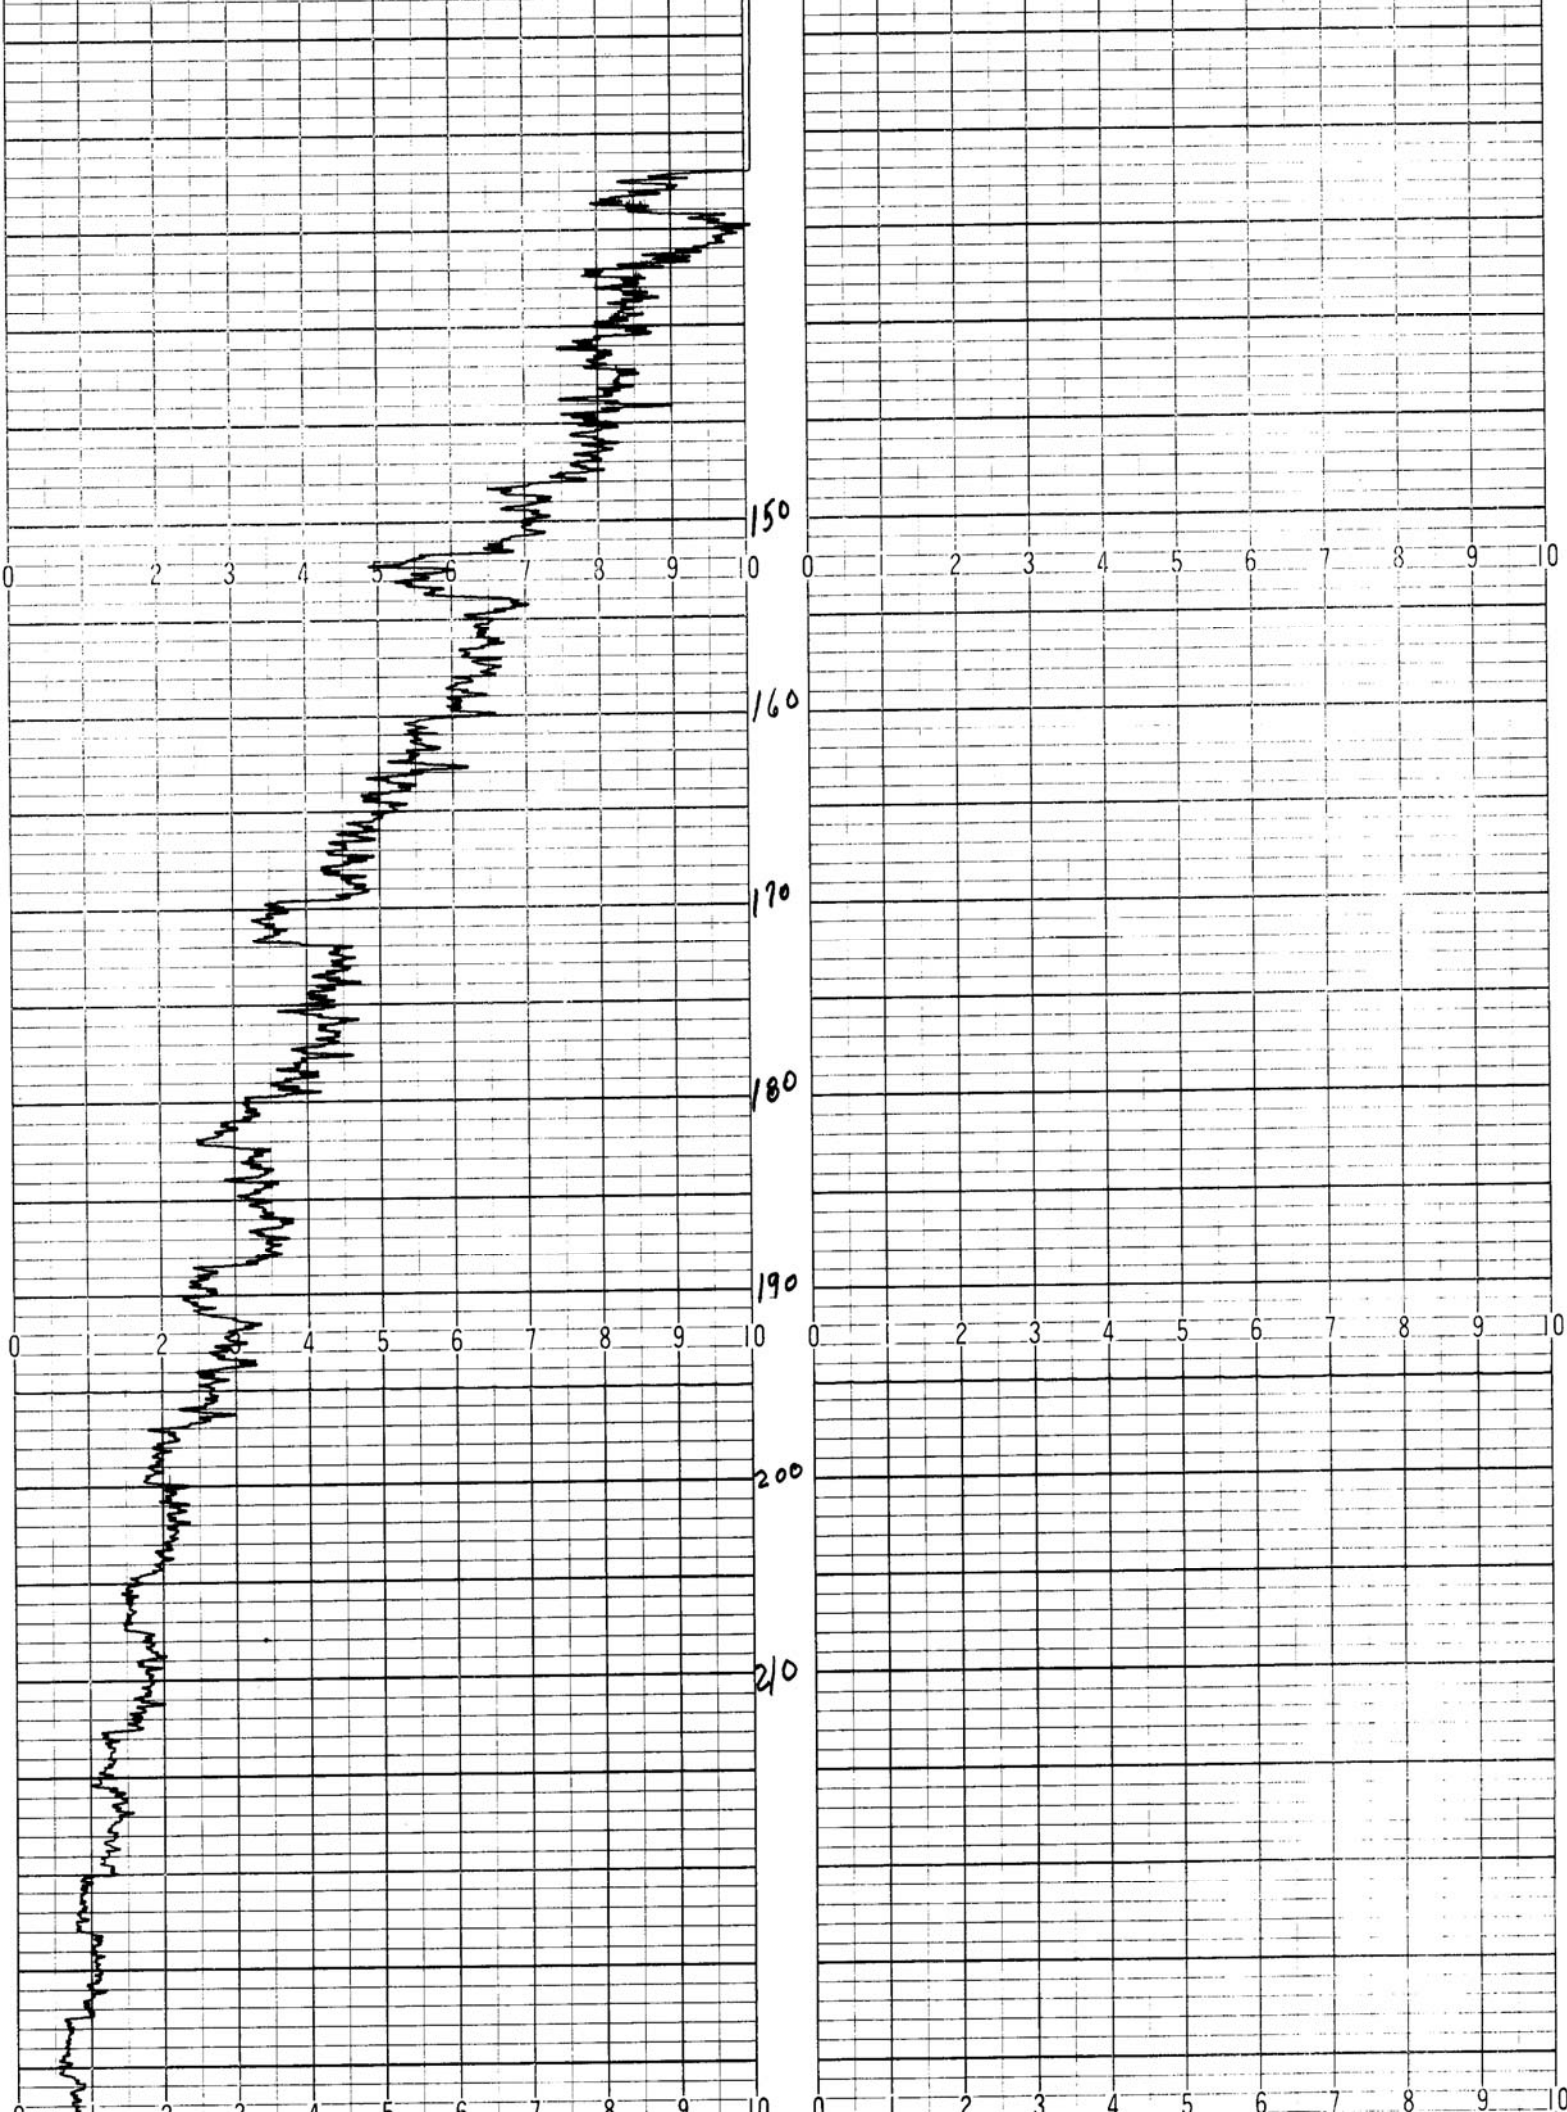


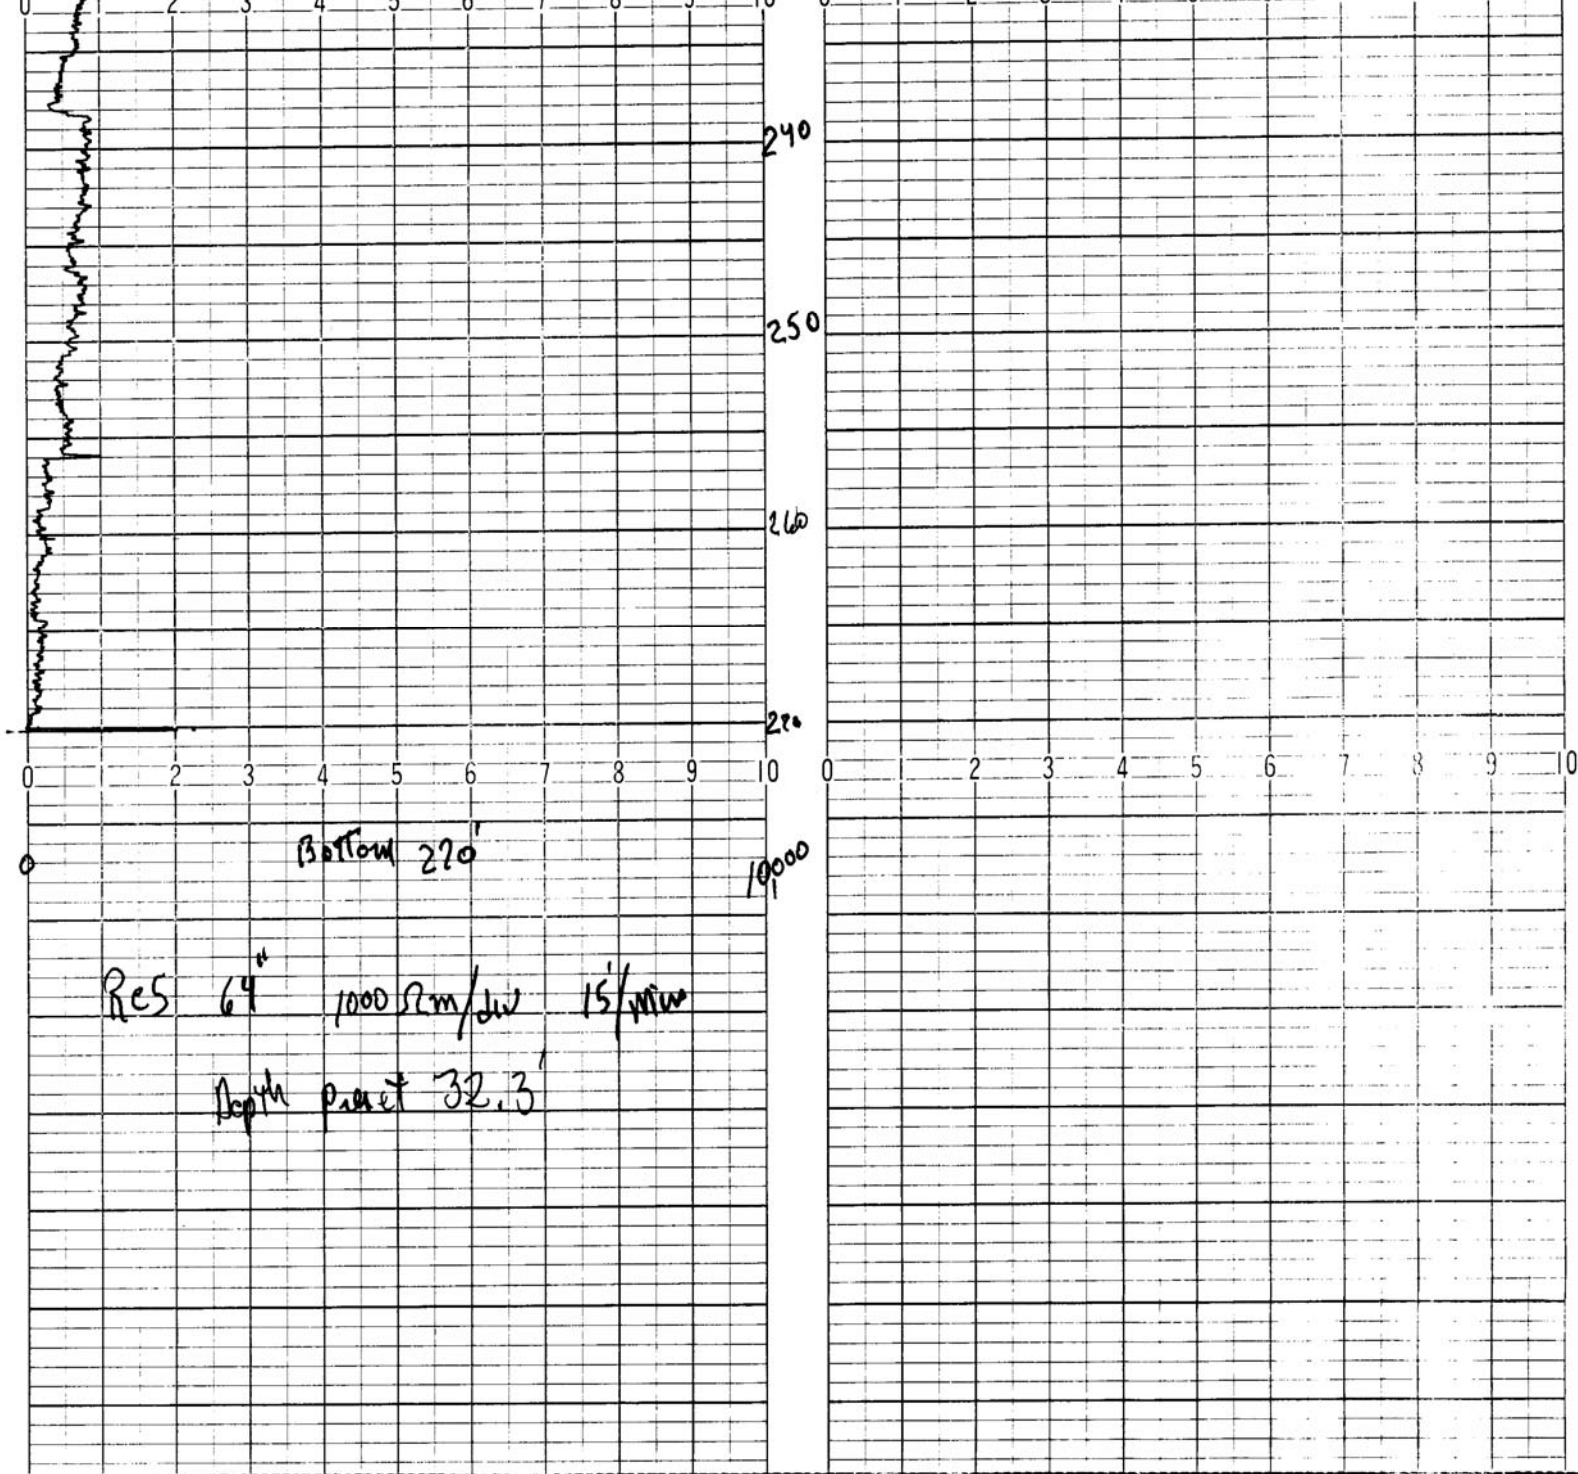




Fishponds #3 5-8-85


Run by T. M. Clayton

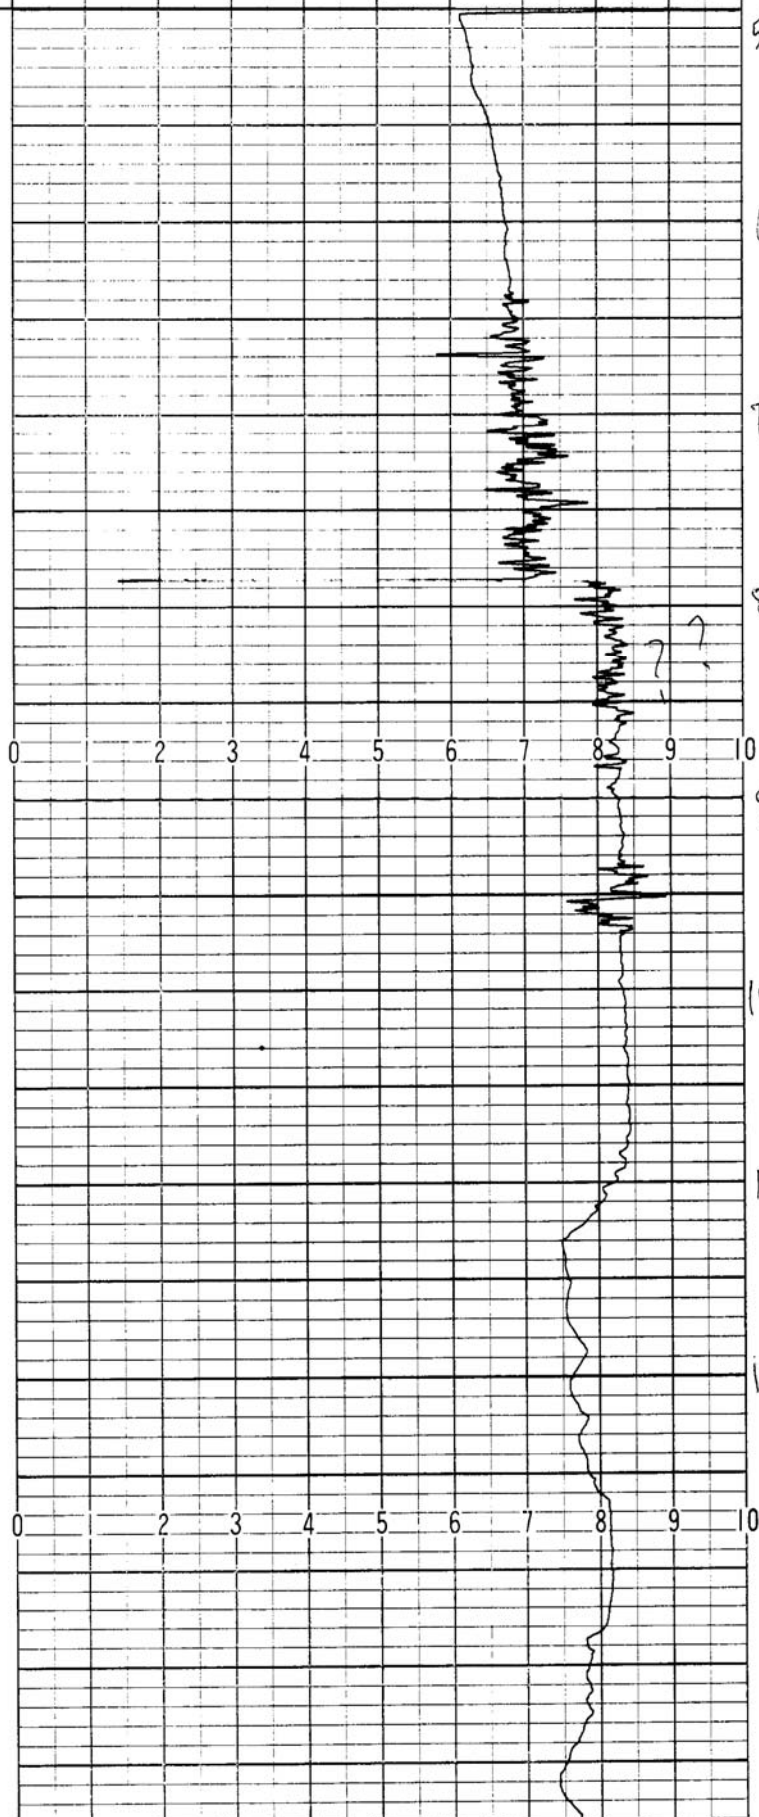



T13-R19E-204B E/922 msl

USGS M<sup>3</sup>-502115/99-06


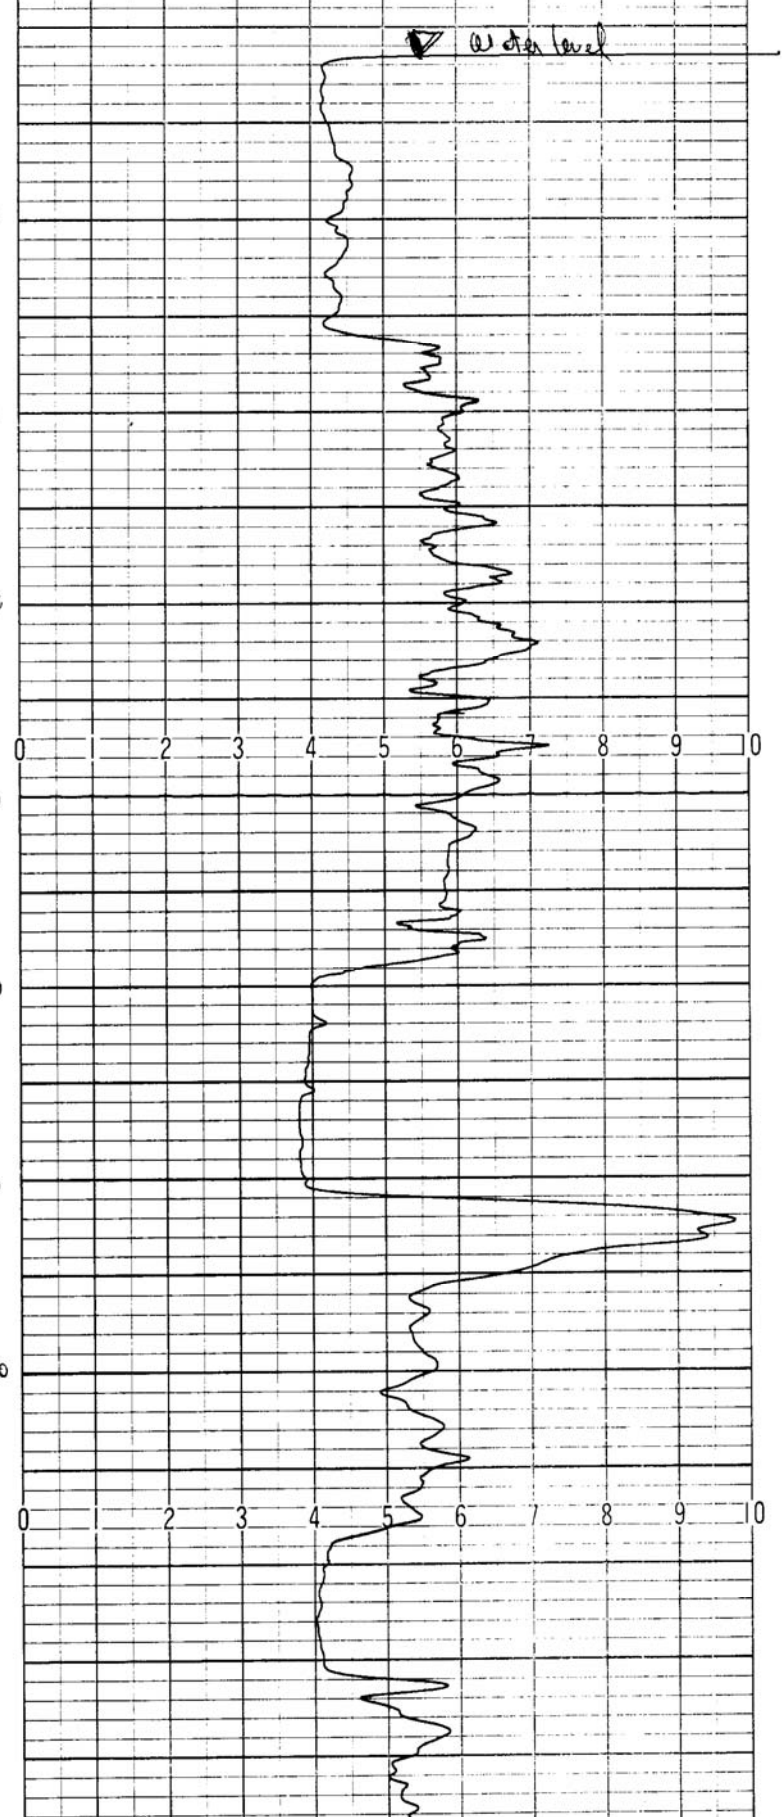


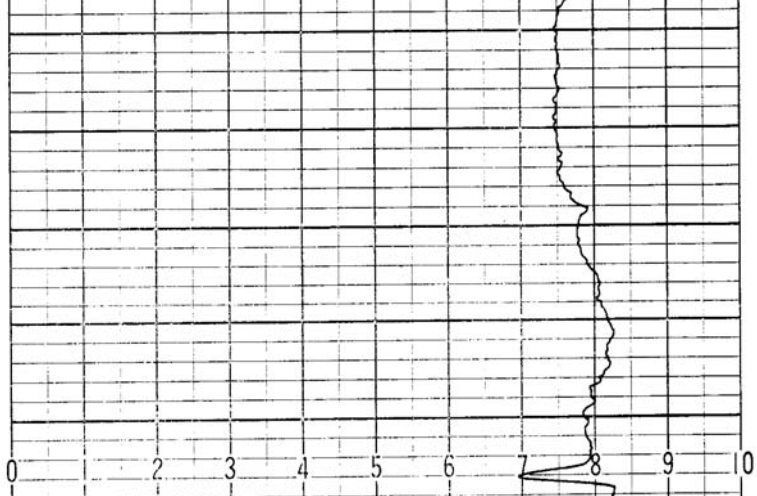

Change  
Dips  
to 4

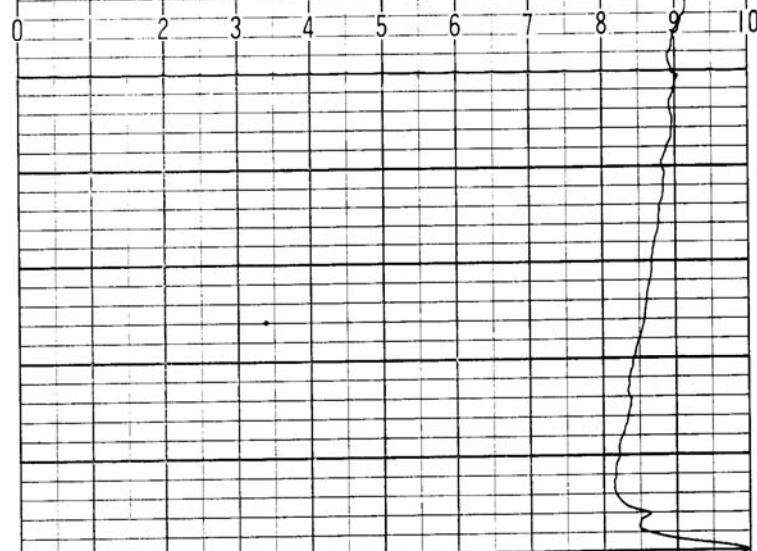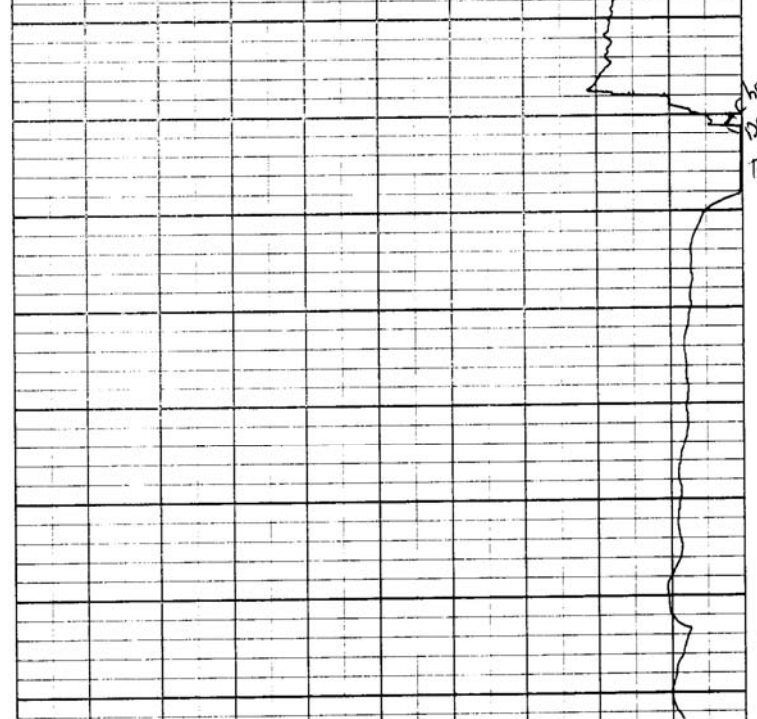

240  
250

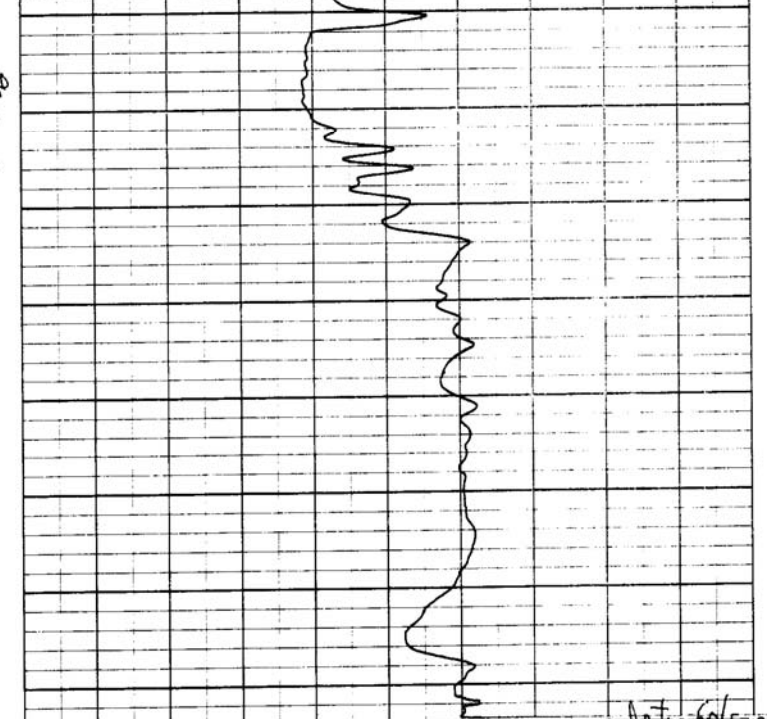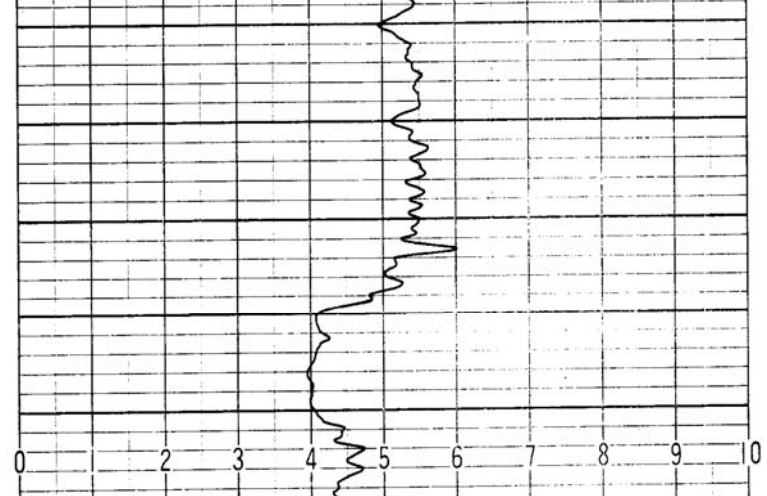

40 100 180 200 240 300 Change scale to 50/100

