


MWH 1

1 LOCATION OF WATER WELL: County: Douglas Fraction: SW 1/4 SW 1/4 SE 1/4 Section Number: 1 Township Number: T 13 S Range Number: R 19 EW

Distance and direction from nearest town or city street address of well if located within city?  
1000 WEST 23rd St Lawrence KS MWH 1

2 WATER WELL OWNER: EZ Shop INC  
 RR#, St. Address, Box #: 7215 S. TOPEKA BLVD City, State, ZIP Code: TOPEKA KS 66619  
 Board of Agriculture, Division of Water Resources Application Number:

3 LOCATE WELL'S LOCATION WITH AN "X" IN SECTION BOX:

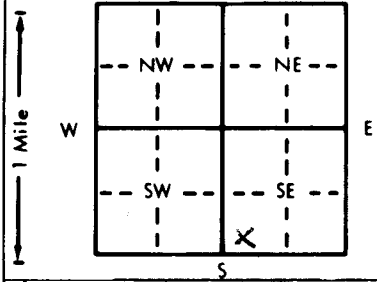

4 DEPTH OF COMPLETED WELL: 20 ft. ELEVATION:

Depth(s) Groundwater Encountered 1. 0 ft. 2. 0 ft. 3. 0 ft.  
 WELL'S STATIC WATER LEVEL: 0 ft. below land surface measured on mo/day/yr  
 Pump test data: Well water was 0 ft. after 0 hours pumping 0 gpm  
 Est. Yield 0 gpm. Well water was 0 ft. after 0 hours pumping 0 gpm  
 Bore Hole Diameter: 7.14 in. to 20 ft., and 0 in. to 0 ft.  
 WELL WATER TO BE USED AS:  
 1 Domestic 3 Feedlot 5 Public water supply 8 Air conditioning 11 Injection well  
 2 Irrigation 4 Industrial 6 Oil field water supply 9 Dewatering 12 Other (Specify below)  
 7 Lawn and garden only  Monitoring well  
 Was a chemical/bacteriological sample submitted to Department? Yes 0 No 0; If yes, mo/day/yr sample was submitted  
 Water Well Disinfected? Yes 0 No 0

5 TYPE OF BLANK CASING USED: 1 Steel 3 RMP (SR) 5 Wrought iron 8 Concrete tile CASING JOINTS: Glued 0 Clamped 0  
 PVC 4 ABS 7 Fiberglass 0 Welded 0  Threaded

Blank casing diameter: 2 in. to 10 ft., Dia. 0 in. to 0 ft., Dia. 0 in. to 0 ft.  
 Casing height above land surface: 0 in., weight SCH 40 lbs./ft. Wall thickness or gauge No. 0  
 TYPE OF SCREEN OR PERFORATION MATERIAL:  
 PVC 10 Asbestos-cement  
 1 Steel 3 Stainless steel 5 Fiberglass 8 RMP (SR) 11 Other (specify) 0  
 2 Brass 4 Galvanized steel 6 Concrete tile 9 ABS 12 None used (open hole)

SCREEN OR PERFORATION OPENINGS ARE:  
 1 Continuous slot  Mill slot 0.10 5 Gauzed wrapped 8 Saw cut 11 None (open hole)  
 2 Louvered shutter 4 Key punched 6 Wire wrapped 9 Drilled holes  
 7 Torch cut 10 Other (specify) 0

SCREEN-PERFORATED INTERVALS: From 20 ft. to 10 ft., From 0 ft. to 0 ft., From 0 ft. to 0 ft.  
 GRAVEL PACK INTERVALS: From 20 ft. to 8 ft., From 0 ft. to 0 ft., From 0 ft. to 0 ft.

6 GROUT MATERIAL: 1 Neat cement  Cement grout  Bentonite 4 Other 0  
 Grout intervals: From 5 ft. to 0.5 ft., From 8 ft. to 5 ft., From 0 ft. to 0 ft.

What is the nearest source of possible contamination:  
 1 Septic tank 4 Lateral lines 7 Pit privy 10 Livestock pens 14 Abandoned water well  
 2 Sewer lines 5 Cess pool 8 Sewage lagoon 11 Fuel storage 15 Oil well/Gas well  
 3 Watertight sewer lines 6 Seepage pit 9 Feedyard 12 Fertilizer storage  Other (specify below) FOURMEL JUST  
 13 Insecticide storage  
 Direction from well? South How many feet? 10'

FROM	TO	LITHOLOGIC LOG	FROM	TO	PLUGGING INTERVALS
0	6"	CONCRETE			
6"	5'	Brown Silty Clay			
5'	10'	Brown Silty Plastic Clay			
10'	15'	Silty Brown light Brown Clay			
15'	20'	Silty Sandy Brown Clay saturated at 15'			

7 CONTRACTOR'S OR LANDOWNER'S CERTIFICATION: This water well was  constructed,  reconstructed, or  plugged under my jurisdiction and was completed on (mo/day/year) 9-18-98 and this record is true to the best of my knowledge and belief. Kansas Water Well Contractor's License No. 575 This Water Well Record was completed on (mo/day/yr) 10-30-98 under the business name of KURTZ ENVIRONMENTAL SERVICE by (signature) [Signature]

OFFICE USE ONLY  
T  
R  
EW  
SEC.  
1/4  
1/4  
1/4