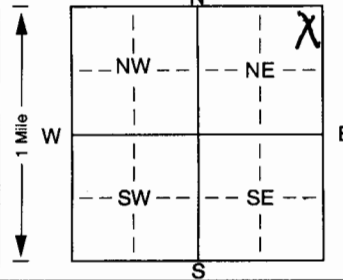


1] LOCATION OF WATER WELL: Fraction NE 1/4 NE 1/4 NE 1/4 Section Number 14 Township Number T 13 S Range Number R 190 EW
 County: DOUGLAS
 Distance and direction from nearest town or city street address of well if located within city?
3301 IOWA ST, LAWRENCE, KS 66047

2] WATER WELL OWNER: Will COKELEY
 RR#, St. Address, Box #: 976 EAST 23rd St Board of Agriculture, Division of Water Resources
 City, State, ZIP Code: LAWRENCE, KS 66046 Application Number:

3] LOCATE WELL'S LOCATION WITH AN "X" IN SECTION BOX:

 4] DEPTH OF COMPLETED WELL: 70 ft. ELEVATION:
 Depth(s) Groundwater Encountered 1. ft. 2. ft. 3. ft.
 WELL'S STATIC WATER LEVEL: 21 ft. below land surface measured on mo/day/yr 7-15-05
 Pump test data: Well water was ft. after hours pumping gpm
 Est. Yield gpm: Well water was ft. after hours pumping gpm
 Bore Hole Diameter in. to ft., and in. to ft.
 WELL WATER TO BE USED AS: 5 Public water supply 8 Air conditioning 11 Injection well
 Domestic 3 Feedlot 6 Oil field water supply 9 Dewatering 12 Other (Specify below)
 Irrigation 4 Industrial 7 Domestic (lawn & garden) 10 Monitoring well
 Was a chemical/bacteriological sample submitted to Department? Yes. No. ; If yes, mo/day/yr sample was submitted
 Water Well Disinfected? Yes No

5] TYPE OF BLANK CASING USED:
 Steel 3 RMP (SR) 5 Wrought iron 8 Concrete tile CASING JOINTS: Glued. Clamped.
 PVC 4 ABS 6 Asbestos-Cement 9 Other (specify below) Welded
 Fiberglass Threaded
 Blank casing diameter 6" in. to ft., Dia in. to ft., Dia in. to ft.
 Casing height above land surface 5 ft below in., weight lbs./ft. Wall thickness or gauge No. 1250
 TYPE OF SCREEN OR PERFORATION MATERIAL:
 Steel 3 Stainless steel 5 Fiberglass 7 PVC 10 Asbestos-cement
 Brass 4 Galvanized steel 6 Concrete tile 8 RMP (SR) 11 Other (specify) N/A
 ABS 12 None used (open hole)
 SCREEN OR PERFORATION OPENINGS ARE:
 Continuous slot 3 Mill slot 5 Gauzed wrapped 8 Saw cut 11 None (open hole)
 Louvered shutter 4 Key punched 6 Wire wrapped 9 Drilled holes N/A
 Torch cut 10 Other (specify) ft.
 SCREEN-PERFORATED INTERVALS: From ft. to ft., From ft. to ft.
 GRAVEL PACK INTERVALS: From ft. to ft., From ft. to ft.

6] GROUT MATERIAL: 1 Neat cement 2 Cement grout 3 Bentonite 4 Other
 Grout Intervals: From ft. to ft., From ft. to ft., From ft. to ft.
 What is the nearest source of possible contamination:
 Septic tank 4 Lateral lines 7 Pit privy 11 Fuel storage 14 Abandoned water well
 Sewer lines 5 Cess pool 8 Sewage lagoon 12 Fertilizer storage 15 Oil well/Gas well
 Watertight sewer lines 6 Seepage pit 9 Feedyard 13 Insecticide storage 16 Other (specify below)
 Direction from well? EAST How many feet? 60 ft Highway 59

FROM	TO	LITHOLOGIC LOG	FROM	TO	PLUGGING INTERVALS
			70	5	Bentonite hole plug
			5	0	TOP Soil

7] CONTRACTOR'S OR LANDOWNER'S CERTIFICATION: This water well was (1) constructed, (2) reconstructed, or (3) plugged under my jurisdiction and was completed on (mo/day/year) 7-15-05 and this record is true to the best of my knowledge and belief. Kansas Water Well Contractor's License No. 536 This Water Well Record was completed on (mo/day/yr) 7-22-05 under the business name of Patcher Pump & Well Drilling Inc by (signature) Tom E Patcher