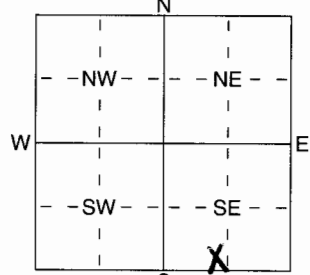


1 LOCATION OF WATER WELL: County: Douglas Fraction: SE 1/4 SW 1/4 SE 1/4 Section Number: 1 Township Number: T 13 S Range Number: R 19 EW
 Distance and direction from nearest town or city street address of well if located within city? 1000 SE W. 23rd St MW8

2 WATER WELL OWNER: Quick Stop Inc
 RR#, St. Address, Box #: 1000 W 23rd Board of Agriculture, Division of Water Resources
 City, State, ZIP Code: Lawrence KS 66604 Application Number:

3 LOCATE WELL'S LOCATION WITH AN "X" IN SECTION BOX:

 4 DEPTH OF COMPLETED WELL: 14 ft. ELEVATION: ft.
 Depth(s) Groundwater Encountered: 1 ft. 2 ft. 3 ft.
 WELL'S STATIC WATER LEVEL: 7.53 ft. below land surface measured on mo/day/yr: 5/19/05
 Pump test data: Well water was ft. after hours pumping gpm
 Est. Yield gpm: Well water was ft. after hours pumping gpm
 WELL WATER TO BE USED AS:
 1 Domestic 3 Feedlot 6 Oil field water supply 9 Dewatering 12 Other (Specify below)
 2 Irrigation 4 Industrial 7 Domestic (lawn & garden) 10 Monitoring well
 Was a chemical/bacteriological sample submitted to Department? Yes No; If yes, mo/day/yr sample was submitted
 Water Well Disinfected? Yes No

5 TYPE OF BLANK CASING USED:
 1 Steel 3 RMP (SR) 5 Wrought iron 8 Concrete tile CASING JOINTS: Glued Clamped
2 PVC 4 ABS 7 Fiberglass 9 Other (specify below) Welded
 Blank casing diameter: 2 in. to 4 ft., Dia in. to ft., Dia in. to ft.
 Casing height above land surface in., weight lbs./ft. Wall thickness or gauge No.
 TYPE OF SCREEN OR PERFORATION MATERIAL:
 1 Steel 3 Stainless Steel 5 Fiberglass 7 PVC 10 Asbestos-Cement
 2 Brass 4 Galvanized Steel 6 Concrete tile 8 RMP (SR) 11 Other (Specify)
 12 None used (open hole)
 SCREEN OR PERFORATION OPENINGS ARE:
 1 Continuous slot 3 Mill slot 5 Gauzed wrapped 8 Saw cut 11 None (open hole)
 2 Louvered shutter 4 Key punched 6 Wire wrapped 9 Drilled holes
 7 Torch cut 10 Other (specify) ft.
 SCREEN-PERFORATED INTERVALS: From 4 ft. to 14 ft., From ft. to ft.
 From ft. to ft., From ft. to ft.
 GRAVEL PACK INTERVALS: From 2.5 ft. to 14 ft., From ft. to ft.
 From ft. to ft., From ft. to ft.

6 GROUT MATERIAL: 1 Neat cement 2 Cement grout 3 Bentonite 4 Other
 Grout Intervals: From 1.5 ft. to 2.5 ft., From ft. to ft., From ft. to ft.
 What is the nearest source of possible contamination:
 1 Septic tank 4 Lateral lines 7 Pit privy 11 Fuel storage 14 Abandoned water well
 2 Sewer lines 5 Cess pool 8 Sewage lagoon 12 Fertilizer storage 15 Oil well/Gas well
 3 Watertight sewer lines 6 Seepage pit 9 Feedyard 13 Insecticide storage 16 Other (specify below)
 Direction from well? How many feet?

FROM	TO	LITHOLOGIC LOG	FROM	TO	PLUGGING INTERVALS
0	1'	Asphalt			
4'	6'	Clay w/ trace silt, mottled greenish grey, moist, slight pet. odor			
9'	11'	Clay w/ trace silt, blocky texture w/ iron nodules, mottled orange/brown			
12'	14'	Weathered Shale, brown			

Flushmount Wavier
by D. Taylor

7 CONTRACTOR'S OR LANDOWNER'S CERTIFICATION: This water well was (1) constructed, (2) reconstructed, or (3) plugged under my jurisdiction and was completed on (mo/day/year) 4/29/05 and this record is true to the best of my knowledge and belief. Kansas Water Well Contractor's Licence No. 257 This Water Well Record was completed on (mo/day/yr) 7/30/05 under the business name of Larsen & Associates by (signature) [Signature]