


1 LOCATION OF WATER WELL:	Fraction	Section Number	Township Number	Range Number
County: <u>Douglas</u>	<u>NW¹/₄ NW¹/₄ NW¹/₄</u>	<u>12</u>	<u>13 S</u>	<u>19</u> EW

Distance and direction from nearest town or city street address of well if located within city?
Located on Conoco Phillips Gas Station on Iowa St. by 23rd street in Lawrence, KS.

2 WATER WELL OWNER: <u>Conoco Phillips</u>	Board of Agriculture, Division of Water Resources
RR #, St. Address, Box #: <u>1234 Phillips Building</u>	Application Number:
City, State, ZIP Code: <u>Butterville, OK 74004</u>	

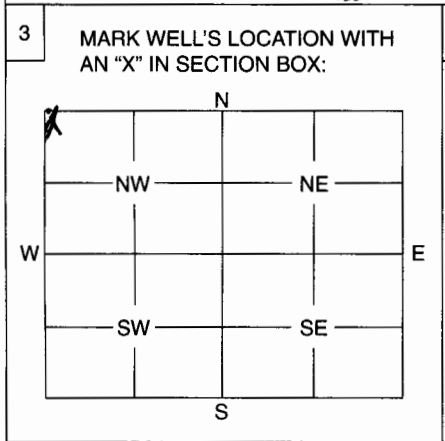

4 DEPTH OF WELL <u>20</u> ft.	9 Dewatering
WELL'S STATIC WATER LEVEL <u>16</u> ft.	<input checked="" type="radio"/> 10 Monitoring Well
WELL WAS USED AS:	11 Injection Well
1 Domestic	12 Other
2 Irrigation	
3 Feedlot	
4 Industrial	
5 Public Water Supply	
6 Oil Field Water Supply	
7 Domestic (Lawn & Garden)	
8 Air Conditioning	
Was a chemical / bacteriological sample submitted to Department? Yes No <input checked="" type="checkbox"/>	
If yes, mo/day/yr sample was submitted	
Water Well Disinfected: Yes No <input checked="" type="checkbox"/>	

5 TYPE OF BLANK CASING USED:

1 Steel	3 RMP (SR)	5 Wrought	7 Fiberglass	9 Other (Specify below)
<input checked="" type="radio"/> 2 PVC	4 ABS	6 Asbestos-Cement	8 Concrete Tile	

Blank casing diameter 2 in. Was casing pulled? Yes No If yes, how much AD

Casing height above or below land surface Flush in. Overdrilled using 8" Augers

6 GROUT PLUG MATERIAL: 1 Neat cement 2 Cement grout 3 Bentonite 4 Other

Grout Plug Intervals: From 20 ft. to 1 ft., From 1 ft. to 0 ft., From to ft.

concrete

What is the nearest source of possible contamination:

1 Septic tank	6 Seepage pit	<input checked="" type="radio"/> 11 Fuel storage	16 Other (specify below)
2 Sewer lines	7 Pit privy	12 Fertilizer storage	
3 Watertight sewer lines	8 Sewage lagoon	13 Insecticide storage	
4 Lateral lines	9 Feedyard	14 Abandoned water well	
5 Cess pool	10 Livestock pens	15 Oil well/Gas well	

Direction from well? How many feet?

FROM	TO	PLUGGING MATERIALS
<u>20</u>	<u>1</u>	<u>Bentonite</u>
<u>1</u>	<u>0</u>	<u>concrete</u>

7 CONTRACTOR'S OF LANDOWNER'S CERTIFICATION: This water well was plugged under my jurisdiction and was completed on (mo/day/year) 4.13/04 and this record is true to the best of my knowledge and belief. Kansas Water Well Contractor's License No. 710 This Water Well Record was completed on (mo/day/year) 4.16/04 under the business name of Below Ground Surfaces, Inc.

by (signature) [Signature]

INSTRUCTIONS: Use typewriter or ball point pen. Please press firmly and print clearly. Please fill in blanks, underline or circle the correct answers. Send top three copies to Kansas Department of Health and Environment, Bureau of Water, Geology Section, 1000 SW Jackson St., Ste. 420, Topeka, Kansas 66612-1367. Telephone: 785/296-5522. Send one to Water Well Owner and retain one for your records.