


1] LOCATION OF WATER WELL: County: Douglas	Fraction SW ¼ SW ¼ SE ¼	Section Number 1	Township Number T 13 S	Range Number R 19 (E/W)
--	-----------------------------------	----------------------------	----------------------------------	--

Distance and direction from nearest town or city street address of well if located within city?
1206 W. 23rd, Lawrence

2] WATER WELL OWNER: RR# St. Address, Box # City, State, ZIP Code	ExxonMobil Oil Corporation P.O. Box 874 Joliet, IL 60434	Board of Agriculture, Division of Water Resources Application Number:
---	--	--

3] LOCATE WELL'S LOCATION WITH AN "X" IN SECTION BOX:

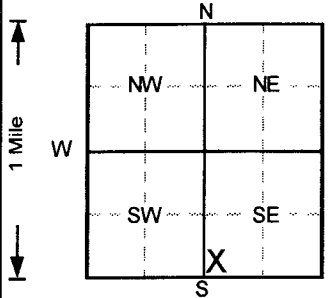

4] DEPTH OF COMPLETED WELL 12 ft ELEVATION: Depth(s) Groundwater Encountered 1..... ft 2..... ft 3..... ft WELL'S STATIC WATER LEVEL ft below land surface measured on mo/day/yr Pump test data: Well water was NA ft after hours pumping gpm Est. Yield NA gpm; Well water was ft after hours pumping gpm Bore Hole Diameter 8 in. to 16 ft, and..... in. to..... ft	OFFICE USE ONLY
WELL WATER TO BE USED AS: 5 Public water supply 1 Domestic 2 Irrigation	8 Air conditioning 9 Dewatering 10 Monitoring well (10) 11 Injection well 12 Other (Specify below)
Was a chemical/bacteriological sample submitted to Department? Yes.....No <input checked="" type="checkbox"/> ; If yes, mo/day/yr sample was submitted	Water Well Disinfected? Yes No <input checked="" type="checkbox"/>

5] TYPE OF BLANK CASING USED: 1 Steel 2 PVC Blank casing diameter 2 in. to 2 ft, Dia in. to..... ft Casing height above land surface 0 in., weight lbs./ft. Wall thickness or gauge No. Sch. 40	3 RMP (SR) 4 ABS	5 Wrought iron 6 Asbestos-Cement 7 Fiberglass	8 Concrete tile 9 Other (specify below)	CASING JOINTS: Glued Clamped Welded Threaded <input checked="" type="checkbox"/>
TYPE OF SCREEN OR PERFORATION MATERIAL 1 Steel 2 Brass SCREEN OR PERFORATION OPENINGS ARE: 1 Continuous slot 2 Louvered shutter		3 Stainless steel 4 Galvanized steel 5 Fiberglass 6 Concrete tile 7 PVC (7) 8 RMP (SR) 9 ABS 10 Asbestos-cement 11 Other (specify) 12 None used (open hole)		
SCREEN-PERFORATED INTERVALS: From 2 ft to 12 ft, From ft to ft From ft to ft, From ft to ft GRAVEL PACK INTERVALS: From 1.5 ft to 12 ft, From ft to ft From ft to ft, From ft to ft		8 Saw cut 9 Drilled holes 10 Other (specify) 11 None (open hole)		

6] GROUT MATERIAL: 1 Neat cement Grout Intervals: From 0 ft to 0.5 ft, From 0.5 ft to 1.5 ft, From ft to ft What is the nearest source of possible contamination: 1 Septic tank 2 Sewer lines 3 Watertight sewer lines Direction from well?	2 Cement grout (2) 3 Bentonite (3) 4 Other 10 Livestock pens 11 Fuel storage 12 Fertilizer storage 13 Insecticide storage	7 Pit privy 8 Sewage lagoon 9 Feedyard 14 Abandoned water well 15 Oil well/Gas well 16 Other (specify below)
---	---	---

FROM	TO	LITHOLOGIC LOG	FROM	TO	PLUGGING INTERVALS
0	2	Asphalt and fill gravel,			
2	3	Clay, v. silty, Brown-Black mottled			
3	5	Silt, clayey, Black			
5	10.5	Silt, v. clayey, tr. limestone gravel, Black			
10.5	16	Clay, w/limestone fragments, Brown-Gray Bla			
					MW6 - Cirillas, Flushmount

7] CONTRACTOR'S OR LANDOWNER'S CERTIFICATION: This water well was **(1)** constructed, (2) reconstructed, or (3) plugged under my jurisdiction and was completed on (mo/day/year) **6/24/2009** and this record is true to the best of my knowledge and belief.
 Kansas Water Well Contractor's License No. **527** This Water Well Record was completed on (mo/day/yr) **7/1/2009**
 under the business name of **GeoCore, Inc.** by (signature) **Dale Kell**

INSTRUCTIONS: Use typewriter or ball point pen. PLEASE PRESS FIRMLY and PRINT clearly. Please fill in blanks, underline or circle the correct answers. Send top three copies to Kansas Department of Health and Environment, Bureau of Water, Topeka, Kansas 66620-0001. Telephone: 913-296-5545. Send one to WATER WELL OWNER and retain one for your records.

OFFICE USE ONLY

T

R

EW

SEC.

¼

¼

¼