

WATER WELL PLUGGING RECORD Form WWC-5P KSA 82a-1212 ID NO.


1 LOCATION OF WATER WELL: Fraction NE 1/4 NE 1/4 NE 1/4 Section Number 12 Township Number 13 Range Number 19 EW
 County: Douglas

Distance and direction from nearest town or city street address of well if located within city?

2301 Louisiana St. Lawrence

2 WATER WELL OWNER: BP Products North America **Global Positioning Systems** (decimal degrees, min. of 4 digits)
 RR#, St. Address, Box #: 28100 Torch Pkwy Latitude: _____
 City, State ZIP Code: Warrenville, IL 60555 Longitude: _____
 Elevation: _____
 Datum: _____
 Data Collection Method: _____

3 MARK WELL'S LOCATION WITH AN "X" IN SECTION BOX:

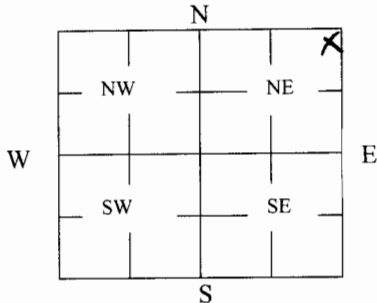

4 DEPTH OF WELL 15 ft.

WELL'S STATIC WATER LEVEL 4.92 ft aw-6

WELL WAS USED AS:

- | | | |
|--------------|----------------------------|---|
| 1 Domestic | 5 Public Water Supply | 9 Dewatering |
| 2 Irrigation | 6 Oil Field Water Supply | <input checked="" type="radio"/> Monitoring |
| 3 Feedlot | 7 Domestic (Lawn & Garden) | 11 Injection Well |
| 4 Industrial | 8 Air Conditioning | 12 Other _____ |

Was a chemical/bacteriological sample submitted to Department? Yes _____ No

5 TYPE OF BLANK CASING USED:

- | | | | | |
|--------------------------------------|------------|-------------------|-----------------|-------------------------|
| 1 Steel | 3 RMP (SR) | 5 Wrought | 7 Fiberglass | 9 Other (Specify below) |
| <input checked="" type="radio"/> PVC | 4 ABS | 6 Asbestos-Cement | 8 Concrete Tile | _____ |

Blank casing diameter 2 in. Was casing pulled? Yes No _____ If yes, how much 15 ft

Casing height above or below land surface _____ in.

6 GROUT PLUG MATERIAL: 1 Neat cement 2 Cement grout Bentonite 4 Other _____

Grout Plug Intervals: From 1 ft. to 15 ft., From _____ ft. to _____ ft., From _____ to _____ ft.

What is the nearest source of possible contamination:

- | | | | |
|--------------------------|-------------------|---|--------------------------------|
| 1 Septic tank | 6 Seepage pit | <input checked="" type="radio"/> Fuel Storage | 16 Other (specify below) |
| 2 Sewer lines | 7 Pit privy | 12 Fertilizer storage | _____ |
| 3 Watertight sewer lines | 8 Sewage lagoon | 13 Insecticide storage | _____ |
| 4 Lateral lines | 9 Feedyard | 14 Abandoned water well | Direction from well? <u>NE</u> |
| 5 Cess pool | 10 Livestock pens | 15 Oil well/Gas well | How many feet? <u>75</u> |

FROM	TO	PLUGGING MATERIALS	FROM	TO	PLUGGING MATERIALS
<u>0</u>	<u>1</u>	<u>concrete</u>			
<u>1</u>	<u>15</u>	<u>bentonite</u>			

7 CONTRACTOR'S OR LANDOWNER'S CERTIFICATION: This water well was plugged under my jurisdiction and was completed on (mo/day/year) 01/11/10 and this record is true to the best of my knowledge and belief. Kansas Water Well Contractor's License No. N/A. This Water Well Record was completed on (mo/day/year) 01/11/10 under the business name of Terranext, LLC by (signature) [Signature]

INSTRUCTIONS: Use typewriter or ballpoint pen. Please press firmly and print clearly. Please fill in blanks, underline or circle the correct answers. Send top three copies to Kansas Department of Health and Environment, Bureau of Water, Geology Section, 1000 SW Jackson St., Ste. 420, Topeka, Kansas 66612-1367. Telephone: 785/296-5522. Send one to Water Well Owner and retain one for your records. Visit us at <http://www.kdheks.gov/geo/waterwells>.