


1 LOCATION OF WATER WELL: Fraction SW Section Number 13 Township Number 13 Range Number 19
 County: DOUGLAS SW 1/4 NE 1/4

Distance and direction from nearest town or city street address of well if located within city?
1/4 mile south of Lawrence City limits on N1250 RD

2 WATER WELL OWNER: KDOT Global Positioning Systems (decimal degrees, min. of 4 digits)
 RR#, St. Address, Box #: 14162 US Highway 40 Latitude: _____
 City, State ZIP Code: Lawrence, KS 66044 Longitude: _____
 Elevation: _____
 Datum: _____
 Data Collection Method: _____

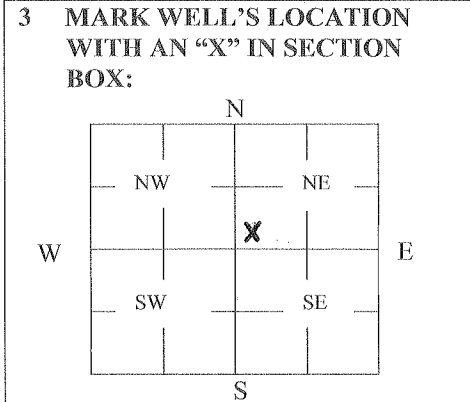

4 DEPTH OF WELL 95' ft.
 WELL'S STATIC WATER LEVEL 16' ft.
 WELL WAS USED AS:
 Domestic 5 Public Water Supply 9 Dewatering
 2 Irrigation 6 Oil Field Water Supply 10 Monitoring
 3 Feedlot 7 Domestic (Lawn & Garden) 11 Injection Well
 4 Industrial 8 Air Conditioning 12 Other _____
 Was a chemical/bacteriological sample submitted to Department? Yes _____ No

5 TYPE OF BLANK CASING USED:
 Steel 3 RMP (SR) 5 Wrought 7 Fiberglass 9 Other (Specify below) _____
 2 PVC 4 ABS 6 Asbestos-Cement 8 Concrete Tile _____
 Blank casing diameter 5" in. Was casing pulled? Yes _____ No If yes, how much _____
 Casing height ~~above~~ below land surface 6 FT.

6 GROUT PLUG MATERIAL: 1 Neat cement 2 Cement grout Bentonite 4 Other _____
 Grout Plug Intervals: From 95 ft. to 6 ft., From _____ ft. to _____ ft., From _____ to _____ ft.

What is the nearest source of possible contamination:
 1 Septic tank 6 Seepage pit 11 Fuel Storage 16 Other (specify below) Highway
 2 Sewer lines 7 Pit privy 12 Fertilizer storage
 3 Watertight sewer lines 8 Sewage lagoon 13 Insecticide storage
 4 Lateral lines 9 Feedyard 14 Abandoned water well Direction from well? South
 5 Cess pool 10 Livestock pens 15 Oil well/Gas well How many feet? 15'

| FROM | TO | PLUGGING MATERIALS | FROM | TO | PLUGGING MATERIALS |
|-----------|----------|----------------------------|------|----|--------------------|
| <u>95</u> | <u>6</u> | <u>Bentonite Hole plug</u> | | | |
| <u>6</u> | <u>0</u> | <u>TOP SOIL</u> | | | |
| | | | | | |
| | | | | | |

7 CONTRACTOR'S OR LANDOWNER'S CERTIFICATION: This water well was plugged under my jurisdiction and was completed on (mo/day/year) 9-30-14 and this record is true to the best of my knowledge and belief. Kansas Water Well Contractor's License No. 586. This Water Well Record was completed on (mo/day/year) 10-6-14 under the business name of Patched Pump & Well Drilling, Inc by (signature) Jim E. Patcher