



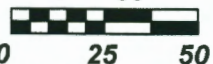



MW10

Well ID

Revised 7/10/2015

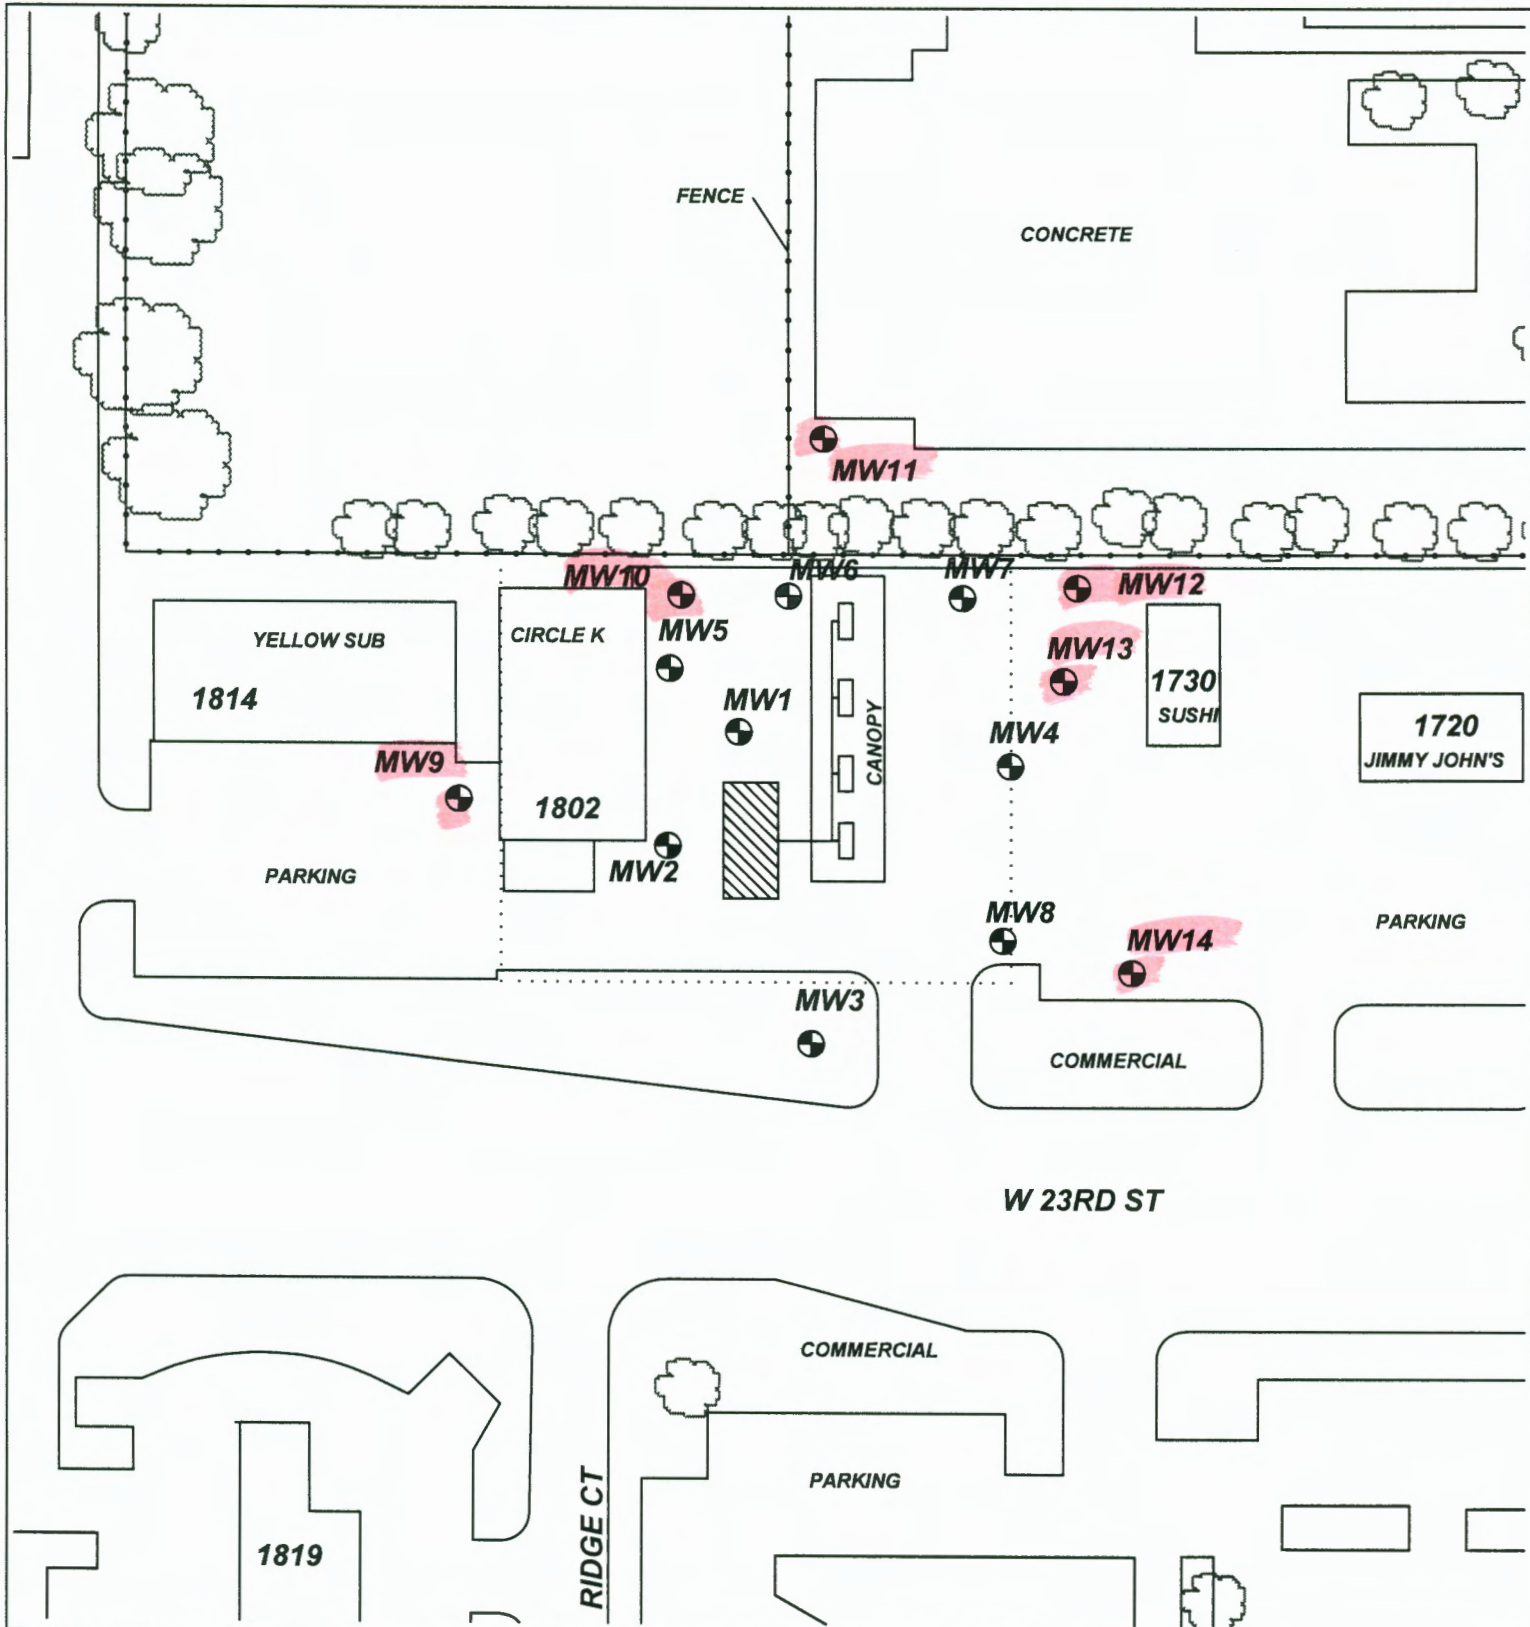

PROJECT: THE PANTRY #1628 ADDRESS: 1802 W. 23RD ST. LOCATION: LAWRENCE, KS DRAWN BY: B. STALNAKER DATE: 12/3/19 REVISED BY: B. STALNAKER DATE: 9/1/20 AEI JOB #: TF524 KOHE JOB #: U2-023-14543		TITLE:  ASSOCIATED ENVIRONMENTAL INC.	LEGEND:  = EXISTING UST'S AND PUMP ISLANDS  = MONITORING WELL  = SUBJECT PROPERTY
SCALE: 1" = 50' 		NOTES:	