

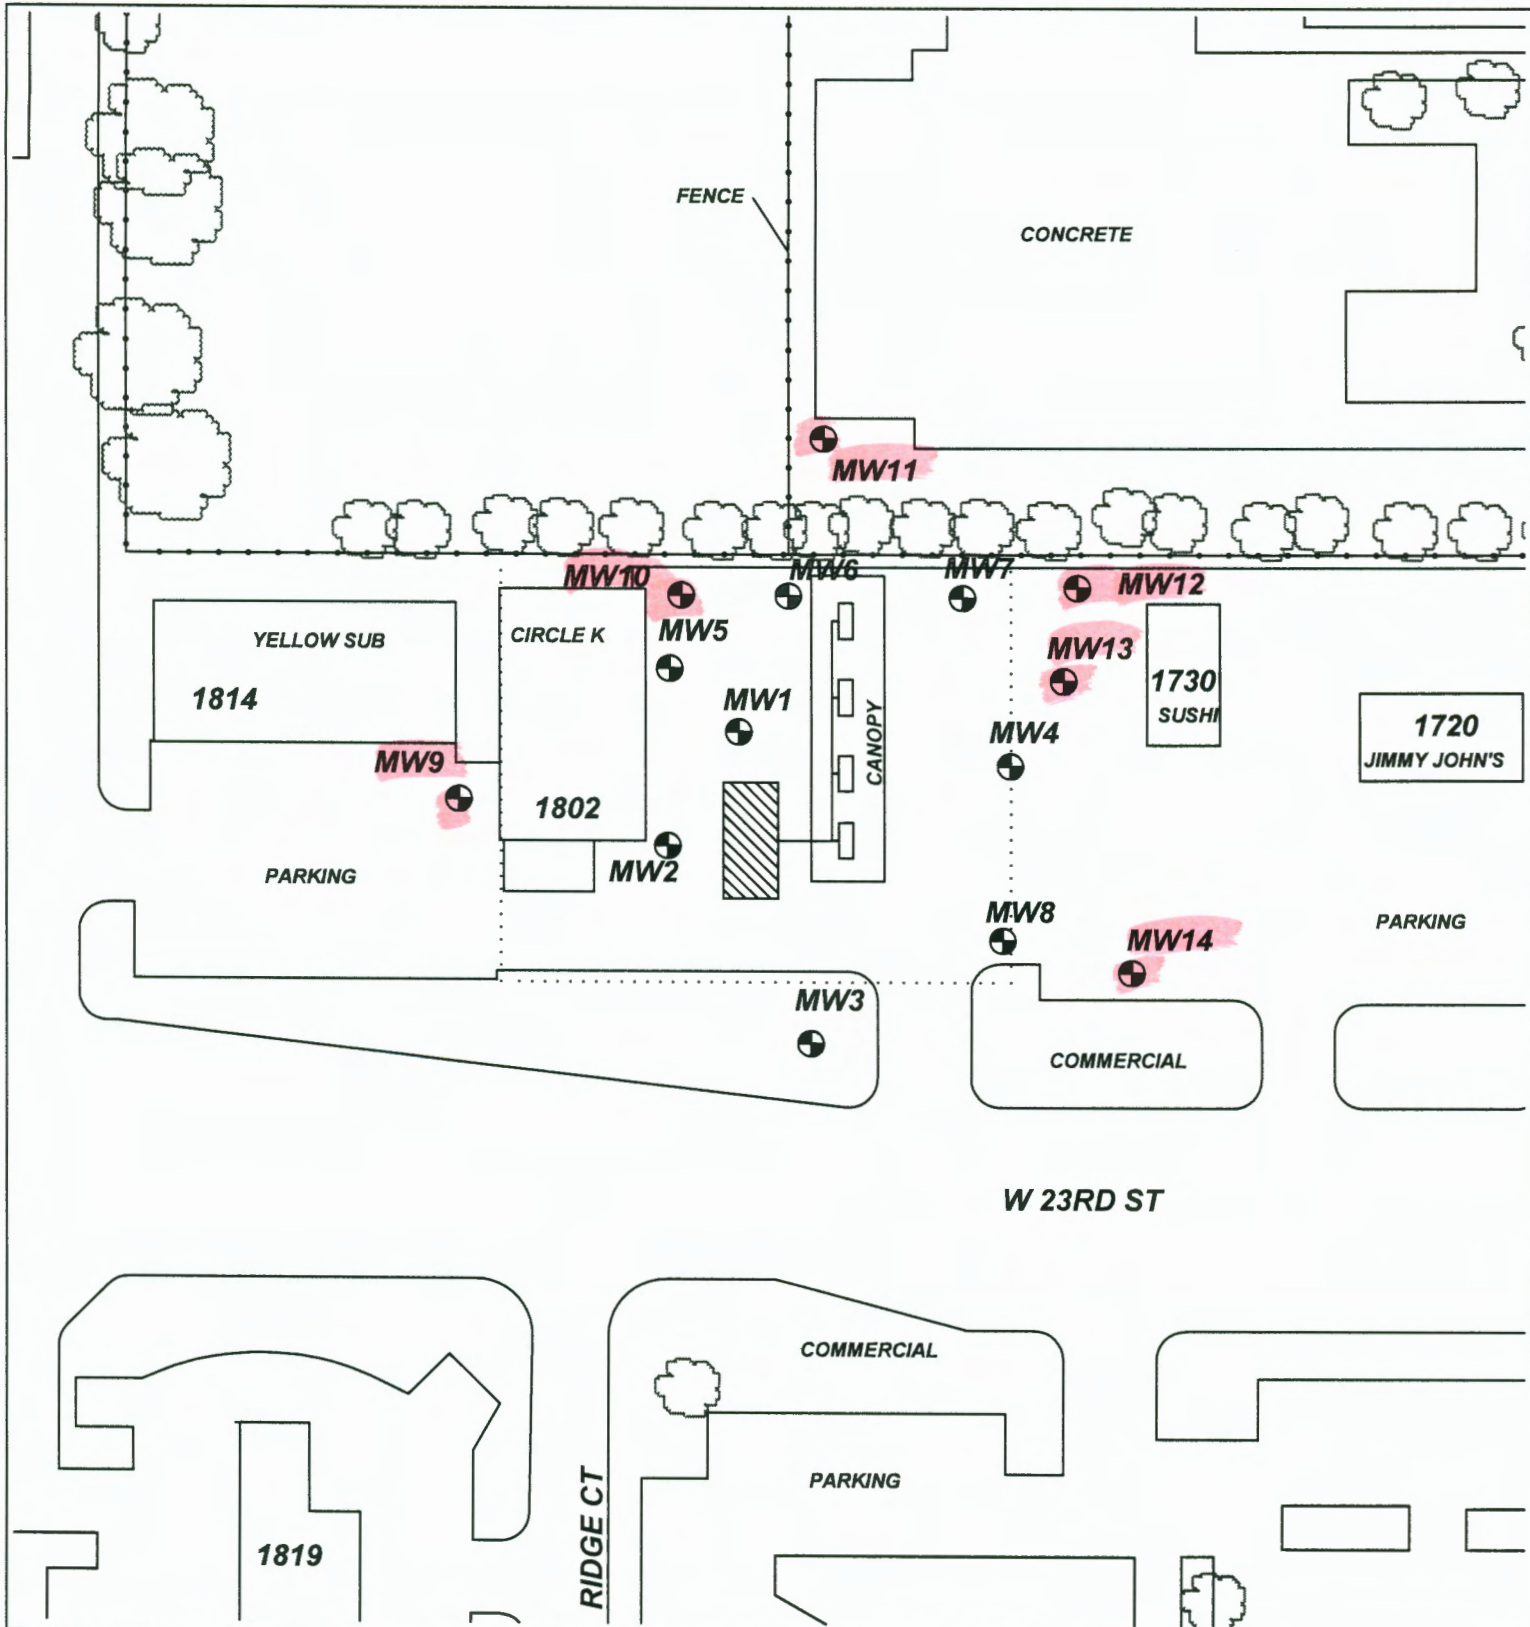
**Form WWC-5**




☒ Original Record    ☐ Correction    ☐ Change in Well Use

Division of Water  
Resources App. No.

Well ID MW11

[illegible]



PROJECT: <b>THE PANTRY #1628</b>		TITLE:   <b>ASSOCIATED ENVIRONMENTAL INC.</b>	LEGEND:  = EXISTING UST'S AND PUMP ISLANDS  = MONITORING WELL  ..... = SUBJECT PROPERTY
ADDRESS: <b>1802 W. 23RD ST.</b>			
LOCATION: <b>LAWRENCE, KS</b>			
DRAWN BY: <b>B. STALNAKER</b>	DATE: <b>12/3/19</b>		
REVISED BY: <b>B. STALNAKER</b>		DATE: <b>9/1/20</b>	
AEI JOB #: <b>TF524</b>		KOHE JOB #: <b>U2-023-14543</b>	
SCALE: <b>1" = 50'</b>		NOTES:	
