


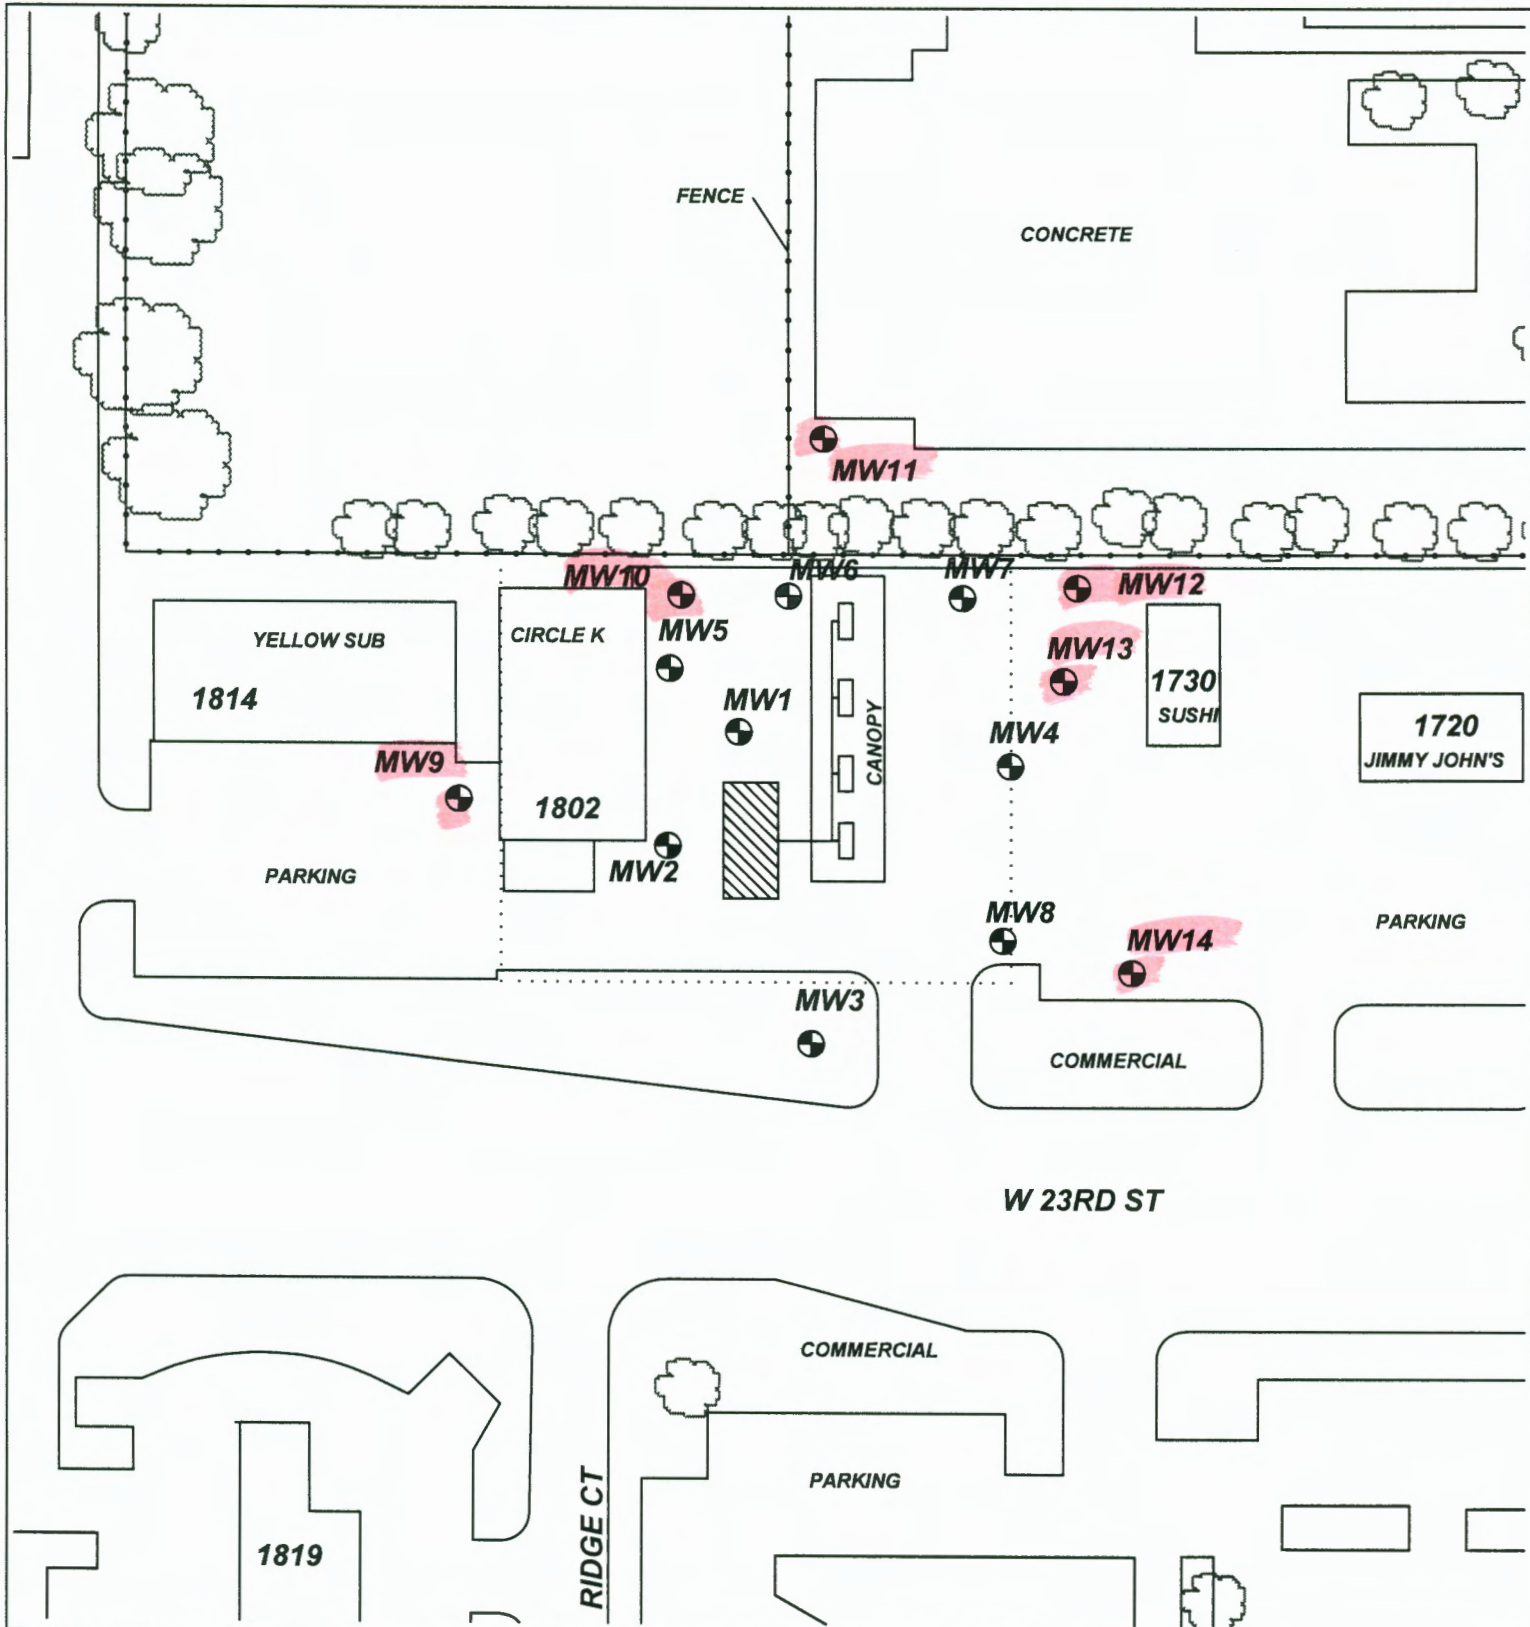


☒ Original Record ☐ Correction ☐ Change in Well Use

Well ID

MW14

Mail 1 white copy along with a fee of \$5.00 for each constructed well to: Kansas Department of Health and Environment, Bureau of Water, GWTS Section, 1000 SW Jackson St., Suite 420, Topeka, Kansas 66612-1367. Mail one to Water Well Owner and retain one for your records. Telephone 785-296-5524. Visit us at <http://www.kdheks.gov/waterwell/index.html> KSA 82a-1212 **Revised 7/10**



PROJECT: THE PANTRY #1628		TITLE:  ASSOCIATED ENVIRONMENTAL INC.	LEGEND:  = EXISTING UST'S AND PUMP ISLANDS  = MONITORING WELL = SUBJECT PROPERTY
ADDRESS: 1802 W. 23RD ST.			
LOCATION: LAWRENCE, KS			
DRAWN BY: B. STALNAKER	DATE: 12/3/19		
REVISED BY: B. STALNAKER		DATE: 9/1/20	
AEI JOB #: TF524	KOHE JOB #: U2-023-14543		
SCALE: 1" = 50'		NOTES:	
