


1 LOCATION OF WATER WELL: Fraction SW 1/4 NE 1/4 SW 1/4 Section Number 1 Township Number T 13 S Range Number R 2 **E/W**
 County: Dickinson

Distance and direction from nearest town or city street address of well if located within city?
From Abilene, Ks go to Hwy 15 & I-70 exit go West 2 3/4 miles & 3/8 mile North

2 WATER WELL OWNER: Kevin McKeeman
 RR#, St. Address, Box # : Box 763 Board of Agriculture, Division of Water Resources
 City, State, ZIP Code : Talmage, Kansas 67482 Application Number:

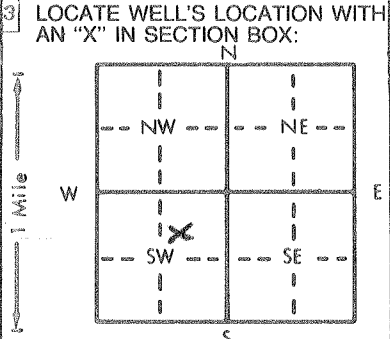

4 DEPTH OF COMPLETED WELL: 103 ft. ELEVATION:
 Depth(s) Groundwater Encountered 1. 46 ft. 2. ft. 3. ft.
 WELL'S STATIC WATER LEVEL 43 ft. below land surface measured on mo/day/yr 9 / 17 / 88
 Pump test data: Well water was ft. after hours pumping gpm
 Est. Yield 12 gpm: Well water was ft. after hours pumping gpm
 Bore Hole Diameter 9 in. to 103 ft., and in. to ft.
 WELL WATER TO BE USED AS: 5 Public water supply 8 Air conditioning 11 Injection well
 1 Domestic 3 Feedlot 6 Oil field water supply 9 Dewatering 12 Other (Specify below)
 2 Irrigation 4 Industrial 7 Lawn and garden only 10 Monitoring well
 Was a chemical/bacteriological sample submitted to Department? Yes.....No.*.....; If yes, mo/day/yr sample was submitted Water Well Disinfected? Yes * No

5 TYPE OF BLANK CASING USED:
 1 Steel 3 RMP (SR) 5 Wrought iron 8 Concrete tile CASING JOINTS: Glued * Clamped
 2 PVC 4 ABS 6 Asbestos-Cement 9 Other (specify below) Welded
 7 Fiberglass Threaded
 Blank casing diameter 5 in. to 103 ft., Dia. in. to ft., Dia. in. to ft.
 Casing height above land surface 14 in., weight 160 lbs./ft. Wall thickness or gauge No. 214
 TYPE OF SCREEN OR PERFORATION MATERIAL:
 1 Steel 3 Stainless steel 5 Fiberglass 7 PVC 10 Asbestos-cement
 2 Brass 4 Galvanized steel 6 Concrete tile 8 RMP (SR) 11 Other (specify)
 9 ABS 12 None used (open hole)
 SCREEN OR PERFORATION OPENINGS ARE:
 1 Continuous slot 3 Mill slot 5 Gauzed wrapped 8 Saw cut 11 None (open hole)
 2 Louvered shutter 4 Key punched 6 Wire wrapped 9 Drilled holes
 7 Torch cut 10 Other (specify)
 SCREEN-PERFORATED INTERVALS: From 43 ft. to 103 ft., From ft. to ft.
 From ft. to ft., From ft. to ft.
 GRAVEL PACK INTERVALS: From 25 ft. to 103 ft., From ft. to ft.
 From ft. to ft., From ft. to ft.

6 GROUT MATERIAL: 1 Neat cement 2 Cement grout 3 Bentonite 4 Other
 Grout Intervals: From 3 ft. to 25 ft., From ft. to ft., From ft. to ft.
 What is the nearest source of possible contamination:
 1 Septic tank 4 Lateral lines 7 Pit privy 10 Livestock pens 14 Abandoned water well
 2 Sewer lines 5 Cess pool 8 Sewage lagoon 11 Fuel storage 15 Oil well/Gas well
 3 Watertight sewer lines 6 Seepage pit 9 Feedyard 12 Fertilizer storage 16 Other (specify below)
 13 Insecticide storage
 Direction from well? SOUTHEAST - WILL BE How many feet? approx 300' to 350'

FROM	TO	LITHOLOGIC LOG	FROM	TO	PLUGGING INTERVALS
0	2	ROCK			
2	7	LITE COLOR CLAY & SHALE			
7	14	RED CLAY			
14	17	GRAY CLAY			
17	19	LITE COLOR CLAY			
19	20	SOFT LIMESTONE			
20	34	LITE COLOR CLAY			
34	38	LITE COLOR SHALE			
38	40	GRAY SHALE			
40	46	LIMESTONE			
46	65	DARK GRAY SHALE			
65	77	RED SHALE			
77	80	LITE COLOR CLAY			
80	81	LIMESTONE			
81	85	LITE GRAY CLAY			

7 CONTRACTOR'S OR LANDOWNER'S CERTIFICATION: This water well was (1) constructed, (2) reconstructed, or (3) plugged under my jurisdiction and was completed on (mo/day/year) 9 / 17 / 88 and this record is true to the best of my knowledge and belief. Kansas Water Well Contractor's License No. 397 This Water Well Record was completed on (mo/day/yr) 10 / 17 / 88 under the business name of CENTRAL KANSAS DRILLING by (signature) Harold D. Martin