


1 LOCATION OF WATER WELL: Fraction SW 1/4 SE 1/4 SE 1/4 Section Number 6 Township Number T 13 S Range Number R 2 (EW)

Distance and direction from nearest town or city street address of well if located within city?
1 1/2 miles West of Hwy 15 & 40 Hwy Jet & 1 mile North & 1/4 West

2 WATER WELL OWNER: Gerry Reddman
 RR#, St. Address, Box #: 6845 Southwest 61th Street Board of Agriculture, Division of Water Resources
 City, State, ZIP Code: Topeka, Kansas 66610 Application Number:

3 LOCATE WELL'S LOCATION WITH AN "X" IN SECTION BOX:

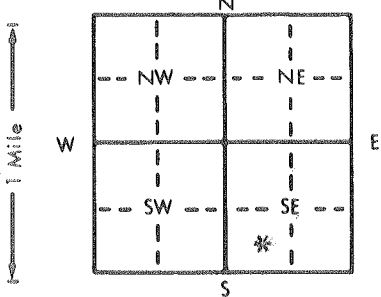

4 DEPTH OF COMPLETED WELL: 62* 63 ft. ELEVATION:

Depth(s) Groundwater Encountered 1. 37 ft. 2. 37 ft. 3. 37 ft.
 WELL'S STATIC WATER LEVEL 22 ft. below land surface measured on mo/day/yr 3 / 30 / 87
 Pump test data: Well water was 3 ft. after 30 hours pumping 87 gpm
 Est. Yield 3 gpm: Well water was 3 ft. after 30 hours pumping 87 gpm
 Bore Hole Diameter 9 in. to 63 ft., and 9 in. to 63 ft.
 WELL WATER TO BE USED AS:
 5 Public water supply 8 Air conditioning 11 Injection well
 1 Domestic 3 Feedlot 6 Oil field water supply 9 Dewatering 12 Other (Specify below)
 2 Irrigation 4 Industrial 7 Lawn and garden only 10 Observation well
 Was a chemical/bacteriological sample submitted to Department? Yes *** No ***; If yes, mo/day/yr sample was submitted
 Water Well Disinfected? Yes * No

5 TYPE OF BLANK CASING USED: 5 Wrought iron 8 Concrete tile CASING JOINTS: Glued * Clamped
 1 Steel 3 RMP (SR) 6 Asbestos-Cement 9 Other (specify below) Welded
 2 PVC 4 ABS 160# 7 Fiberglass 200# Threaded

Blank casing diameter 5 in. to 43 ft., Dia 5 in. to 63 ft., Dia 5 in. to 63 ft., Dia 5 in. to 63 ft.
 Casing height above land surface 16 in., weight 160 lbs./ft. Wall thickness or gauge No. 214

TYPE OF SCREEN OR PERFORATION MATERIAL:
 1 Steel 3 Stainless steel 5 Fiberglass 7 PVC 10 Asbestos-cement
 2 Brass 4 Galvanized steel 6 Concrete tile 8 RMP (SR) 11 Other (specify)
 9 ABS 12 None used (open hole)

SCREEN OR PERFORATION OPENINGS ARE:
 1 Continuous slot 3 Mill slot 5 Gauzed wrapped 8 Saw cut 11 None (open hole)
 2 Louvered shutter 4 Key punched 6 Wire wrapped 9 Drilled holes
 7 Torch cut 10 Other (specify)

SCREEN-PERFORATED INTERVALS: From 34 ft. to 63 ft., From 34 ft. to 63 ft., From 34 ft. to 63 ft.
 GRAVEL PACK INTERVALS: From 14 ft. to 63 ft., From 14 ft. to 63 ft., From 14 ft. to 63 ft.

6 GROUT MATERIAL: 1 Neat cement 2 Cement grout 3 Bentonite 4 Other

What is the nearest source of possible contamination:
 1 Septic tank 4 Lateral lines 7 Pit privy 10 Livestock pens 14 Abandoned water well
 2 Sewer lines 5 Cess pool 8 Sewage lagoon 11 Fuel storage 15 Oil well/Gas well
 3 Watertight sewer lines 6 Seepage pit 9 Feedyard 12 Fertilizer storage 16 Other (specify below)
 13 Insecticide storage
 Direction from well? East How many feet? 140

FROM	TO	LITHOLOGIC LOG	FROM	TO	LITHOLOGIC LOG
0	3	DARK CLAY			
3	22	LITE COLOR CLAY SHALE			
22	28	RED SHALE			
28	42	LITE COLOR SHALE			
42	47	LIMESTONE			
47	63	GRAY SHALE			

7 CONTRACTOR'S OR LANDOWNER'S CERTIFICATION: This water well was (1) constructed, (2) reconstructed, or (3) plugged under my jurisdiction and was completed on (mo/day/year) 3 / 30 / 87 and this record is true to the best of my knowledge and belief. Kansas Water Well Contractor's License No. 397 This Water Well Record was completed on (mo/day/yr) 6 / 10 / 87 under the business name of CENTRAL KANSAS DRILLING by (signature) Gerry Reddman

INSTRUCTIONS: Use typewriter or ball point pen. PLEASE PRESS FIRMLY and PRINT clearly. Please fill in blanks, underline or circle the correct answers. Send top three copies to Kansas Department of Health and Environment, Bureau of Water Protection, Topeka, Kansas 66620-7320, Telephone: 913-862-9360. Send one to WATER WELL OWNER and retain one for your records.