


1 LOCATION OF WATER WELL: Fraction SW 1/4 SE 1/4 SE 1/4 Section Number 6 Township Number T 13 S Range Number R 2 E
 County: Dickinson
 Distance and direction from nearest town or city street address of well if located within city?

1 1/2 miles West of Hwy 15 & 40 Hwy Jct & 1 mile North & 1/4 West

2 WATER WELL OWNER: Gerry Reddman Board of Agriculture, Division of Water Resource
 RR#, St. Address, Box #: 6845 Southwest 61th Street Application Number:
 City, State, ZIP Code: Topeka, Kansas 66610

3 LOCATE WELL'S LOCATION WITH AN "X" IN SECTION BOX:

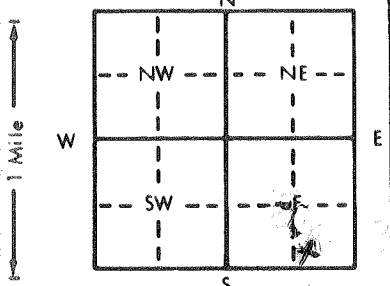

4 DEPTH OF COMPLETED WELL: 87 ft. ELEVATION:
 Depth(s) Groundwater Encountered 1. 53 ft. 2. 53 ft. 3. 53 ft.
 WELL'S STATIC WATER LEVEL: 49 ft. below land surface measured on 3 / 28 / 87
 Pump test data: Well water was ft. after hours pumping gpm
 Est. Yield 6 - 7 gpm: Well water was ft. after hours pumping gpm
 Bore Hole Diameter 9 in. to 87 ft., and in. to ft.
 WELL WATER TO BE USED AS: 5 Public water supply 8 Air conditioning 11 Injection well
 1 Domestic 3 Feedlot 6 Oil field water supply 9 Dewatering 12 Other (Specify below)
 2 Irrigation 4 Industrial 7 Lawn and garden only 10 Observation well
 Was a chemical/bacteriological sample submitted to Department? Yes No ; If yes, mo/day/yr sample was submitted
 Water Well Disinfected? Yes No

5 TYPE OF BLANK CASING USED:
 1 Steel 3 RMP (SR) 5 Wrought iron 8 Concrete tile CASING JOINTS: Glued Clamped
 2 PVC 4 ABS 160# 6 Asbestos-Cement 9 Other (specify below) Welded
 7 Fiberglass 200# Threaded
 Blank casing diameter 5 in. to 67 ft., Dia. 5 in. to 67 ft., Dia. in. to ft.
 Casing height above land surface 16 in., weight 160# & 200# lbs./ft. Wall thickness or gauge No. 214

TYPE OF SCREEN OR PERFORATION MATERIAL:
 1 Steel 3 Stainless steel 5 Fiberglass 8 RMP (SR) 10 Asbestos-cement
 2 Brass 4 Galvanized steel 6 Concrete tile 9 ABS 11 Other (specify)
 12 None used (open hole)

SCREEN OR PERFORATION OPENINGS ARE:
 1 Continuous slot 3 Mill slot 5 Gauzed wrapped 8 Saw cut 11 None (open hole)
 2 Louvered shutter 4 Key punched 6 Wire wrapped 9 Drilled holes
 7 Torch cut 10 Other (specify)

SCREEN-PERFORATED INTERVALS: From 47 ft. to 87 ft., From ft. to ft.
 GRAVEL PACK INTERVALS: From 14 ft. to 87 ft., From ft. to ft.

6 GROUT MATERIAL: 1 Neat cement 2 Cement grout 3 Bentonite 4 Other
 Grout Intervals: From 14 ft. to 14 ft., From ft. to ft., From ft. to ft.

What is the nearest source of possible contamination:
 1 Septic tank 4 Lateral lines 7 Pit privy 10 Livestock pens 14 Abandoned water well
 2 Sewer lines 5 Cess pool 8 Sewage lagoon 11 Fuel storage 15 Oil well/Gas well
 3 Watertight sewer lines 6 Seepage pit 9 Feedyard 12 Fertilizer storage 16 Other (specify below)
 13 Insecticide storage
 Direction from well? South How many feet? 120

FROM	TO	LITHOLOGIC LOG	FROM	TO	LITHOLOGIC LOG
0	4 1/2	SANDY CLAY			
4 1/2	6 1/2	QUARTZ			
6 1/2	8	LITE COLOR SHALE			
8	11	LIMESTONE			
11	22	LITE COLOR SHALE			
22	24	RED SHALE			
24	40	LITE COLOR SHALE			
40	42	LIMESTONE			
42	51	LITE COLOR SHALE			
51	57	LIMESTONE			
57	66	GRAY SHALE			
66	68	HARD DARK LIMESTONE			
68	72	GRAY SHALE			
72	85	RED SHALE			
85	87	GYPSON ROCK			

7 CONTRACTOR'S OR LANDOWNER'S CERTIFICATION: This water well was (1) constructed, (2) reconstructed, or (3) plugged under my jurisdiction and was completed on (mo/day/year) 3 / 28 / 87 and this record is true to the best of my knowledge and belief. Kansas Water Well Contractor's License No. 397. This Water Well Record was completed on (mo/day/yr) 6 / 10 / 87
 under the business name of CENTRAL KANSAS DRILLING by (signature) Arnold D. Mait...

INSTRUCTIONS: Use typewriter or ball point pen. PLEASE PRESS FIRMLY and PRINT clearly. Please fill in blanks, underline or circle the correct answers. Send top three copies to Kansas Department of Health and Environment, Office of Oil Field and Environmental Geology, Regulation and Permitting Section, Topeka, Kansas 66620-7500, Telephone: 913-862-9360. Send one to WATER WELL OWNER and retain one for your records.